



1031249

IN ALL CASES PLOT THE INTENDED WELL ON THE PLAT BELOW

Plat of acreage attributable to a well in a prorated or spaced field

If the intended well is in a prorated or spaced field, please fully complete this side of the form. If the intended well is in a prorated or spaced field complete the plat below showing that the well will be properly located in relationship to other wells producing from the common source of supply. Please show all the wells and within 1 mile of the boundaries of the proposed acreage attribution unit for gas wells and within 1/2 mile of the boundaries of the proposed acreage attribution unit for oil wells.

API No. 15 - _____

Operator: _____

Lease: _____

Well Number: _____

Field: _____

Number of Acres attributable to well: _____

QTR/QTR/QTR/QTR of acreage: _____ - _____ - _____ - _____

Location of Well: County: _____

_____ feet from N / S Line of Section

_____ feet from E / W Line of Section

Sec. _____ Twp. _____ S. R. _____ E W

Is Section: Regular or Irregular


If Section is Irregular, locate well from nearest corner boundary.

Section corner used: NE NW SE SW

PLAT

(Show location of the well and shade attributable acreage for prorated or spaced wells.)

(Show footage to the nearest lease or unit boundary line.)

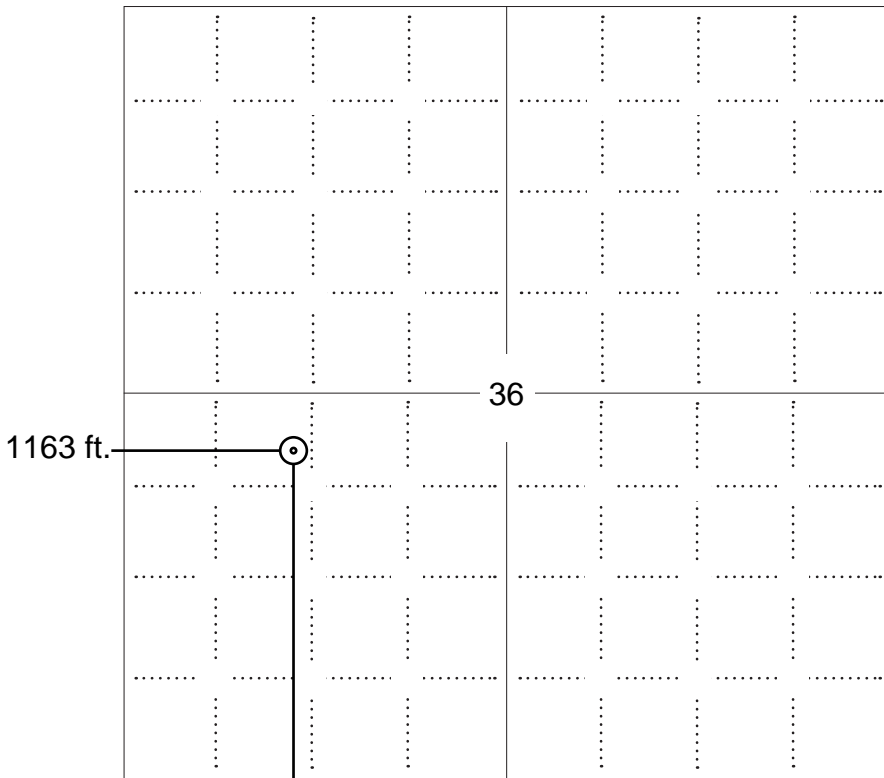

NOTE: In all cases locate the spot of the proposed drilling locaton.

2242 ft.

In plotting the proposed location of the well, you must show:

1. The manner in which you are using the depicted plat by identifying section lines, i.e. 1 section, 1 section with 8 surrounding sections, 4 sections, etc.
2. The distance of the proposed drilling location from the south / north and east / west outside section lines.
3. The distance to the nearest lease or unit boundary line (in footage).
4. If proposed location is located within a prorated or spaced field a certificate of acreage attribution plat must be attached: (C0-7 for oil wells; CG-8 for gas wells).





KANSAS CORPORATION COMMISSION 1031249
OIL & GAS CONSERVATION DIVISION

Form CDP-1
April 2004
Form must be Typed

APPLICATION FOR SURFACE PIT

Submit in Duplicate

Operator Name: _____		License Number: _____	
Operator Address: _____			
Contact Person: _____		Phone Number: _____	
Lease Name & Well No.: _____		Pit Location (QQQQ): _____ - _____ - _____ - _____	
Type of Pit: <input type="checkbox"/> Emergency Pit <input type="checkbox"/> Burn Pit <input type="checkbox"/> Settling Pit <input type="checkbox"/> Drilling Pit <input type="checkbox"/> Workover Pit <input type="checkbox"/> Haul-Off Pit <i>(If WP Supply API No. or Year Drilled)</i>		Pit is: <input type="checkbox"/> Proposed <input type="checkbox"/> Existing If Existing, date constructed: _____ Pit capacity: _____ (bbls)	
Is the pit located in a Sensitive Ground Water Area? <input type="checkbox"/> Yes <input type="checkbox"/> No		Chloride concentration: _____ mg/l <i>(For Emergency Pits and Settling Pits only)</i>	
Is the bottom below ground level? <input type="checkbox"/> Yes <input type="checkbox"/> No		Artificial Liner? <input type="checkbox"/> Yes <input type="checkbox"/> No	
How is the pit lined if a plastic liner is not used?		_____	
Pit dimensions (all but working pits): _____ Length (feet) _____ Width (feet) _____ N/A: Steel Pits Depth from ground level to deepest point: _____ (feet) _____ No Pit			
If the pit is lined give a brief description of the liner material, thickness and installation procedure.		Describe procedures for periodic maintenance and determining liner integrity, including any special monitoring.	
Distance to nearest water well within one-mile of pit _____ feet Depth of water well _____ feet		Depth to shallowest fresh water _____ feet. Source of information: _____ measured _____ well owner _____ electric log _____ KDWR	
Emergency, Settling and Burn Pits ONLY: Producing Formation: _____ Number of producing wells on lease: _____ Barrels of fluid produced daily: _____ Does the slope from the tank battery allow all spilled fluids to flow into the pit? <input type="checkbox"/> Yes <input type="checkbox"/> No		Drilling, Workover and Haul-Off Pits ONLY: Type of material utilized in drilling/workover: _____ Number of working pits to be utilized: _____ Abandonment procedure: _____ _____ Drill pits must be closed within 365 days of spud date.	
Submitted Electronically			

KCC OFFICE USE ONLY		Steel Pit	RFAC	RFAS
Date Received: _____	Permit Number: _____	Permit Date: _____	Lease Inspection: <input type="checkbox"/> Yes <input type="checkbox"/> No	



ROBINSON SERVICES

Oil Field & Construction Staking

P.O. Box 2324

Garden City, Kansas 67846

Office/Fax: (620) 276-6159

Cell: (620) 272-1499



F091309-B
PLAT NO.

8369
INVOICE NO.

Berexco, Inc.

OPERATOR

Finney County, KS

COUNTY

36 26s 33w
Sec. Twp. Rng.

Standley "B" #1-36

LEASE NAME

2242' FSL - 1163' FWL

LOCATION SPOT

SCALE: **1" = 1000'**

DATE: **Sept. 11th, 2009**

MEASURED BY: **Harris S.**

DRAWN BY: **Harris S.**

AUTHORIZED BY: **Evan, Robert & Greg**




GR. ELEVATION: **2916.5'**

Directions: From approx. 1 mile West of Sublette, Ks at the intersection of Hwy 83 & Hwy 56 - Now go 18.1 miles North on Hwy 83 - Now go 1 mile West on E Haskell County Line RD to the SW corner of section 36-26s-33w - Now go 0.5 mile North on West Fork Rd to ingress stake East into - Now go 0.2 mile or approx. 1163' East on trail to ingress stake South into - Now go approx. 400' South through irrigated 8' corn into staked location.

Final ingress must be verified with land owner or Berexco Inc.

***This drawing does not constitute a monumented survey or a land survey plat
This drawing is for construction purposes only***

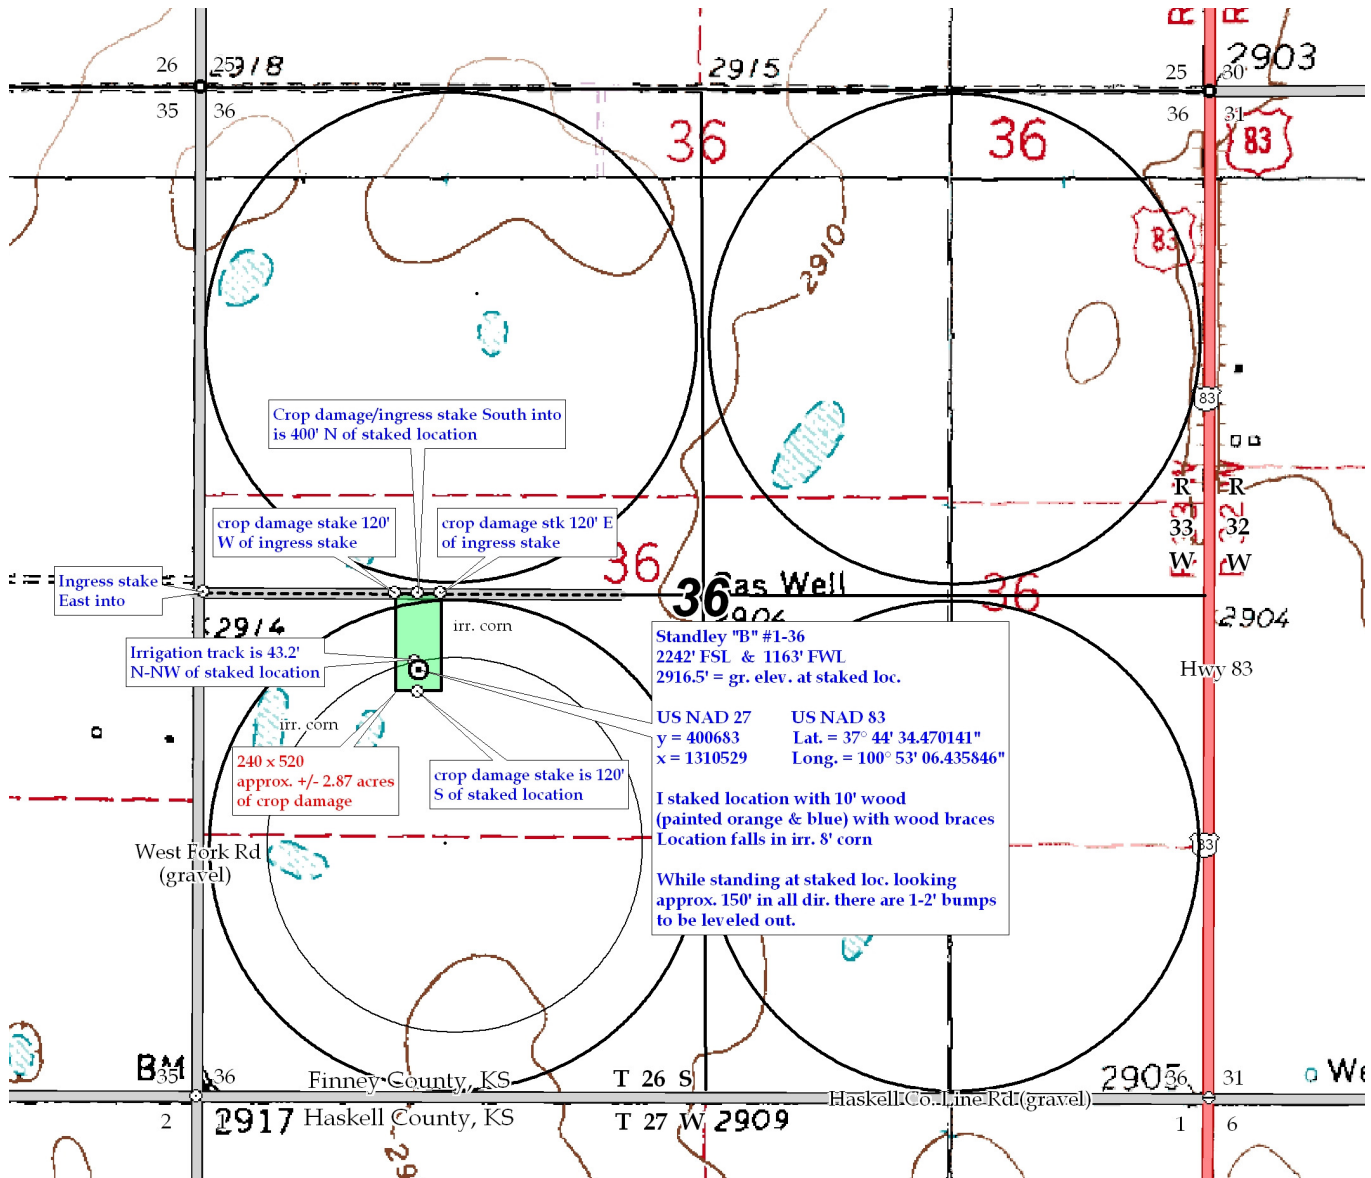



ROBINSON SERVICES


Oil Field & Construction Staking

P.O. Box 2324

Garden City, Kansas 67846

Office/Fax: (620) 276-6159

Cell: (620) 272-1499

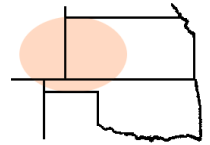

F091309-B
PLAT NO.

8369
INVOICE NO.

Berexco, Inc.

OPERATOR

Standley "B" #1-36

LEASE NAME

Finney County, KS

COUNTY

36

Sec.

26s

Twp.

33w

Rng.

2242' FSL - 1163' FWL

LOCATION SPOT

SCALE: 1" = 1000'

DATE: Sept. 11th, 2009

MEASURED BY: Harris S.

DRAWN BY: Harris S.

AUTHORIZED BY: Evan, Robert & Greg



GR. ELEVATION: 2916.5'

Directions: From approx. 1 mile West of Sublette, Ks at the intersection of Hwy 83 & Hwy 56 - Now go 18.1 miles North on Hwy 83 - Now go 1 mile West on E Haskell County Line RD to the SW corner of section 36-26s-33w - Now go 0.5 mile North on West Fork Rd to ingress stake East into - Now go 0.2 mile or approx. 1163' East on trail to ingress stake South into - Now go approx. 400' South through irrigated 8' corn into staked location.

Final ingress must be verified with land owner or Berexco Inc.

This drawing does not constitute a monumented survey or a land survey plat
This drawing is for construction purposes only

