

Section 1
34S 20W

Section 6
34S 19W

ARIANA 3419 1-7H CLAY 3419 1-6H



ANITA 3420 1-12H



ANITA 3420 2-12H



~~Miss Entry: 5382'~~
~~99.431479 37.104849~~

Top Perf: 5512'
-99.431507 37.10457

Section 12
34S 20W

Section 7
34S 19W

Bottom Perf: 9724'
-99.431127 37.092923

BHL: 10165'
-99.43106 37.091817

704' FWL 340' FSL

Section 13
34S 20W

Section 18
34S 19W




● Actual BH Location

* SandRidge Wells

--- Perf

□ Sections

Actual Bottom-Hole Location of Ariana 3419 1-7H
Comanche County, Kansas
T&R: 34S 20W
Section: 7, 704' FWL & 340' FSL
Long/Lat:-99.43106 37.091817
1 in = 833 ft

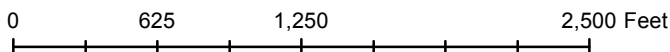

Draftsman:

Aaron Birk

Draft Date: 7/24/2013

Drawing Name/Number:

Addendum_Ariana 3419 1-7H.mxd

Coordinate System:

NAD 1927 State Plane
Kansas South FIPS: 1502