


G:\Regional\JOBS\2018\31 TULSA - 2018\340311058 KINDER MORGAN - (2) 10X250 DAGB - AMA 407 - AGENDA, KS\DRAWINGS\340311058-01.dwg LAYOUT: Model

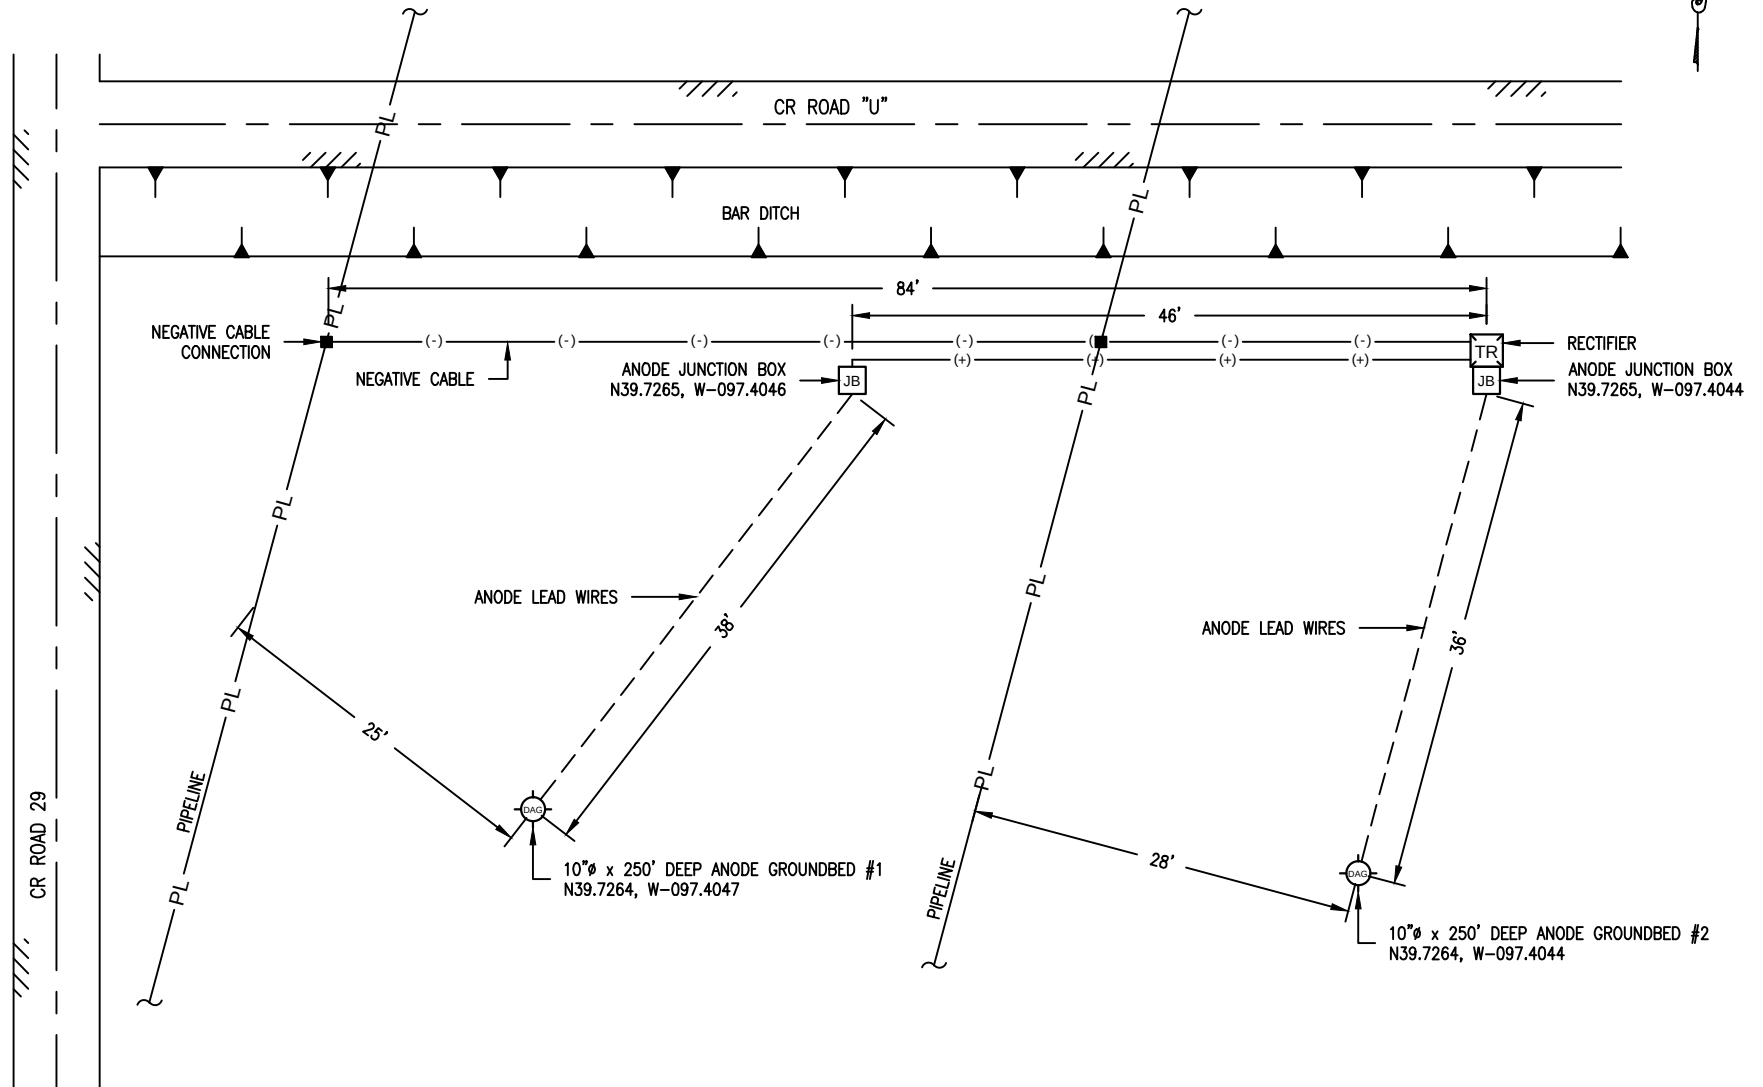

REVISED			REVISIONS			REV.	CHK.	APP.
NO.	DATE							
1	3/5/18	AS BUILT				FM	AM	
2								
3								
4								

NOTICE:
THIS DOCUMENT IS THE PROPERTY OF CORRPRO COMPANIES, INC. NEITHER THIS DOCUMENT NOR ANY DATA OR INFORMATION HEREIN SHALL BE COPIED OR REPRODUCED IN ANY MANNER, LOANED OR OTHERWISE DISPOSED OF, OR USED FOR ANY PURPOSE WHATSOEVER, WITHOUT THE PRIOR WRITTEN PERMISSION OF CORRPRO COMPANIES, INC. IF THIS DOCUMENT IS LOANED BY OR WITH THE AUTHORITY OF CORRPRO COMPANIES, INC. THE BORROWER, IN CONSIDERATION OF SUCH LOAN, AGREES TO THE FORGOING CONDITIONS BY OTHER THAN THE INTENDED USER.

corrpro
An Aegion Company

DRAWN BY	FMoreno
DESIGNED BY	JCampbell
DATE	3-5-18
SCALE	N.T.S.
JOB NO.	340311058
DWG. NO.	340311058-01

KINDER MORGAN
CATHODIC PROTECTION SYSTEM
DEEP ANODE GROUND BEDS INSTALLATION
AMA 407
AGENDA, KS