


| MATERIAL LIST | | |
|--|----------|------|
| MATERIAL | QUANTITY | UNIT |
| ANOTEC 3884Z ANODES WITH INDIVIDUAL #8 HALAR LEADS | 20 | EA |
| DEEPWELL (37.252189, -100.653563) | 1 | EA |
| 50V-50A RECTIFIER (37.252268, -100.653489) | 1 | EA |
| 20 CIRCUIT GALVANIZED JUNCTION BOX (37.252268,-100.653489) | 1 | EA |
| LORESCO SC-3 (50# BAG) | 100 | EA |
| BENTONITE HOLE PLUG (50# BAG) | 90 | EA |



| REVISIONS | | | | | |
|-----------|-------------|-----------|------|-----------|------|
| No. | Description | Drawn By: | Date | Chk'd By: | Date |
| | | | | | |
| | | | | | |
| | | | | | |
| | | | | | |

| | | |
|---------------------|-------------|---------|
| Location: KS | Drawn by: | Date: |
| | SEM | 4/16/19 |
| | Checked by: | Date: |
| | JC | 4/16/19 |

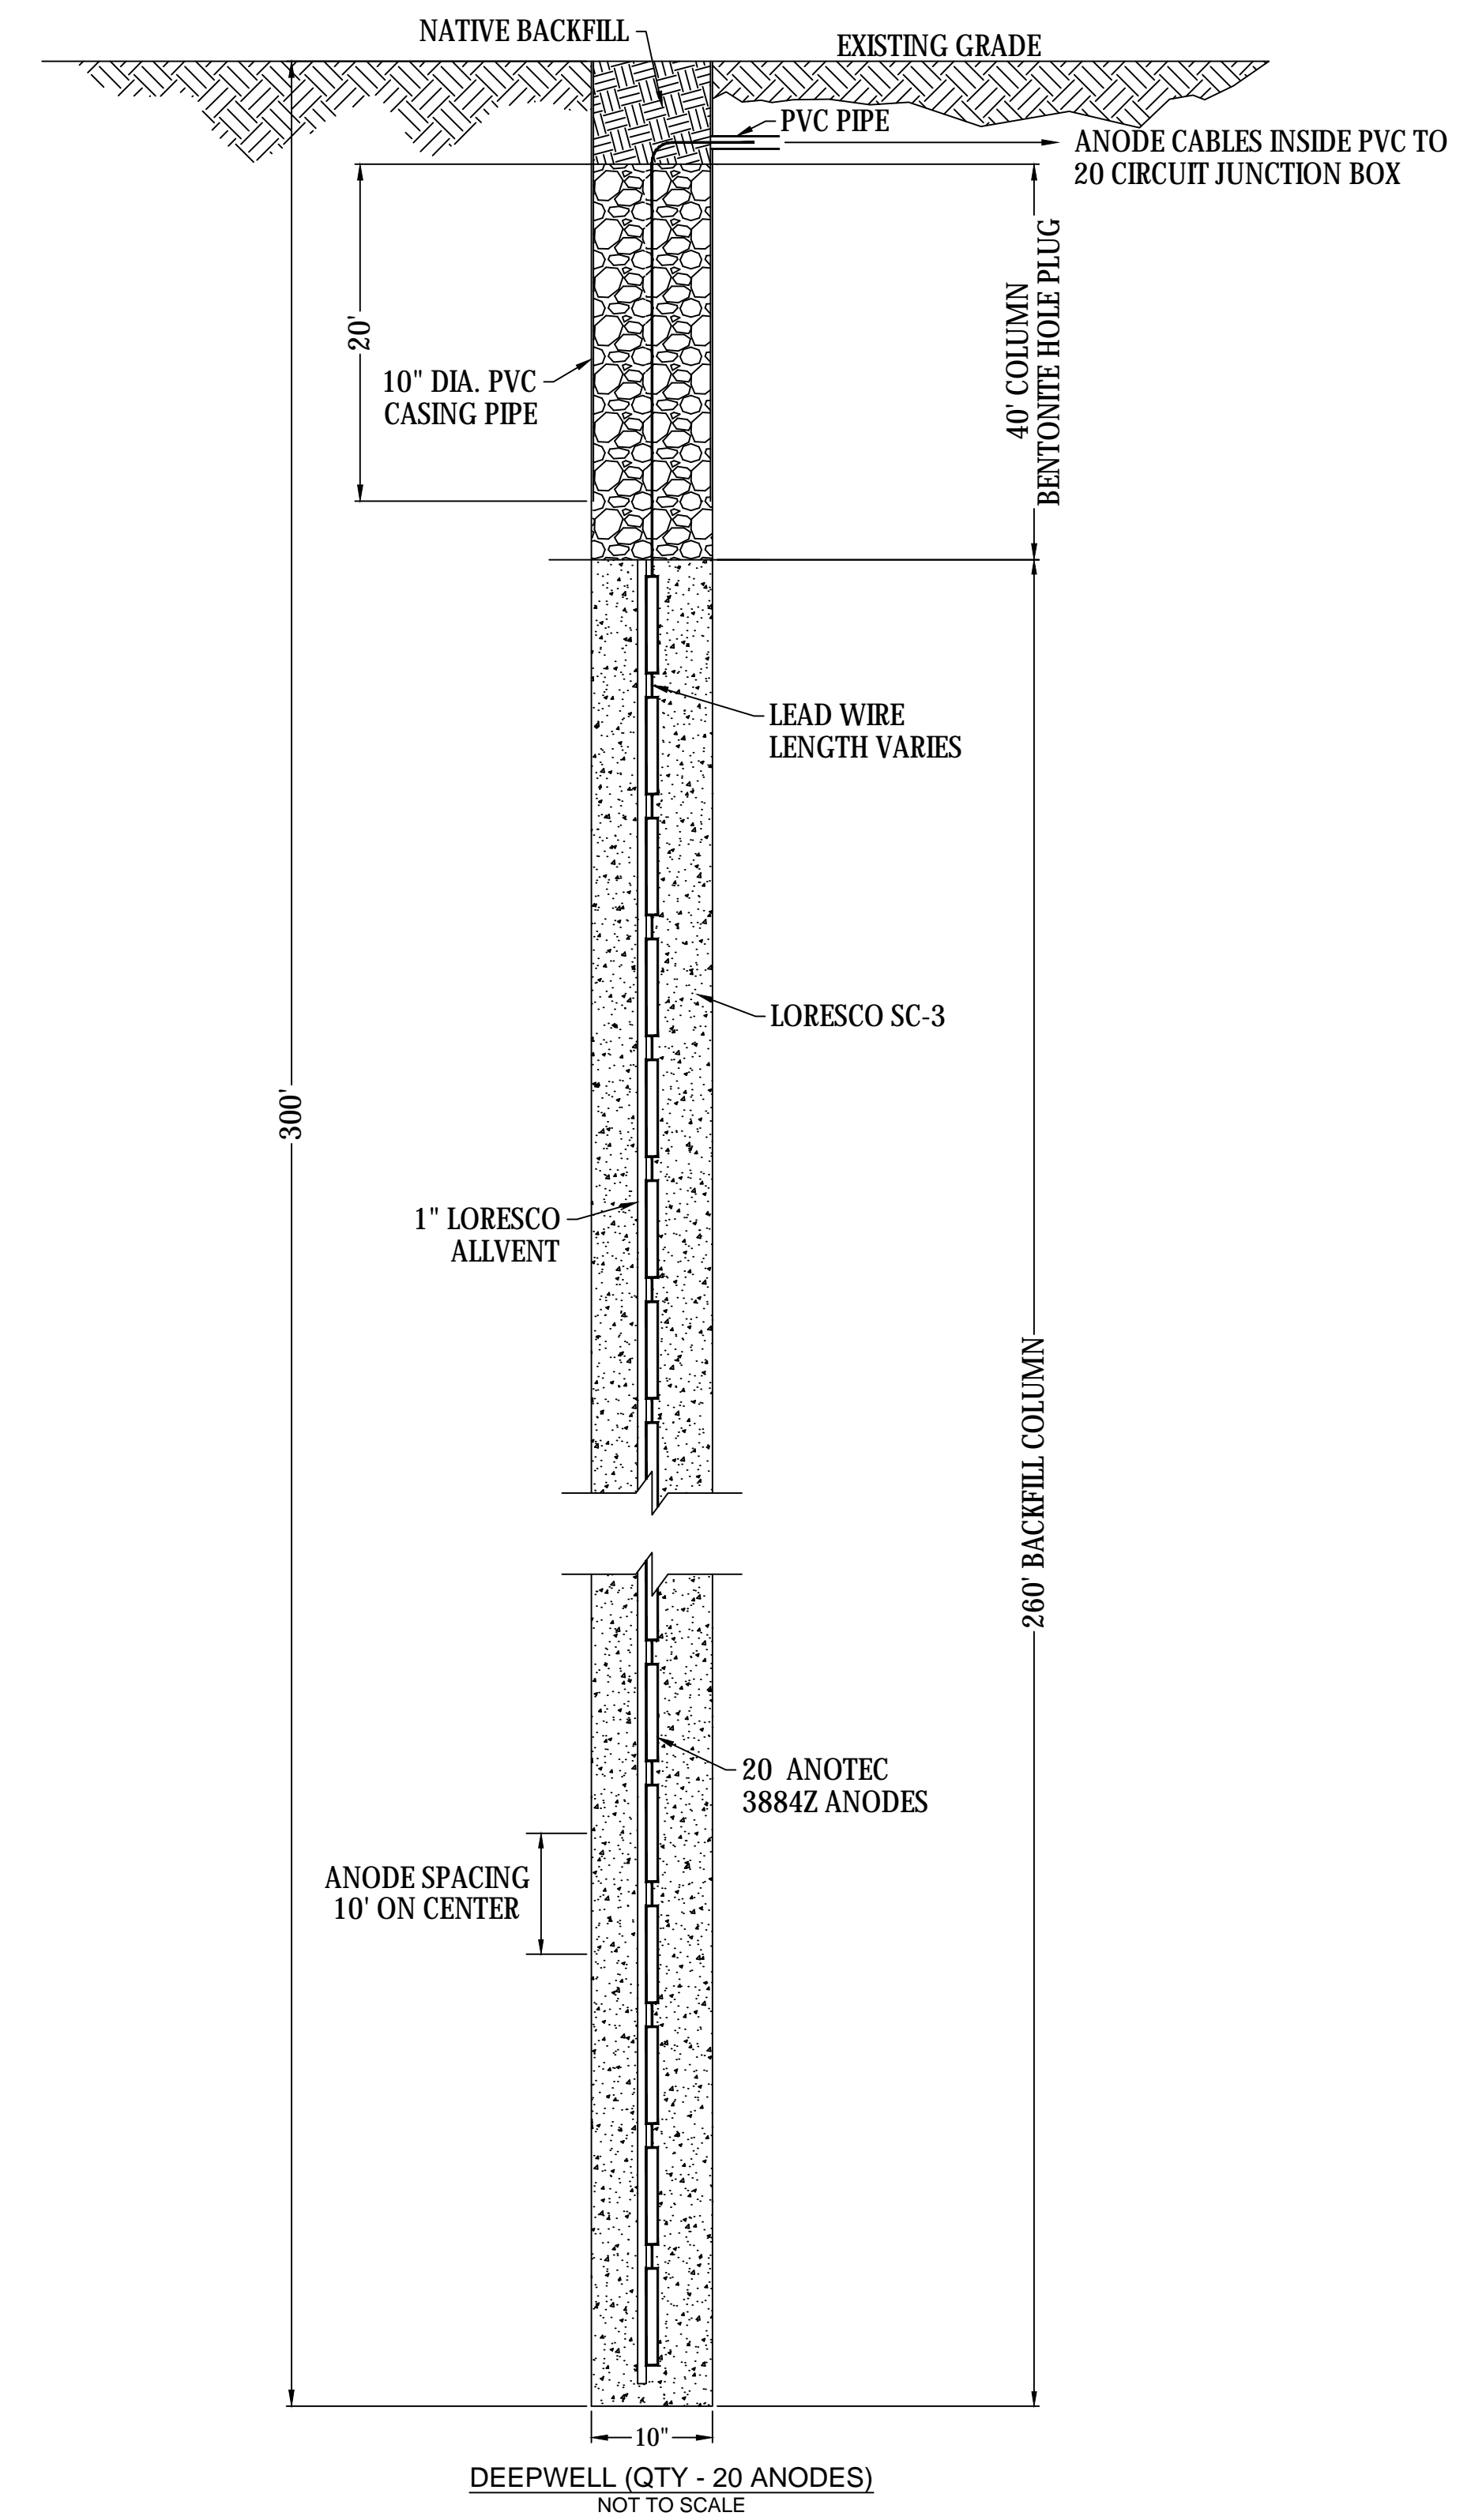

| | | |
|---|-----------|--|
| LIBERAL 8.7 DEEPWELL | | |
| PANHANDLE EASTERN PIPELINE COMPANY | | |
| GROUND BED ANODES AS-BUILT | | |
| Work Order No: | Revision: | |
| 190282- 000 | 1 | |