KOLAR Document ID: 1566215

Confidentiality Requested:

Yes No

KANSAS CORPORATION COMMISSION OIL & GAS CONSERVATION DIVISION

Form ACO-1
January 2018
Form must be Typed
Form must be Signed
All blanks must be Filled

WELL COMPLETION FORM WELL HISTORY - DESCRIPTION OF WELL & LEASE

OPERATOR: License #	API No.:
Name:	Spot Description:
Address 1:	
Address 2:	Feet from North / South Line of Section
City:	Feet from
Contact Person:	Footages Calculated from Nearest Outside Section Corner:
Phone: ()	□NE □NW □SE □SW
CONTRACTOR: License #	GPS Location: Lat:, Long:
Name:	(e.g. xx.xxxxx) (e.gxxx.xxxxxx)
Wellsite Geologist:	Datum: NAD27 NAD83 WGS84
Purchaser:	County:
Designate Type of Completion:	Lease Name: Well #:
New Well Re-Entry Workover	Field Name:
	Producing Formation:
☐ Oil ☐ WSW ☐ SWD	Elevation: Ground: Kelly Bushing:
☐ Gas ☐ DH ☐ EOR	Total Vertical Depth: Plug Back Total Depth:
☐ OG ☐ GSW	Amount of Surface Pipe Set and Cemented at: Feet
Controlling Charge Controlling	Multiple Stage Cementing Collar Used? Yes No
Cathodic Other (Core, Expl., etc.):	
If Workover/Re-entry: Old Well Info as follows:	If yes, show depth set: Feet
Operator:	If Alternate II completion, cement circulated from:
Well Name:	feet depth to:w/sx cmt.
Original Comp. Date: Original Total Depth:	
☐ Deepening ☐ Re-perf. ☐ Conv. to EOR ☐ Conv. to SWD	Drilling Fluid Management Plan
☐ Plug Back ☐ Liner ☐ Conv. to GSW ☐ Conv. to Producer	(Data must be collected from the Reserve Pit)
Commission of the Commission o	Chloride content:ppm Fluid volume: bbls
☐ Commingled Permit #: ☐ Dual Completion Permit #:	Dewatering method used:
SWD Permit #:	Location of fluid disposal if hould offsite:
□ EOR Permit #:	Location of fluid disposal if hauled offsite:
GSW Permit #:	Operator Name:
	Lease Name: License #:
Spud Date or Date Reached TD Completion Date or	Quarter Sec TwpS. R
Recompletion Date Recompletion Date Recompletion Date	Countv: Permit #:

AFFIDAVIT

I am the affiant and I hereby certify that all requirements of the statutes, rules and regulations promulgated to regulate the oil and gas industry have been fully complied with and the statements herein are complete and correct to the best of my knowledge.

Submitted Electronically

KCC Office Use ONLY				
Confidentiality Requested				
Date:				
Confidential Release Date:				
Wireline Log Received Drill Stem Tests Received				
Geologist Report / Mud Logs Received				
UIC Distribution				
ALT I II Approved by: Date:				

KOLAR Document ID: 1566215

Page Two

Operator Name:				Lease Name:			Well #:	
Sec Twp.	S. R.	Ea	st West	County:				
	lowing and shu	ıt-in pressures, w	hether shut-in pre	ssure reached st	atic level, hydrosta	tic pressures, bot		val tested, time tool erature, fluid recovery,
Final Radioactivity files must be subm						iled to kcc-well-lo	gs@kcc.ks.gov	v. Digital electronic log
Drill Stem Tests Ta			Yes No			on (Top), Depth ar		Sample
Samples Sent to G	eological Surv	ey	Yes No	Na	me		Тор	Datum
Cores Taken Electric Log Run Geologist Report / List All E. Logs Ru	_		Yes No Yes No Yes No					
		Re			New Used	ion, etc.		
Purpose of Strin		Hole	Size Casing Set (In O.D.)	Weight Lbs. / Ft.	Setting Depth	Type of Cement	# Sacks Used	Type and Percent Additives
			ADDITIONAL	CEMENTING / SO	QUEEZE RECORD	l		
Purpose:		epth Ty Bottom	pe of Cement	# Sacks Used	Type and Percent Additives			
Protect Casii								
Plug Off Zon								
 Did you perform a Does the volume o Was the hydraulic 	of the total base f	luid of the hydraulic	fracturing treatment	_	_	No (If No, sk	ip questions 2 an ip question 3) out Page Three	,
Date of first Producti Injection:	on/Injection or Re	esumed Production	/ Producing Meth	nod:	Gas Lift 0	Other <i>(Explain)</i>		
Estimated Production Oil Bbls. Per 24 Hours							Gas-Oil Ratio	Gravity
DISPOS	SITION OF GAS:		N	METHOD OF COMP	LETION:			ON INTERVAL:
	_	on Lease	Open Hole			mmingled mit ACO-4)	Тор	Bottom
,	Submit ACO-18.)							
Shots Per Foot	Perforation Top	Perforation Bottom	Bridge Plug Type	Bridge Plug Set At	Acid,	Fracture, Shot, Cer (Amount and Kind	menting Squeeze I of Material Used)	Record
TUBING RECORD:	Size:	Set /	At:	Packer At:				
. 5513 1200 10.	5120.		···	. 30.0.71				


Form	ACO1 - Well Completion
Operator	Pan Gas Storage, LLC dba Southwest Gas Storage Company
Well Name	LIB 24.5 1
Doc ID	1566215

Casing

Purpose Of String	Size Hole Drilled	Size Casing Set	Weight	_	Type Of Cement		Type and Percent Additives
Surface	16	10	11.05	20	Bentonite	54	0

MATERIAL LIST

MATERIAL	QUANTITY	UNIT
ANOTEC 3884Z CAST IRON ANODES W/ #8 HALAR LEADS	20	EA
DEEPWELL (37.354997, -100.399104)	1	EA
RECTIFIER (37.355040, -100.399035)	1	EA
20 CIRCUIT JUNCTION BOX (37.355040, -100.399035)	1	EA
LORESCO SC-3 (50# BAG)	186	EA
BENTONITE PLUG(50# BAG)	54	EA

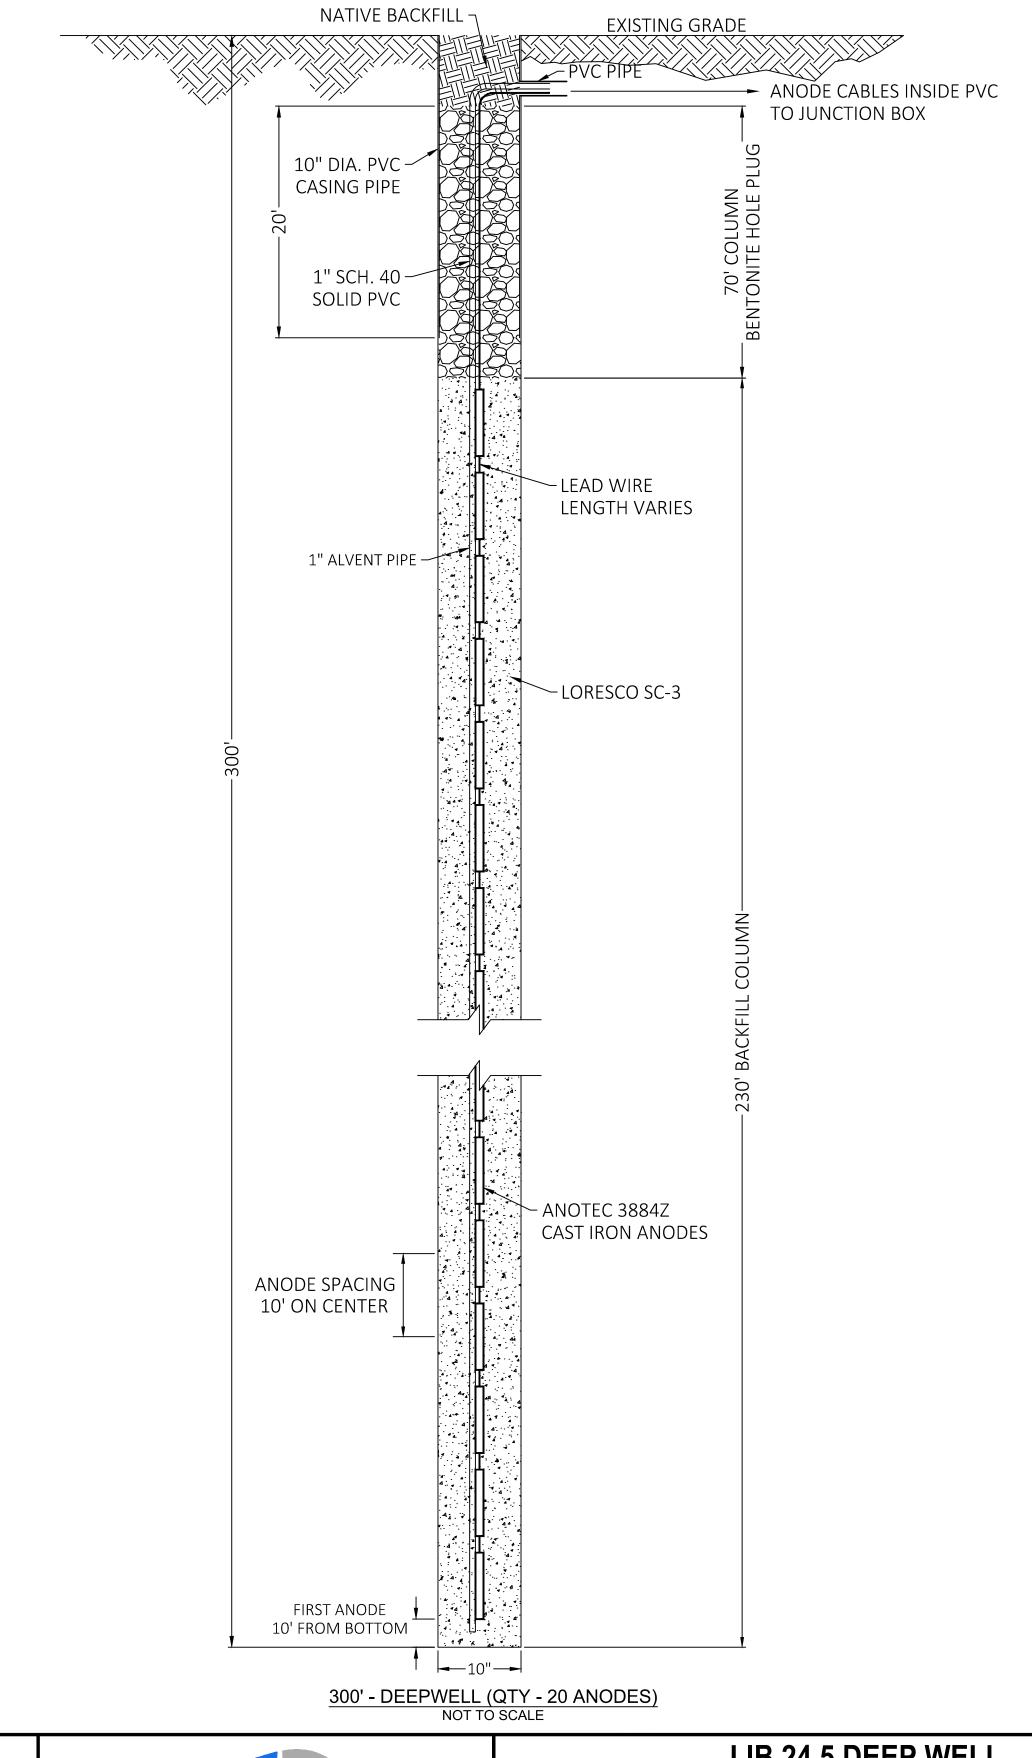

 No.
 Description
 Drawn By:
 Date
 Chk'd By:
 Date
 Location:
 Drawn by:
 Date:

 K
 Drawn By:
 Drawn By:
 Date:
 Chk'd By:
 Date:
 TECH
 11/2020

 Checked by:
 Drawn By:
 Drawn By:
 Drawn By:
 Date:

 Checked by:
 Drawn By:
 Drawn By:
 Drawn By:
 Date:

 Checked by:
 Drawn By:
 Drawn By:
 Drawn By:
 Date:

 Checked by:
 Drawn By:
 Drawn By:
 Drawn By:</td



LIB 24.5 DEEP WELL PANHANDLE EASTERN PIPE LINE CO. DEEPWELL AS-BUILT

ork Order No:
Sheet No.
2020-0118
2