

For KCC Use:

Effective Date: _____

District # _____

SGA? ☐ Yes ☐ No**KANSAS CORPORATION COMMISSION
OIL & GAS CONSERVATION DIVISION**

Form CB-1

Oct 2016

Form must be Typed**Form must be Signed****All blanks must be Filled****CATHODIC PROTECTION BOREHOLE INTENT***Must be approved by the KCC sixty (60) days prior to commencing well.***Form KSONA-1, Certification of Compliance with the Kansas Surface Owner Notification Act, MUST be submitted with this form.**Expected Spud Date: _____
month day year

OPERATOR: License# _____

Name: _____

Address 1: _____

Address 2: _____

City: _____ State: _____ Zip: _____ + _____

Contact Person: _____

Phone: _____

CONTRACTOR: License# _____

Name: _____

Type Drilling Equipment: ☐ Mud Rotary ☐ Cable☐ Air Rotary ☐ Other**Construction Features**

Length of Cathodic Surface (Non-Metallic) Casing

Planned to be set: _____ feet

Length of Conductor pipe (if any): _____ feet

Surface casing borehole size: _____ inches

Cathodic surface casing size: _____ inches

Cathodic surface casing centralizers set at depths of: _____ ; _____ ;

_____ ; _____ ; _____ ; _____ ; _____ ; _____ ; _____ ;

Cathodic surface casing will terminate at:

☐ Above surface ☐ Surface Vault ☐ Below Surface VaultPitless casing adaptor will be used: ☐ Yes ☐ No Depth _____ feet

Anode installation depths are: _____ ; _____ ; _____ ; _____ ; _____ ;

_____ ; _____ ; _____ ; _____ ; _____ ; _____ ; _____ ; _____ ;

AFFIDAVIT

The undersigned hereby affirms that the drilling, completion and eventual plugging of this well will comply with K.S.A. 55-101 et. seq.

It is agreed that the following minimum requirements will be met:

1. Notify the appropriate District office prior to spudding and again before plugging the well. An agreement between the operator and the District Office on plugs and placement is necessary prior to plugging. In all cases, notify District Office prior to any grouting.
2. Notify appropriate District Office 48 hours prior to workover or re-entry.
3. A copy of the approved notice of intent to drill shall be posted on each drilling rig.
4. The minimum amount of cathodic surface casing as specified below shall be set by grouting to the top when the cathodic surface casing is set.
5. File all required forms: a. File Drill Pit Application (form CDP-1) with Intent to Drill (form CB-1). b. File Certification of Compliance with Kansas Surface Owner Notification Act (form KSONA-1) with Cathodic Protection Borehole Intent (CB-1) c. File Completion Form (ACO-1) within 60 days from spud date. d. Submit plugging report (CP-4) within 60 days after final plugging is completed.

Submitted Electronically**For KCC Use ONLY**

API # 15 - _____

Conductor pipe required _____ feet

Minimum Cathodic Surface Casing Required: _____ feet

Approved by: _____

This authorization expires: _____

(This authorization void if drilling not started within 12 months of approval date.)

Spud date: _____ Agent: _____

Spot Description: _____

_____ - _____ - _____ - _____ Sec. _____ Twp. _____ S. R. _____ ☐ E ☐ W
(Q/Q/Q/Q)_____ feet from ☐ N / ☐ S Line of Section_____ feet from ☐ E / ☐ W Line of SectionIs SECTION: ☐ Regular ☐ Irregular?

(Check directions from nearest outside corner boundaries)

County: _____

Facility Name: _____

Borehole Number: _____

Ground Surface Elevation: _____ MSL

Cathodic Borehole Total Depth: _____ feet

Depth to Bedrock: _____ feet

Water InformationAquifer Penetration: ☐ None ☐ Single ☐ Multiple

Depth to bottom of fresh water: _____

Depth to bottom of usable water: _____

Water well within one-quarter mile: ☐ Yes ☐ NoPublic water supply well within one mile: ☐ Yes ☐ No

Water Source for Drilling Operations:

☐ Well ☐ Farm Pond ☐ Stream ☐ Other

Water Well Location: _____

DWR Permit # _____

Standard Dimension Ratio (SDR) is = _____

(Cathodic surface csg. O.D. in inches / MWT in inches = SDR)

Annular space between borehole and casing will be grouted with:

☐ Concrete ☐ Neat Cement ☐ Bentonite Cement ☐ Bentonite Clay

Anode vent pipe will be set at: _____ feet above surface

Anode conductor (backfill) material TYPE: _____

Depth of BASE of Backfill installation material: _____

Depth of TOP of Backfill installation material: _____

Borehole will be Pre-Plugged? ☐ Yes ☐ No

If this permit has expired or will not be drilled, check a box below, sign, date and return to the address below.

☐ Permit Expired ☐ Well Not Drilled

Date

Signature of Operator or Agent

For KCC Use ONLY

API # 15 - _____

IN ALL CASES, PLEASE FULLY COMPLETE THIS SIDE OF THE FORM.


In all cases, please fully complete this side of the form. Include items 1 through 3 at the bottom of this page.

Operator: _____


Facility Name: _____

Borehole Number: _____

Location of Well: County: _____

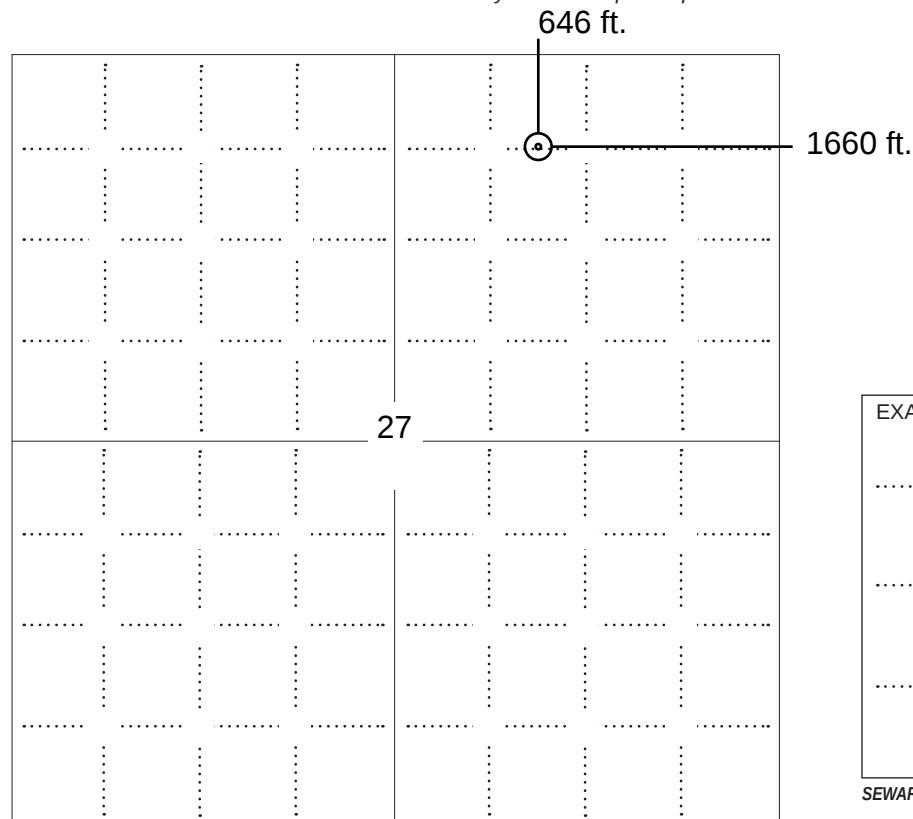_____ feet from ☐ N / ☐ S Line of Section_____ feet from ☐ E / ☐ W Line of SectionSec. _____ Twp. _____ S. R. _____ ☐ E ☐ WIs Section: ☐ Regular or ☐ Irregular**If Section is Irregular, locate well from nearest corner boundary.**Section corner used: ☐ NE ☐ NW ☐ SE ☐ SW**PLAT***Show location of the Cathodic Borehole. Show footage to the nearest lease or unit boundary line. Show the predicted locations of lease roads, tank batteries, pipelines and electrical lines, as required by the Kansas Surface Owner Notice Act (House Bill 2032).**You may attach a separate plat if desired.***LEGEND**

- ☐ Well Location
- ☐ Tank Battery Location
- ☐ Pipeline Location
- ☐ Electric Line Location
- ☐ Lease Road Location

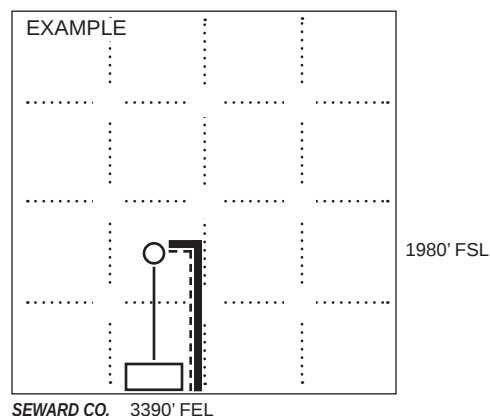**NOTE: In all cases locate the spot of the proposed drilling location.****In plotting the proposed location of the well, you must show:**

1. The manner in which you are using the depicted plat by identifying section lines, i.e. 1 section, 1 section with 8 surrounding sections, 4 sections, etc.;
2. The distance of the proposed drilling location from the section's south / north and east / west; line.
3. The predicted locations of lease roads, tank batteries, pipelines, and electrical lines.

**KANSAS CORPORATION COMMISSION
OIL & GAS CONSERVATION DIVISION
APPLICATION FOR SURFACE PIT**

Form CDP-1
July 2014
Form must be Typed

Submit in Duplicate

Operator Name:		License Number:	
Operator Address:			
Contact Person:		Phone Number:	
Lease Name & Well No.:		Pit Location (QQQQ): ____ - ____ - ____ - ____ Sec. ____ Twp. ____ R. ____ ☐ East ☐ West ____ Feet from ☐ North / ☐ South Line of Section ____ Feet from ☐ East / ☐ West Line of Section ____ County	
Type of Pit: ☐ Emergency Pit ☐ Burn Pit ☐ Settling Pit ☐ Drilling Pit ☐ Workover Pit ☐ Haul-Off Pit <i>(If WP Supply API No. or Year Drilled)</i>	Pit is: ☐ Proposed ☐ Existing If Existing, date constructed: _____ Pit capacity: _____ (bbls)		
Is the pit located in a Sensitive Ground Water Area? ☐ Yes ☐ No		Chloride concentration: _____ mg/l <i>(For Emergency Pits and Settling Pits only)</i>	
Is the bottom below ground level? ☐ Yes ☐ No	Artificial Liner? ☐ Yes ☐ No	How is the pit lined if a plastic liner is not used?	
Pit dimensions (all but working pits): _____ Length (feet) _____ Width (feet) ☐ N/A: Steel Pits Depth from ground level to deepest point: _____ (feet) ☐ No Pit			
If the pit is lined give a brief description of the liner material, thickness and installation procedure.		Describe procedures for periodic maintenance and determining liner integrity, including any special monitoring.	
Distance to nearest water well within one-mile of pit: _____ feet Depth of water well _____ feet		Depth to shallowest fresh water _____ feet. Source of information: ☐ measured ☐ well owner ☐ electric log ☐ KDWR	
Emergency, Settling and Burn Pits ONLY: Producing Formation: _____ Number of producing wells on lease: _____ Barrels of fluid produced daily: _____ Does the slope from the tank battery allow all spilled fluids to flow into the pit? ☐ Yes ☐ No		Drilling, Workover and Haul-Off Pits ONLY: Type of material utilized in drilling/workover: _____ Number of working pits to be utilized: _____ Abandonment procedure: _____ Drill pits must be closed within 365 days of spud date.	
Submitted Electronically			

KCC OFFICE USE ONLY

☐ Liner ☐ Steel Pit ☐ RFAC ☐ RFAS

Date Received: _____ Permit Number: _____ Permit Date: _____ Lease Inspection: ☐ Yes ☐ No

Mail to: KCC - Conservation Division, 266 N Main St, Ste 220, Wichita, KS 67202-1513

KANSAS CORPORATION COMMISSION
OIL & GAS CONSERVATION DIVISION

Form KSONA-1

July 2014

Form Must Be Typed

Form must be Signed

All blanks must be Filled

CERTIFICATION OF COMPLIANCE WITH THE KANSAS SURFACE OWNER NOTIFICATION ACT

This form must be submitted with all Forms C-1 (Notice of Intent to Drill); CB-1 (Cathodic Protection Borehole Intent); T-1 (Request for Change of Operator Transfer of Injection or Surface Pit Permit); and CP-1 (Well Plugging Application). Any such form submitted without an accompanying Form KSONA-1 will be returned.

Select the corresponding form being filed: ☐ **C-1** (Intent) ☐ **CB-1** (Cathodic Protection Borehole Intent) ☐ **T-1** (Transfer) ☐ **CP-1** (Plugging Application)

OPERATOR: License # _____

Name: _____

Address 1: _____

Address 2: _____

City: _____ State: _____ Zip: _____ + _____

Contact Person: _____

Phone: (_____) _____ Fax: (_____) _____

Email Address: _____

Well Location:

____ - ____ - ____ Sec. ____ Twp. ____ S. R. ____ ☐ East ☐ West

County: _____

Lease Name: _____ Well #: _____

If filing a Form T-1 for multiple wells on a lease, enter the legal description of the lease below:

Surface Owner Information:

Name: _____

Address 1: _____

Address 2: _____

City: _____ State: _____ Zip: _____ + _____

When filing a Form T-1 involving multiple surface owners, attach an additional sheet listing all of the information to the left for each surface owner. Surface owner information can be found in the records of the register of deeds for the county, and in the real estate property tax records of the county treasurer.

If this form is being submitted with a Form C-1 (Intent) or CB-1 (Cathodic Protection Borehole Intent), you must supply the surface owners and the KCC with a plat showing the predicted locations of lease roads, tank batteries, pipelines, and electrical lines. The locations shown on the plat are preliminary non-binding estimates. The locations may be entered on the Form C-1 plat, Form CB-1 plat, or a separate plat may be submitted.

Select one of the following:

- ☐ I certify that, pursuant to the Kansas Surface Owner Notice Act (House Bill 2032), I have provided the following to the surface owner(s) of the land upon which the subject well is or will be located: 1) a copy of the Form C-1, Form CB-1, Form T-1, or Form CP-1 that I am filing in connection with this form; 2) if the form being filed is a Form C-1 or Form CB-1, the plat(s) required by this form; and 3) my operator name, address, phone number, fax, and email address.
- ☐ I have not provided this information to the surface owner(s). I acknowledge that, because I have not provided this information, the KCC will be required to send this information to the surface owner(s). To mitigate the additional cost of the KCC performing this task, I acknowledge that I must provide the name and address of the surface owner by filling out the top section of this form and that I am being charged a \$30.00 handling fee, payable to the KCC, which is enclosed with this form.

If choosing the second option, submit payment of the \$30.00 handling fee with this form. If the fee is not received with this form, the KSONA-1 form and the associated Form C-1, Form CB-1, Form T-1, or Form CP-1 will be returned.

I Submitted Electronically

I _____

Webre, Matt

From: Rick Hestermann <r.hestermann@kcc.ks.gov>
Sent: Friday, June 4, 2021 7:05 AM
To: Spahr, David
Subject: [EXTERNAL] FW: Upcoming Deep Anode Projects

David,

I believe this is the e-mail from back in February. Let me know if it is not what you needed.

Rick Hestermann
EPR Department



Conservation Division
Kansas Corporation Commission
266 N. Main St., Ste. 220 | Wichita, KS | 67202-1513
Phone (316) 337-6200 | Fax (316) 337-6211 | <http://kcc.ks.gov/>

From: Rick Hestermann
Sent: Thursday, February 25, 2021 3:51 PM
To: 'Spahr, David' <David.Spahr@williams.com>
Subject: RE: Upcoming Deep Anode Projects

David,

Minimum surface casing 20' for TD of 100'. The GMD's provide KCC with the cathodic permits they issue and KCC assigns an API number to them at that time and enter them into our system. Once in our system, the ACO-1 completion forms can be filed through KOLAR for those wells.

Rick



From: Spahr, David <David.Spahr@williams.com>
Sent: Wednesday, February 24, 2021 11:33 AM
To: Rick Hestermann <r.hestermann@kcc.ks.gov>
Subject: Upcoming Deep Anode Projects

This is an EXTERNAL EMAIL. Think before clicking a link or opening attachments.

Rick,

Below are several proposed deep anode ground bed locations for 2021. Depth is for each location is 100 feet. How much casing do you estimate I will need to install so I can put a materials list together?

Proposed Cathodic Ground Bed	Proposed Depth	Latitude	Longitude	Datum	TRS	Footage NS	Footage EW	Footage Corner	Township	Township Direction	Range	Range Direction	Section	Q4 (Smallest)	Q3	Q2	Q1 (Largest)
Mitchell 2C	100	38.37597	-98.07787	WGS84	19S07W27	205	1644	NE	19	S	7	W	27	NE	NE	NW	NE
Mitchell 2D	100	38.37476	-98.07794	WGS84	19S07W27	646	1660	NE	19	S	7	W	27	SW	NE	NW	NE
Mitchell 3C	100	38.3754	-98.075516	WGS84	19S07W27	411	967	NE	19	S	7	W	27	SE	NW	NE	NE
Mitchell 3D	100	38.37342	-98.07547	WGS84	19S07W27	1131	948	NE	19	S	7	W	27	SE	SW	NE	NE
CUE 13B	100	38.36311	-97.78204	WGS84	19S04W29	283	1306	SE	19	S	4	W	29	SW	SW	SE	SE
CUE 13A	100	38.36546	-97.78209	WGS84	19S04W29	1138	1322	SE	19	S	4	W	29	NE	NE	SW	SE
CUE 12B	100	38.36303	-97.78025	WGS84	19S04W29	254	793	SE	19	S	4	W	29	SE	SW	SE	SE
CUE 12A	100	38.36497	-97.7802	WGS84	19S04W29	960	780	SE	19	S	4	W	29	SE	NW	SE	SE

Also, does KCC track ground bed installed in GMD 2's area of jurisdiction?

David Spahr
Williams | Asset Integrity Technical Specialist III
David.Spahr@Williams.com
O: 620-834-2149 | C: 580-729-8185

This email originates outside of Williams. Use caution if this message contains attachments, links or requests for information.



License # 848


Water Well Contractor License


This is to certify that Bobby Marshall, d/b/a 3-B Drilling is hereby licensed to construct, reconstruct, and treat water wells in the State of Kansas as provided by K.S.A. 82a-1201 to 1219 as amended.


This license expires June 30, 2022.

In testimony whereof, this license is issued this 1st day of July, 2021.

Bureau of Water
Geology & Well Technology
1000 SW Jackson St., Ste. 420
Topeka, KS 66612-1367
(785) 296-5524
<http://kdheks.gov/geo>

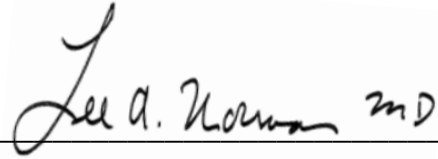
Secretary, Kansas Department of Health and Environment

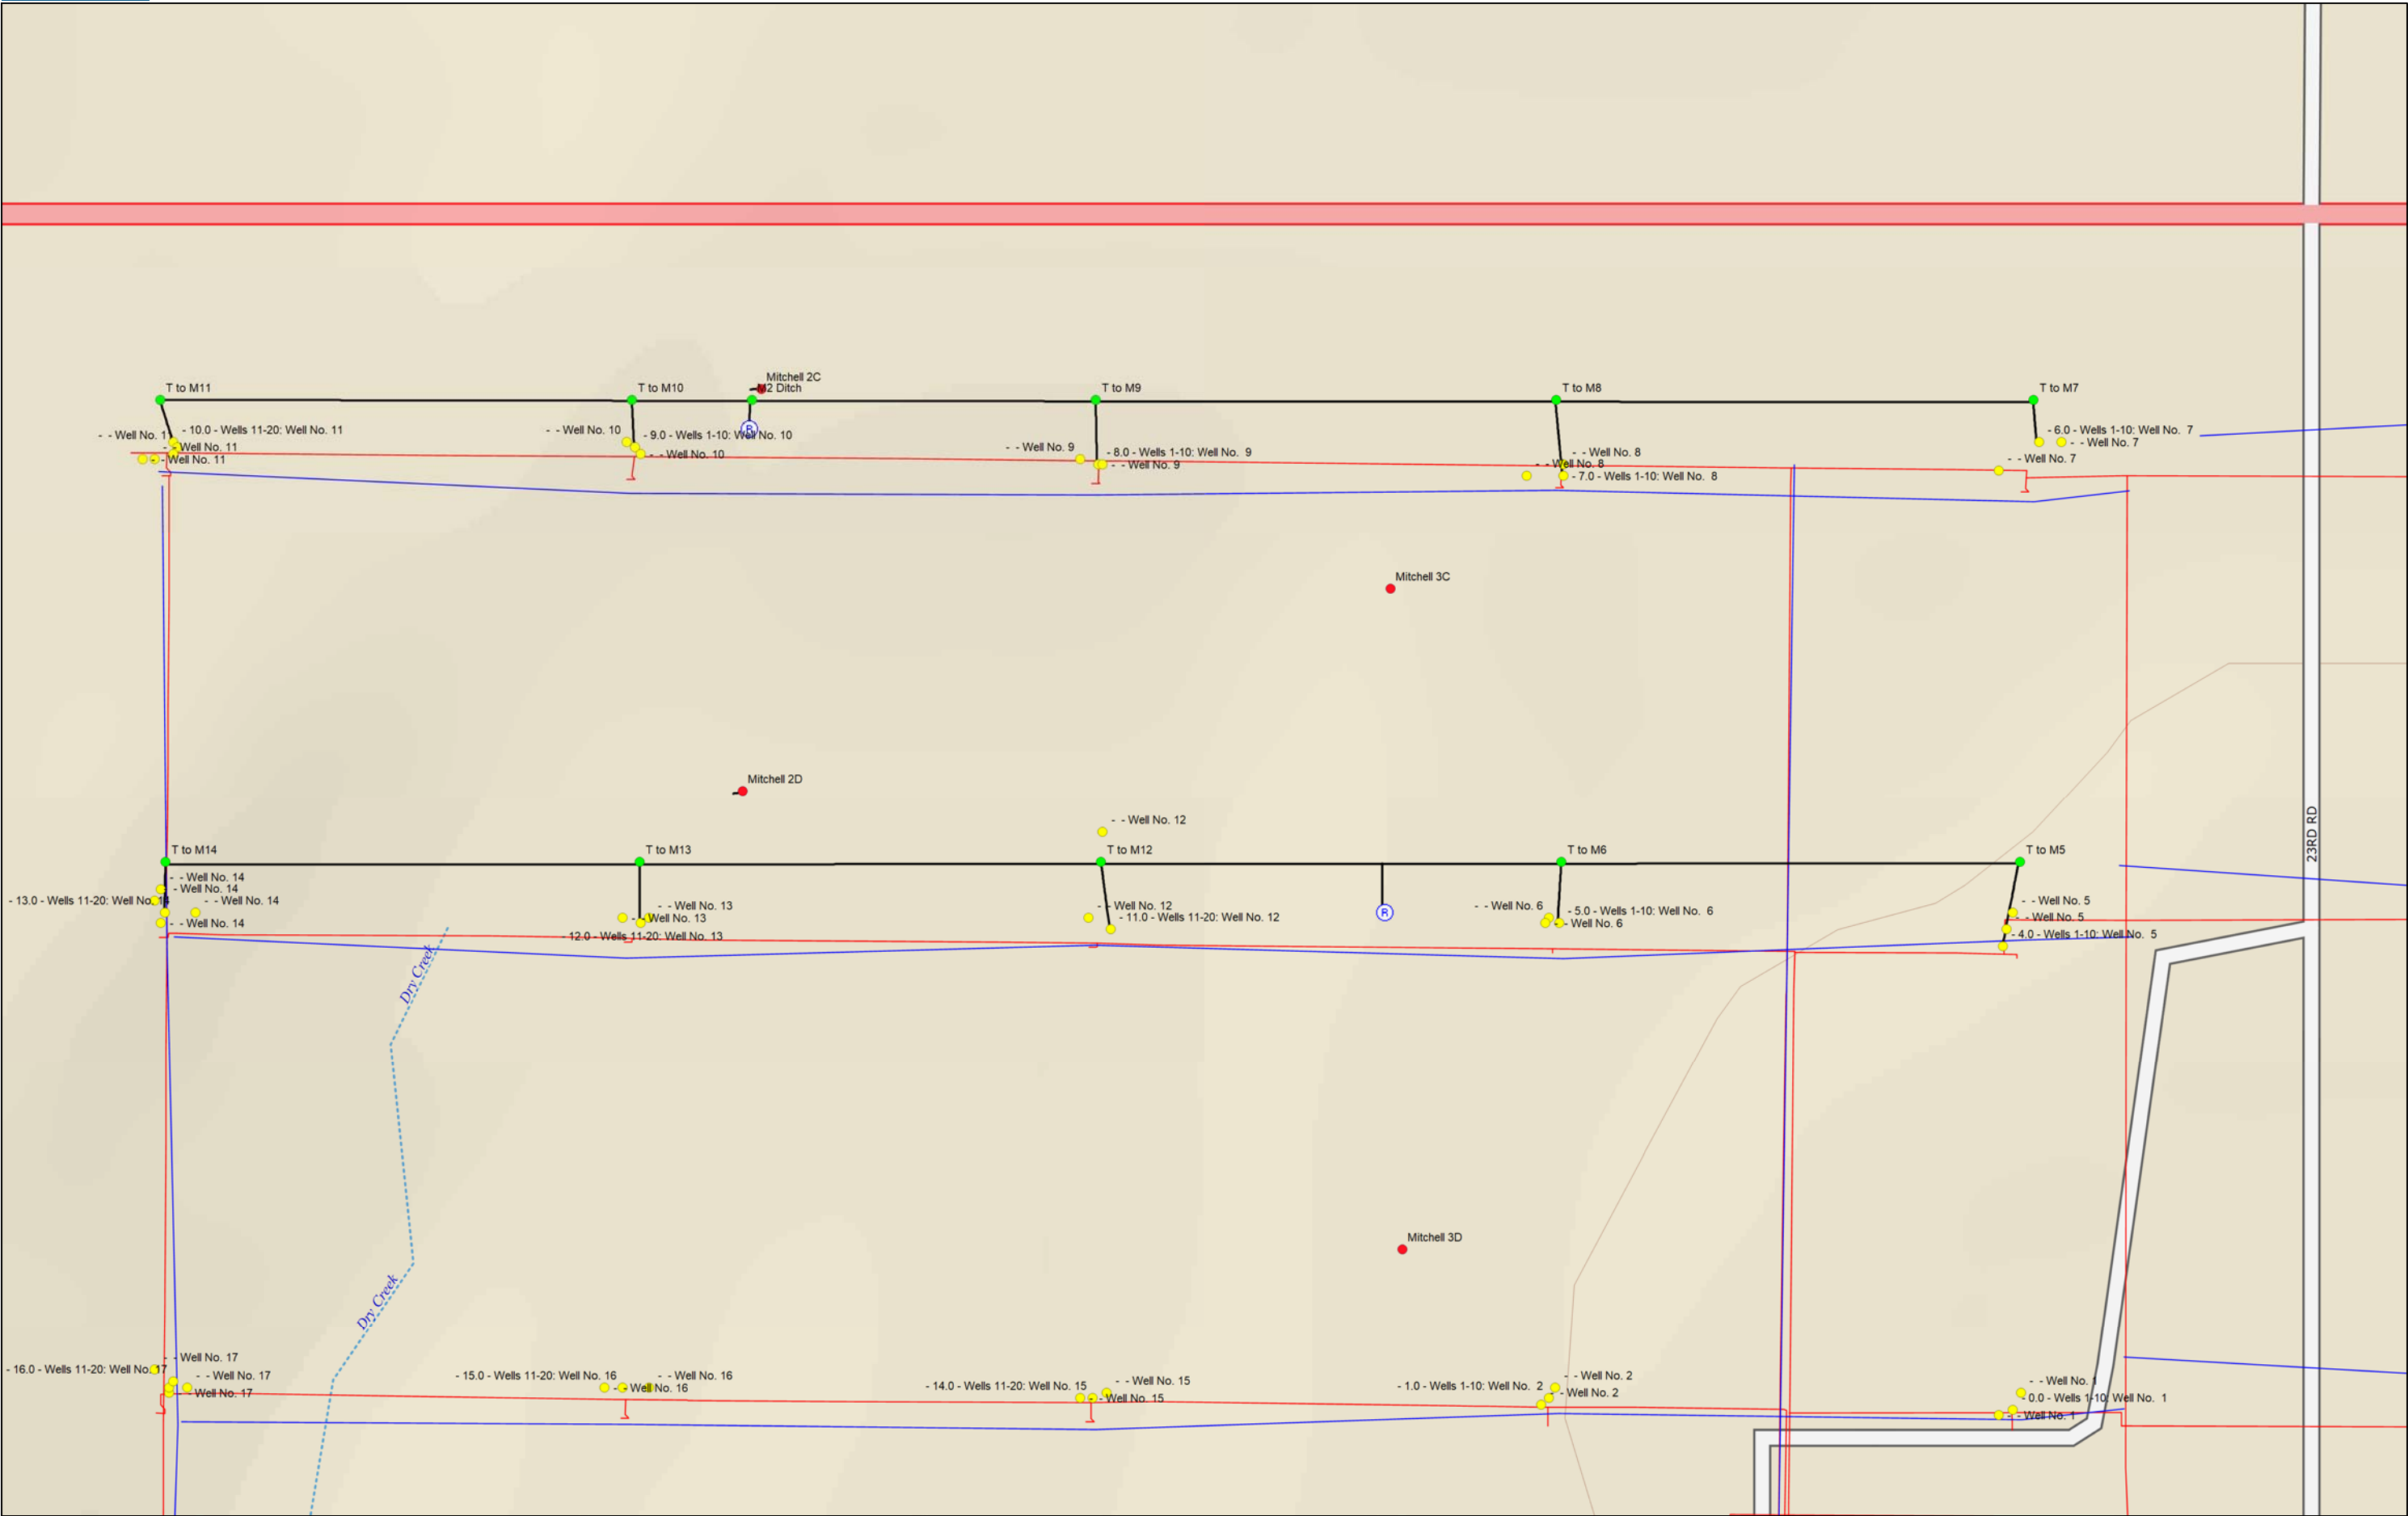

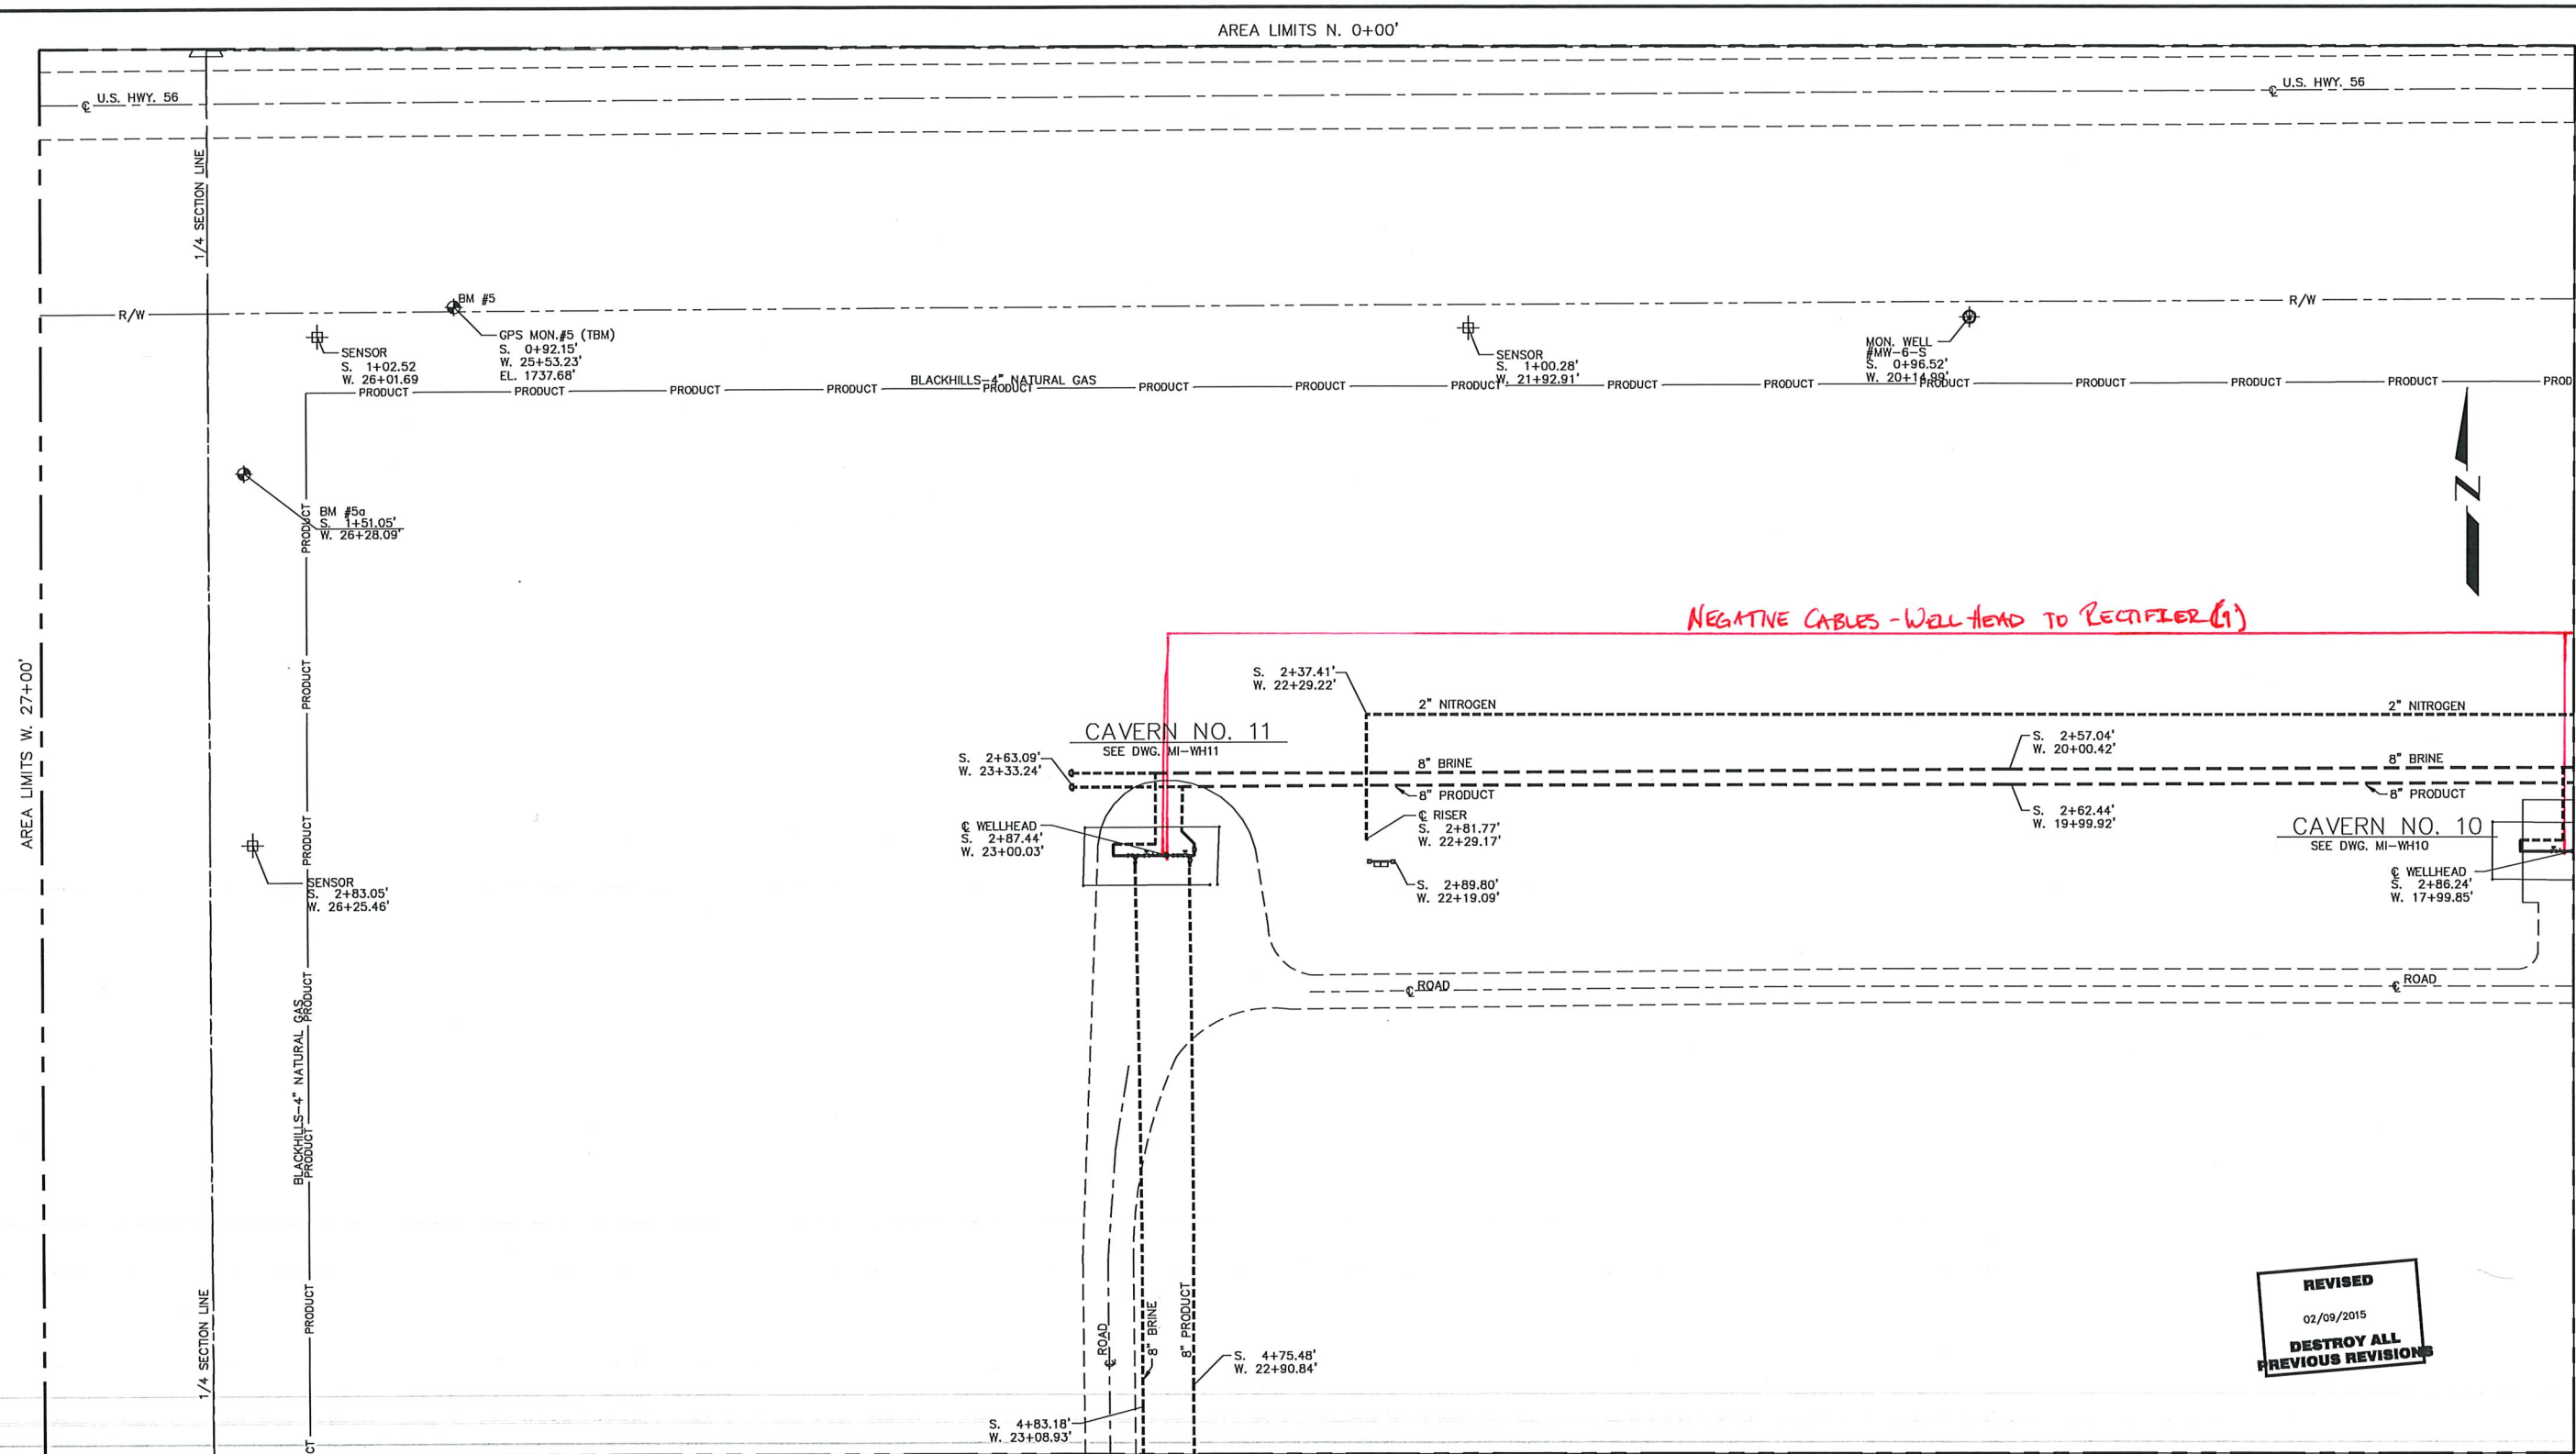

LOCATION INDEX					
SHEET 1	SHEET 2	SHEET 3	SHEET 4	SHEET 5	SHEET 6
SHEET 7	SHEET 8	SHEET 9	SHEET 10	SHEET 11	SHEET 12
SHEET 13	SHEET 14	SHEET 15	SHEET 16	SHEET 17	SHEET 18
SHEET 19	SHEET 20	SHEET 21	SHEET 22	SHEET 23	SHEET 24
SHEET 25	SHEET 26	SHEET 27	SHEET 28	SHEET 29	SHEET 30
SHEET 31	SHEET 32	SHEET 33	SHEET 34	SHEET 35	SHEET 36
SHEET 37	SHEET 38	SHEET 39	SHEET 40	SHEET 41	SHEET 42
SHEET 43	SHEET 44	SHEET 45	SHEET 46	SHEET 47	SHEET 48

Prepared By:

 **Garber Surveying Service, P.A.**

HUTCHINSON (Main Office)

McPHERSON (Branch Office)

NEWTON (Branch Office)

2908 North Plum St. 67502

115 East Martin 67460

511 North Poplar St. 67114

Ph. 620-665-7032 Fax 620-663-7401

Ph. 620-241-4441 Fax 620-241-4458

Ph. 316-283-5053 Fax 316-283-5073

4	GSS AS BUILTS: G2014-546	TK	02/09/2015	GSS
3	CONVERTED TO MASTER XREF, AS-BUILT PER REDLINES (PH. II)	MJB	7/15/2013	AW
2	REVISED PER REDLINES	ABB	12/23/10	GSS
1	DRAWN AS BUILT PER SURVEY	MS	10/16/97	
REV	DRAWN BY	DATE REVISED	CHECKED BY	PROJECT ENG.
				APPROVED BY

 **WILLIAMS MIDSTREAM GAS & LIQUIDS**

PLOT PLAN
MITCHELL STATION

RICE, KS

DRAWN BY MS

CHECKED BY

PROJECT ENG.

APPROVED BY

DATE ISSUED 10/17/1997


SCALE: 1"=30'

A.F.E.:

MI-101 01 OF 48

3

REVISED
02/09/2015
DESTROY ALL
PREVIOUS REVISIONS

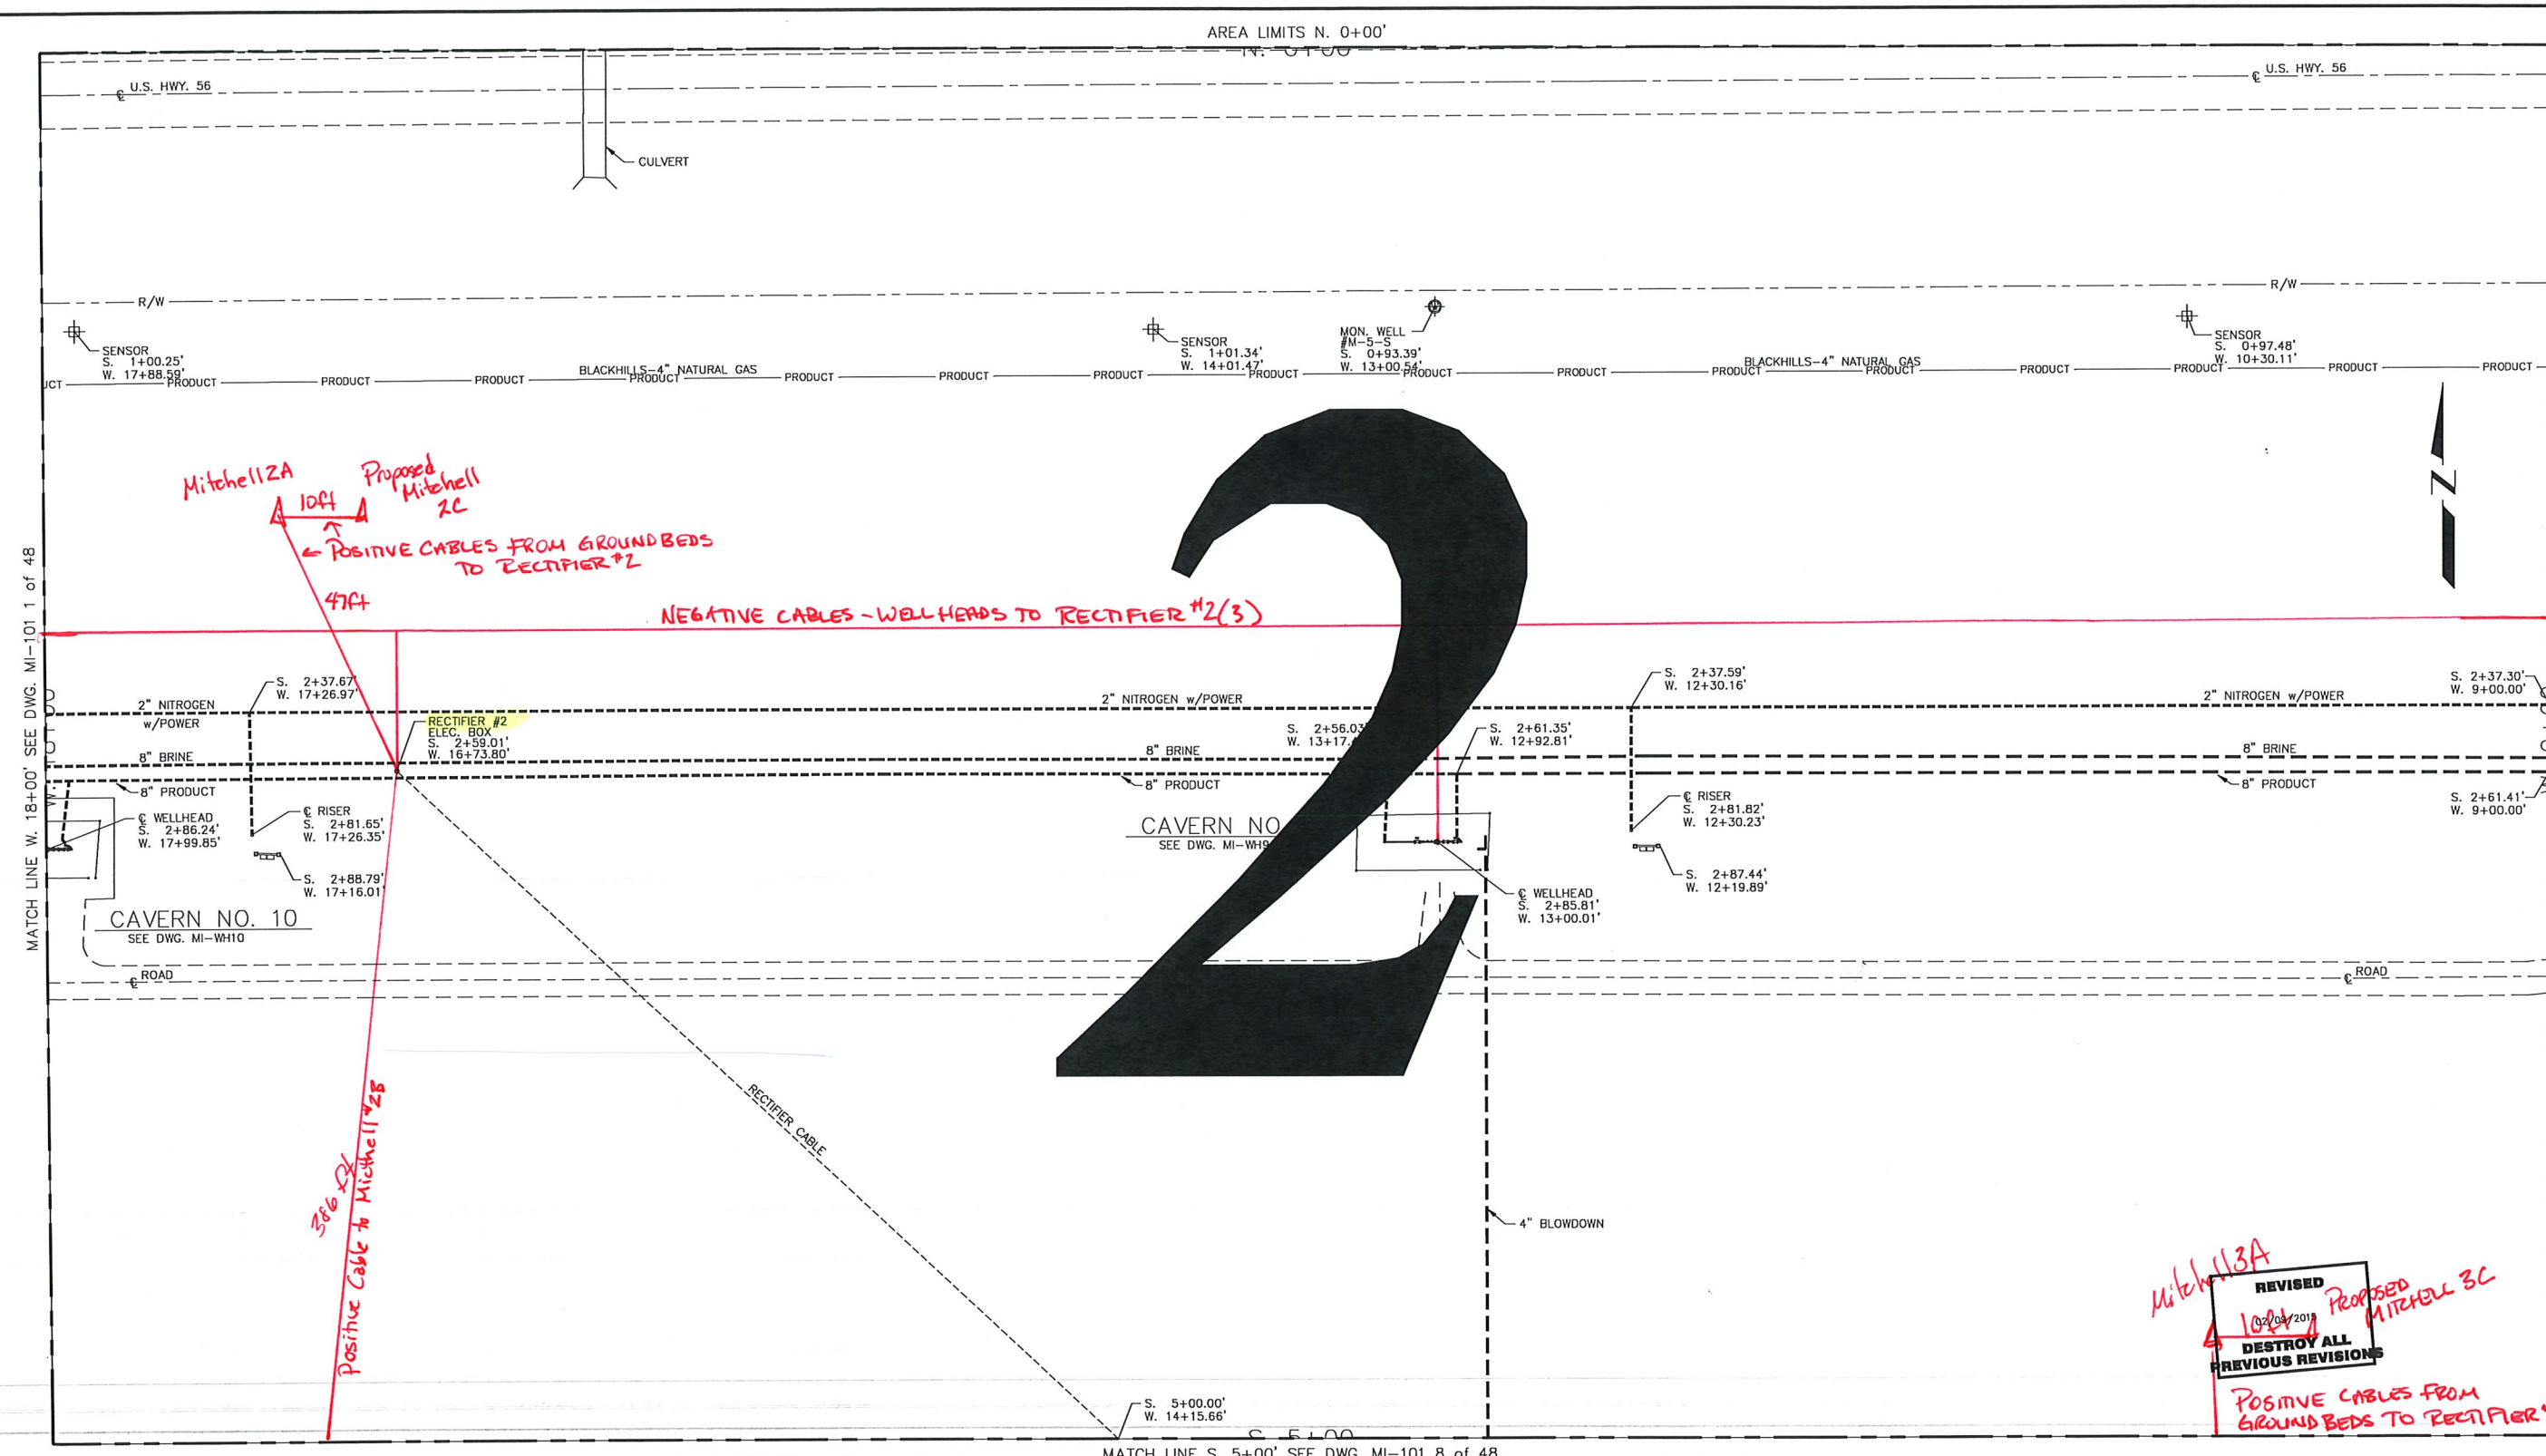

LOCATION INDEX

SHEET 1	SHEET 2	SHEET 3	SHEET 4	SHEET 5	SHEET 6
SHEET 7	SHEET 8	SHEET 9	SHEET 10	SHEET 11	SHEET 12
SHEET 13	SHEET 14	SHEET 15	SHEET 16	SHEET 17	SHEET 18
SHEET 19	SHEET 20	SHEET 21	SHEET 22	SHEET 23	SHEET 24
SHEET 25	SHEET 26	SHEET 27	SHEET 28	SHEET 29	SHEET 30
SHEET 31	SHEET 32	SHEET 33	SHEET 34	SHEET 35	SHEET 36
SHEET 37	SHEET 38	SHEET 39	SHEET 40	SHEET 41	SHEET 42
SHEET 43	SHEET 44	SHEET 45	SHEET 46	SHEET 47	SHEET 48

Prepared By:

Garber Surveying Service, P.A.

HUTCHINSON (Main Office) 2908 North Plum St. 67502 Ph. 620-665-7032 Fax 620-663-7401
 McPHERSON (Branch Office) 115 East Marlin 67460 Ph. 620-241-4441 Fax 620-241-4458
 NEWTON (Branch Office) 511 North Poplar St. 67114 Ph. 316-283-5053 Fax 316-283-5073

5	GSS AS BUILT: G2014-546	TK	02/09/2015	GSS
4	CONVERTED TO MASTER XREF, AS-BUILT PER REDLINES (PH. II)	MJB	7/15/2013	AW
3	REVISED PER REDLINES	ABB	12/23/10	GSS
2	REDRAWN & REVISED PER AFE 128-1999-TS07	RP	9/26/00	FJR
1	DRAWN AS BUILT PER SURVEY	MS	10/16/97	
REV	DRAWN BY	DATE REVISED	CHECKED BY	PROJECT ENG.
				APPROVED BY
				DATE ISSUED

Williams WILLIAMS MIDSTREAM GAS & LIQUIDS


PLOT PLAN
MITCHELL STATION

RICE, KS

DRAWN BY MS SCALE: 1"=30' A.F.E.
 CHECKED BY
 PROJECT ENG.
 APPROVED BY
 DATE ISSUED 10/17/1997

MI-101 02 OF 48

4

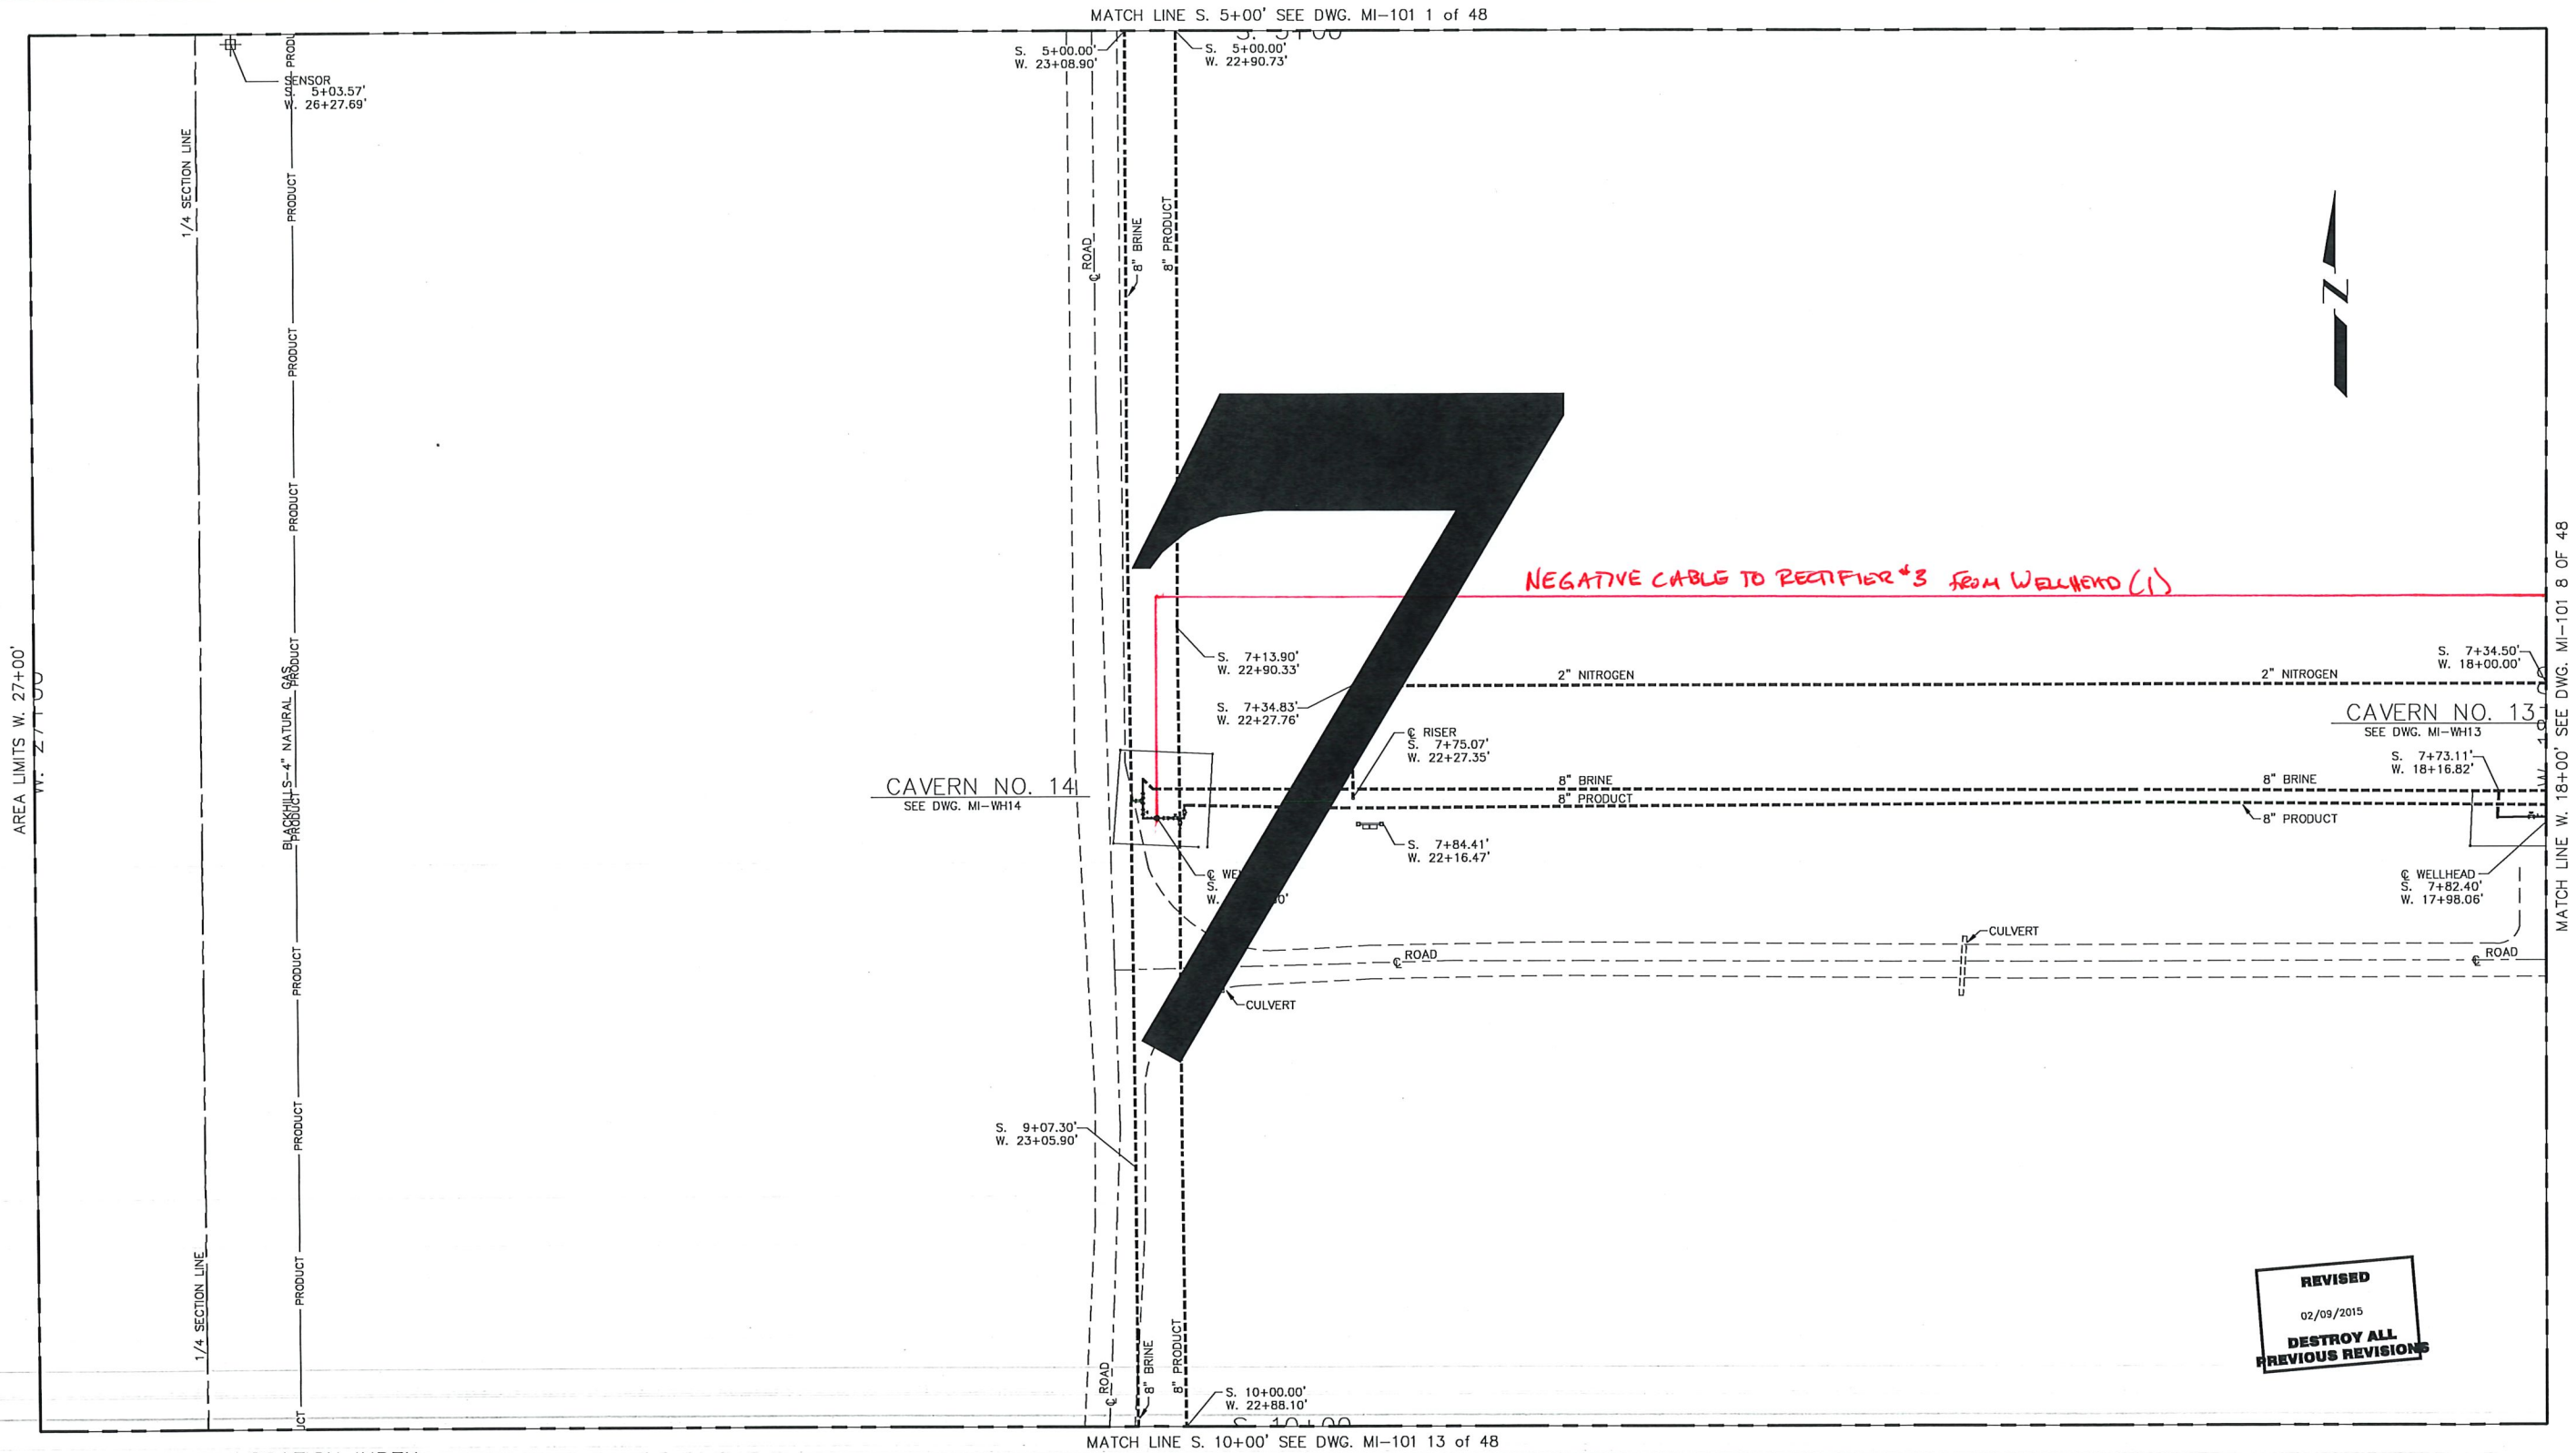

LOCATION INDEX					
SHEET 1	SHEET 2	SHEET 3	SHEET 4	SHEET 5	SHEET 6
SHEET 7	SHEET 8	SHEET 9	SHEET 10	SHEET 11	SHEET 12
SHEET 13	SHEET 14	SHEET 15	SHEET 16	SHEET 17	SHEET 18
SHEET 19	SHEET 20	SHEET 21	SHEET 22	SHEET 23	SHEET 24
SHEET 25	SHEET 26	SHEET 27	SHEET 28	SHEET 29	SHEET 30
SHEET 31	SHEET 32	SHEET 33	SHEET 34	SHEET 35	SHEET 36
SHEET 37	SHEET 38	SHEET 39	SHEET 40	SHEET 41	SHEET 42
SHEET 43	SHEET 44	SHEET 45	SHEET 46	SHEET 47	SHEET 48

Prepared By:

**Garber Surveying Service, P.A.**

HUTCHINSON (Main Office) 2908 North Plum St. 67502 Ph. 620-665-7032 Fax 620-663-7401

McPHERSON (Branch Office) 115 East Martin 67460 Ph. 620-241-4441 Fax 620-241-4458

NEWTON (Branch Office) 511 North Poplar St. 67114 Ph. 316-283-5053 Fax 316-283-5073

4	GSS AS BUILTS: C2014-546	TK	02/09/2015	GSS					
3	CONVERTED TO MASTER XREF, AS-BUILT PER REDLINES (PH. II)	MJB	7/15/2013	AW					
2	REVISED PER REDLINES	ABB	12/23/10						
1	DRAWN AS BUILT PER SURVEY	MS	10/20/97						
REV	DRAWN BY	DATE REVISED	CHECKED BY	PROJECT ENG.	APPROVED BY	DATE ISSUED	10/17/1997		

 **WILLIAMS MIDSTREAM GAS & LIQUIDS**

PLOT PLAN
MITCHELL STATION


KS

SCALE: 1"=30'

A.F.E.

MI-101 07 OF 48

3

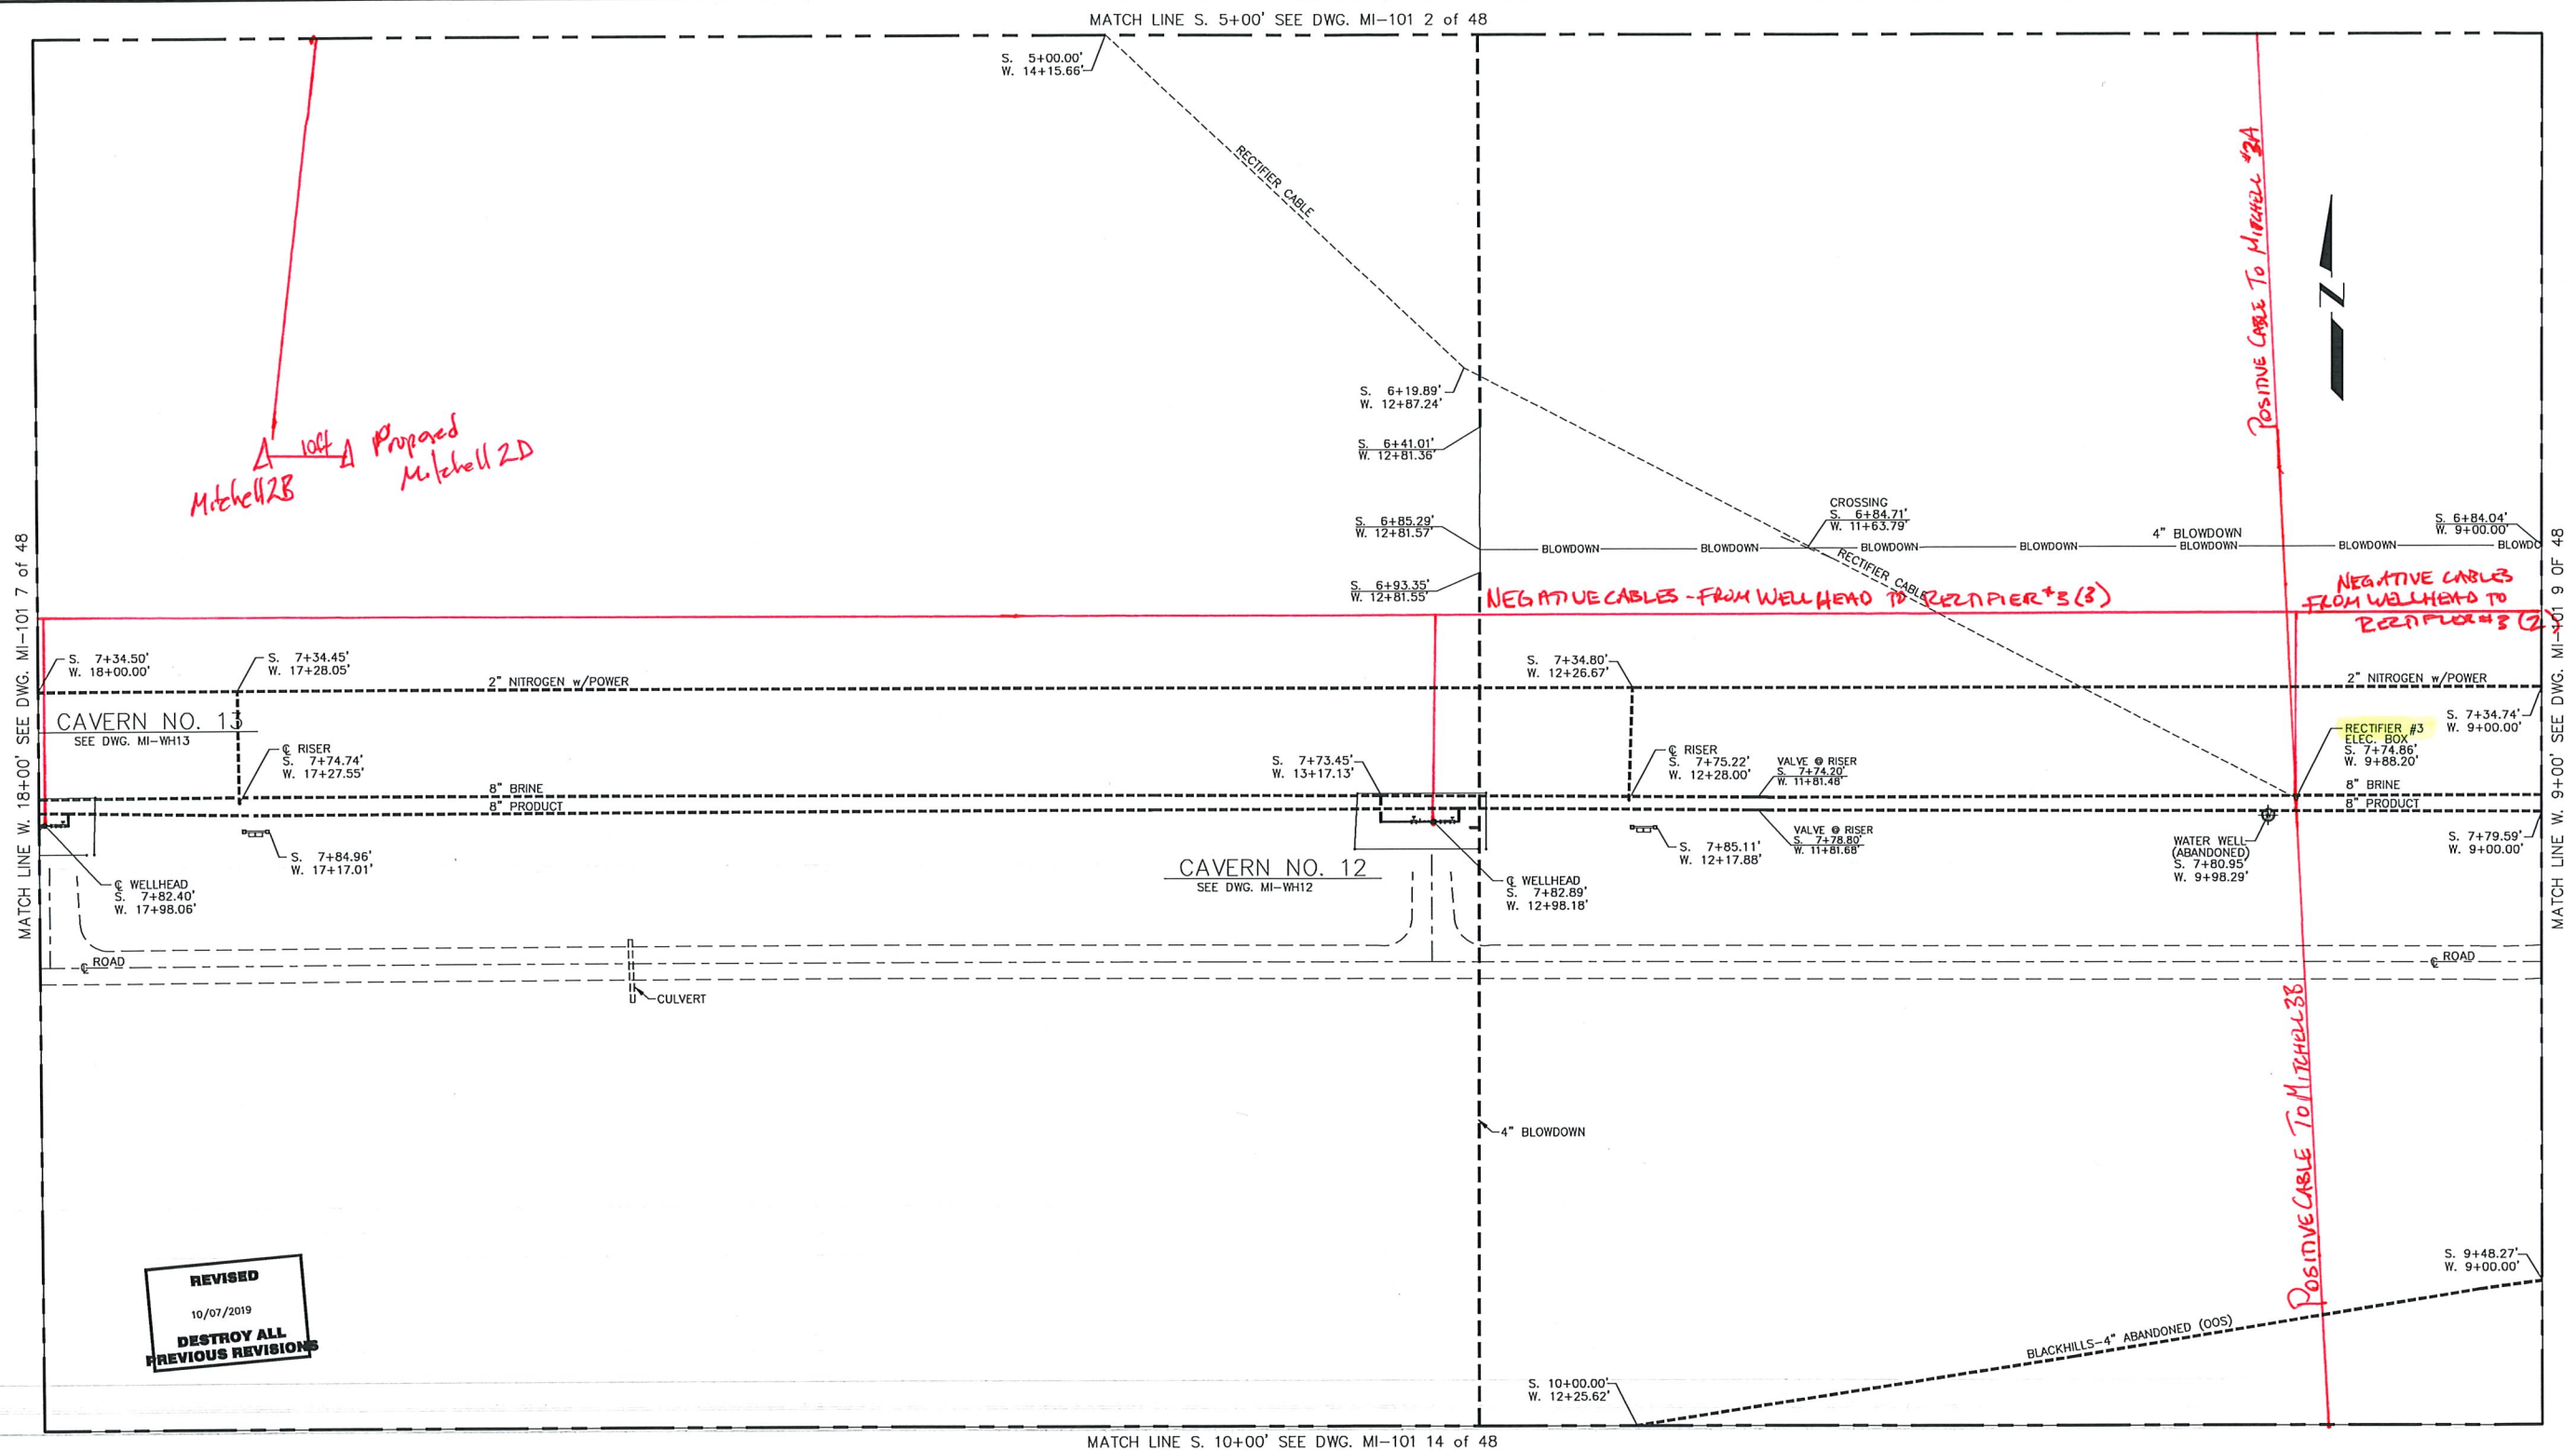

REVISED
10/07/2019
**DESTROY ALL
PREVIOUS REVISIONS**


LOCATION INDEX

SHEET 1	SHEET 2	SHEET 3	SHEET 4	SHEET 5	SHEET 6
SHEET 7	SHEET 8	SHEET 9	SHEET 10	SHEET 11	SHEET 12
SHEET 13	SHEET 14	SHEET 15	SHEET 16	SHEET 17	SHEET 18
SHEET 19	SHEET 20	SHEET 21	SHEET 22	SHEET 23	SHEET 24
SHEET 25	SHEET 26	SHEET 27	SHEET 28	SHEET 29	SHEET 30
SHEET 31	SHEET 32	SHEET 33	SHEET 34	SHEET 35	SHEET 36
SHEET 37	SHEET 38	SHEET 39	SHEET 40	SHEET 41	SHEET 42
SHEET 43	SHEET 44	SHEET 45	SHEET 46	SHEET 47	SHEET 48

Prepared By:
GSS
Garber Surveying Service, P.A.
HUTCHINSON (Main Office) 2908 North Plum St. 67502 Ph. 620-665-7032 Fax 620-663-7401
McPHERSON (Branch Office) 115 East Martin 67460 Ph. 620-241-4441 Fax 620-241-4458
NEWTON (Branch Office) 511 North Poplar St. 67114 Ph. 316-283-3053 Fax 316-283-5073

7	GSS: G2019-185 MITCHELL PRODUCT AND BRINE RISER (RFS 727666)				
6	GSS AS BUILTS: G2014-546				
5	CONVERTED TO MASTER XREF, AS-BUILT PER REDLINES (PH. II)				
4	GSS AS BUILTS G2011-535				
3	REVISED PER REDLINES				
2	REDRAWN & REVISED PER AFE 128-1999-TS07				
1	DRAWN AS BUILT PER SURVEY				
REV	DRAWN BY	DATE REVISED	CHECKED BY	PROJECT ENG.	APPROVED BY
					DATE ISSUED 10/17/1997

WILLIAMS MIDSTREAM GAS & LIQUIDS
PLOT PLAN
MITCHELL STATION
Rice County, Kansas
SCALE: 1"=30'
MI-101 08 OF 48

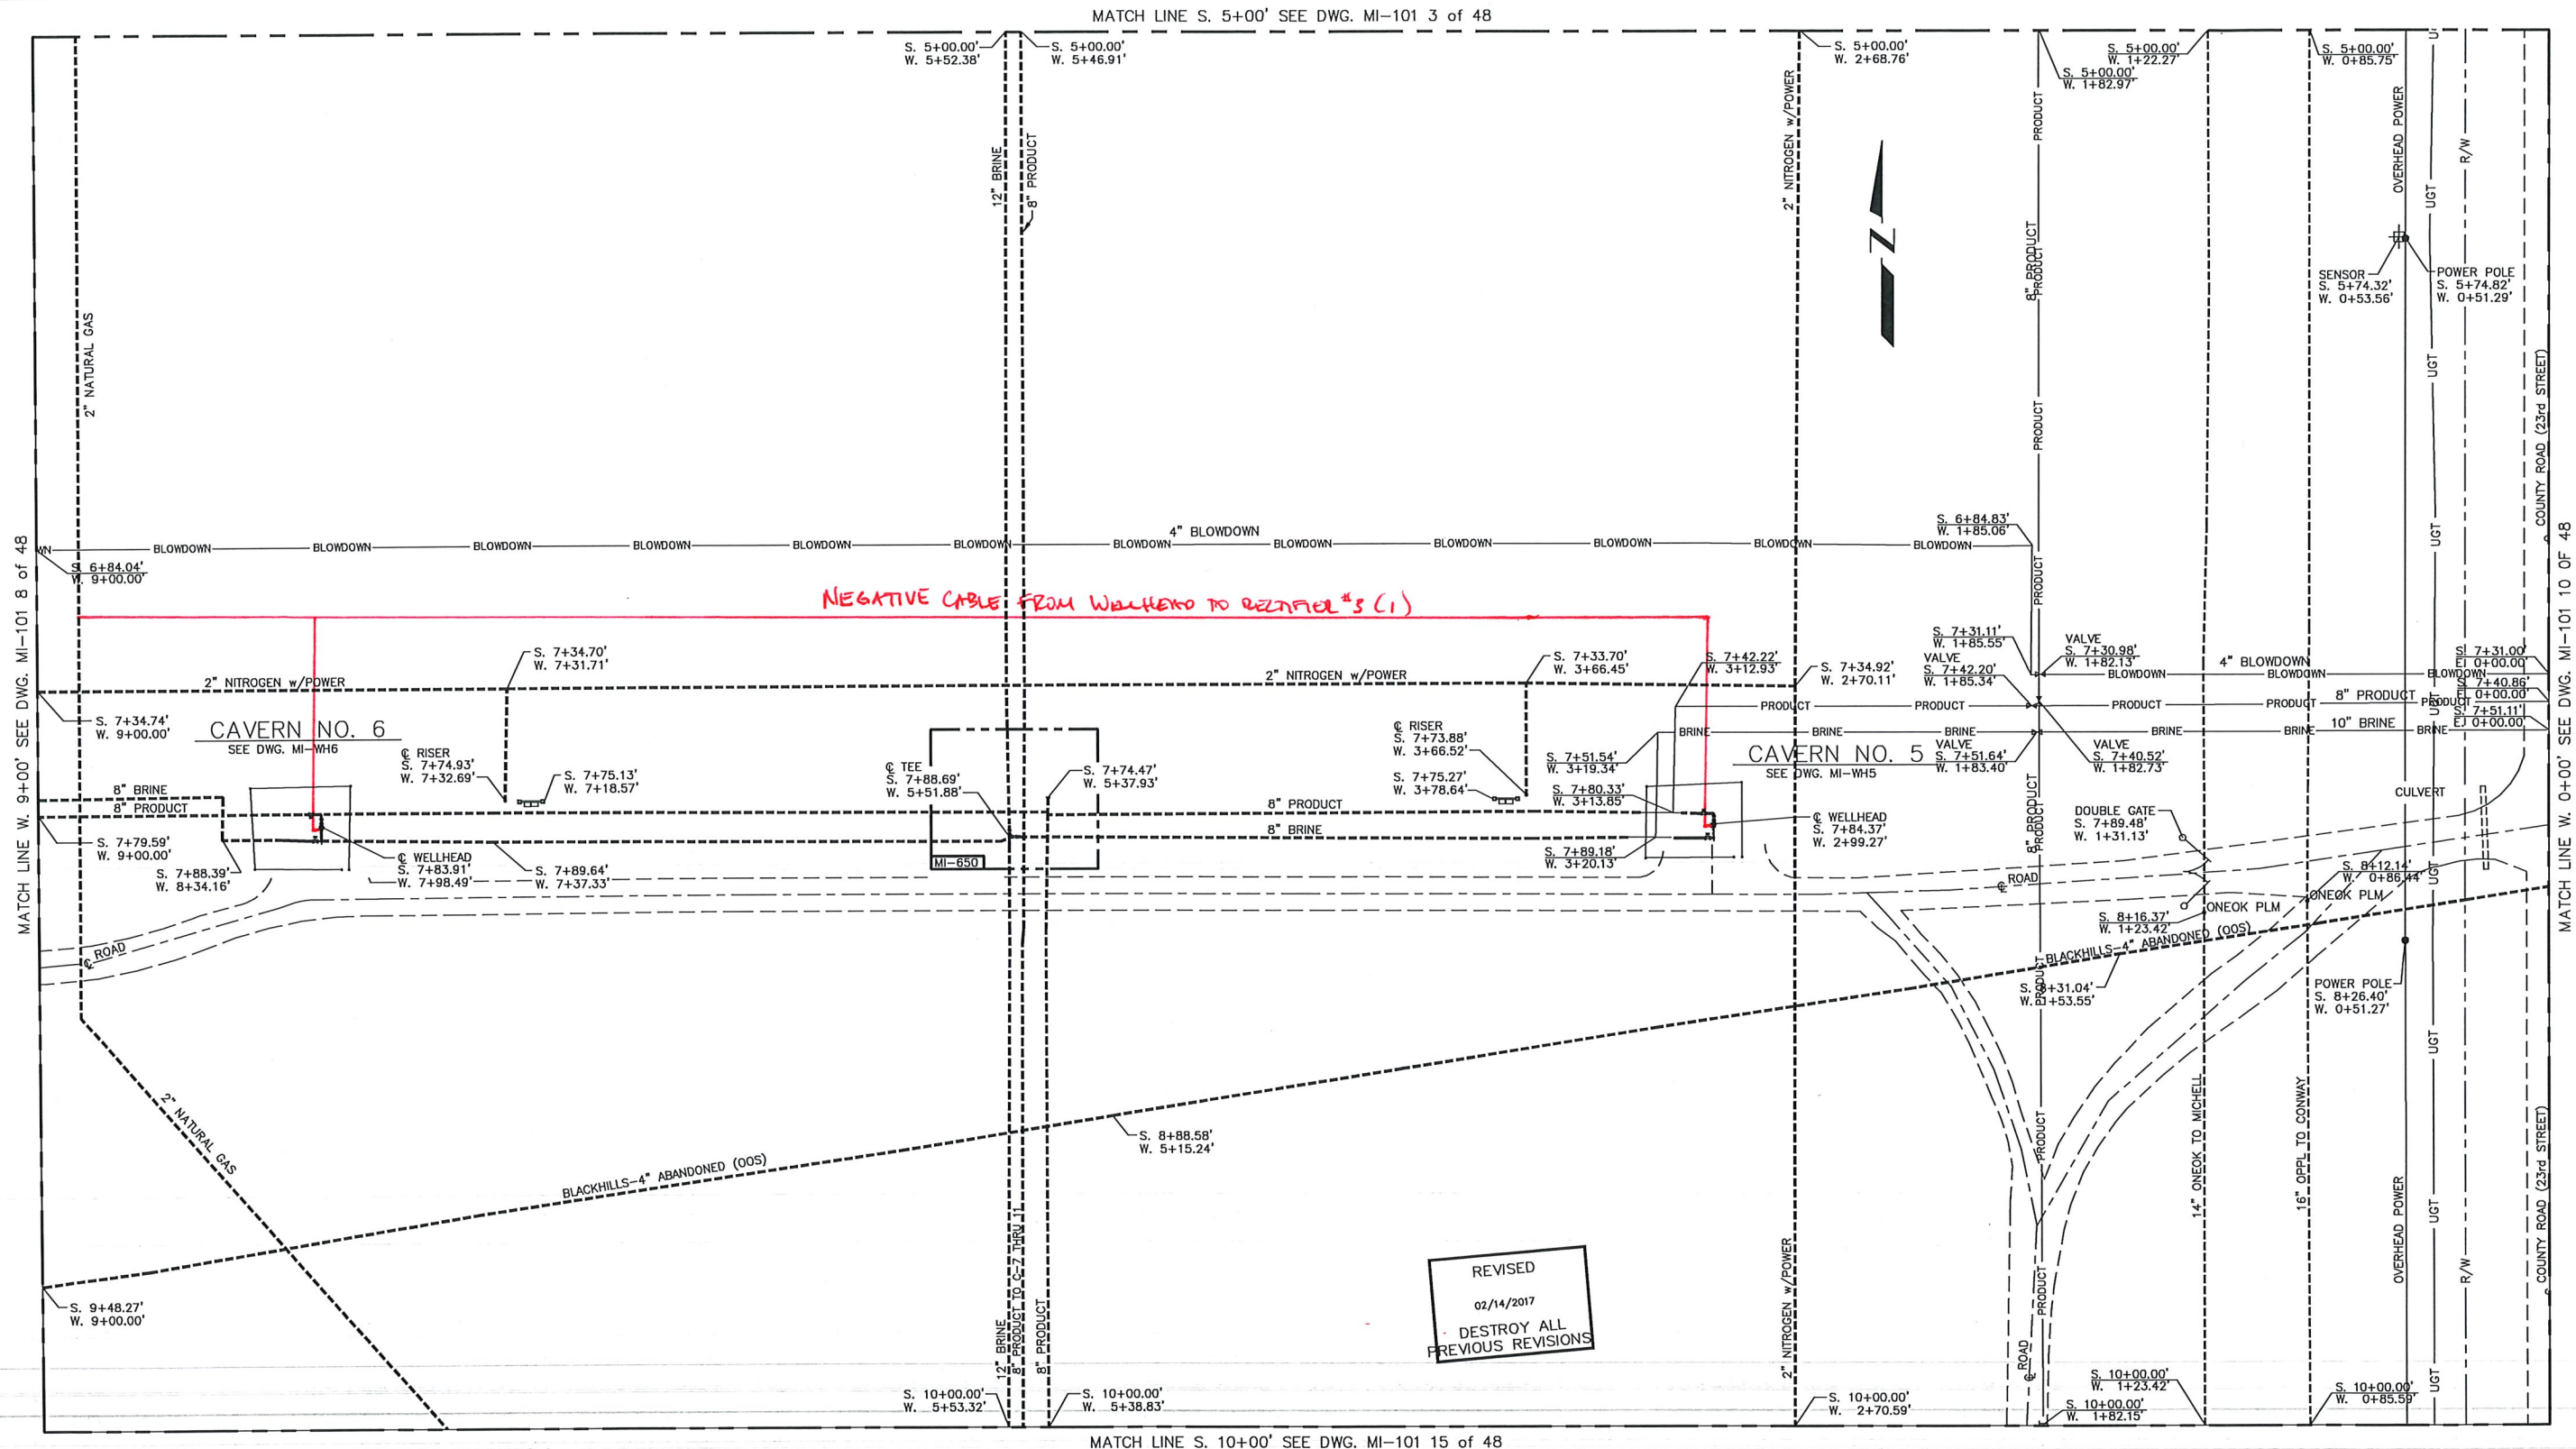

LOCATION INDEX

SHEET 1	SHEET 2	SHEET 3	SHEET 4	SHEET 5	SHEET 6
SHEET 7	SHEET 8	SHEET 9	SHEET 10	SHEET 11	SHEET 12
SHEET 13	SHEET 14	SHEET 15	SHEET 16	SHEET 17	SHEET 18
SHEET 19	SHEET 20	SHEET 21	SHEET 22	SHEET 23	SHEET 24
SHEET 25	SHEET 26	SHEET 27	SHEET 28	SHEET 29	SHEET 30
SHEET 31	SHEET 32	SHEET 33	SHEET 34	SHEET 35	SHEET 36
SHEET 37	SHEET 38	SHEET 39	SHEET 40	SHEET 41	SHEET 42
SHEET 43	SHEET 44	SHEET 45	SHEET 46	SHEET 47	SHEET 48

Prepared By: **Garber Surveying Service, P.A.**
GSS
HUTCHINSON (Main Office) 2908 North Plum St. 67502 Ph. 620-663-7032 Fax 620-663-7401
McPHERSON (Branch Office) 115 East Martin 67460 Ph. 620-241-4441 Fax 620-241-4458
NEWTON (Branch Office) 5111 North Poplar St. 67114 Ph. 316-283-5053 Fax 316-283-5073

8	GSS AS BUILTS: C2016-617 MITCHELL ONEOK & 16" OPPL REVISIONS
REV	TK 02/14/2017 GSS
DRAWN BY	DATE REVISED
CHECKED BY	PROJECT ENG.
APPROVED BY	APPROVED BY

7	GSS AS BUILTS: G2014-546	TK	02/09/2015	GSS
6	CONVERTED TO MASTER XREF, AS-BUILT PER REDLINES (PH. II)	MJB	7/15/2013	AW
5	GSS AS BUILTS G2011-535	TK	1-31-13	GSS
4	REVISED PER REDLINES	ABB	12/23/10	
3	ADDED NEW OPPL AND ONEOK PIPELINES	RCK	6/24/09	
2	REVISED AS BUILT	MS	8/18/97	
1	DRAWN AS BUILT PER SURVEY	MS	10/21/97	
REV	DRAWN BY	DATE REVISED	CHECKED BY	PROJECT ENG.
				APPROVED BY
				DATE ISSUED 10/17/1997

Williams WILLIAMS MIDSTREAM GAS & LIQUIDS

PLOT PLAN
MITCHELL STATION

Rice County Kansas

DRAWN BY MS SCALE: 1"=30' A.F.E.:


CHECKED BY

PROJECT ENG.

APPROVED BY

DRAWING NO. MI-101 09 OF 48

REVISED
02/14/2017
DESTROY ALL
PREVIOUS REVISIONS

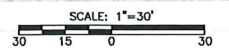

Conservation Division
266 N. Main St., Ste. 220
Wichita, KS 67202-1513



Phone: 316-337-6200
Fax: 316-337-6211
<http://kcc.ks.gov/>

Andrew J. French, Chairperson
Dwight D. Keen, Commissioner
Susan K. Duffy, Commissioner

Laura Kelly, Governor

According to the drilling pit application, no earthen pits will be used at this location. Steel pits will be used. Please inform the Commission in writing as to which disposal well you utilized to dispose of the contents in the steel pits and the amount of fluid that was disposed. Please file form CDP-5, Exploration and Production Waste Transfer, within 30 days of fluid removal.

Should a haul-off pit be necessary please file form CDP-1, Application for Surface Pit, This location will have to be inspected prior to approval of the haul-off pit application.

A copy of this letter should be posted in the doghouse along with the approved Intent to Drill.