KOLAR Document ID: 1640400

WATER WELL RECORD (WWC-5)

KOLAR DOC ID _____

Correction

Lease Name & Well #: ____

of boreholes: _____ # of dewatering wells: _

Original Record

WELL ID_____ Change in Well Use

LOCATION OF WATER WELL

Latitude	Longitude	Section	Township	Range	E W	Fraction	1⁄4	1⁄4	1⁄4
Datum	Elevation	County							

WATER WELL OWNER

Name	
Business	
Address	
Well location	
at owner's address	
CONCERNICE	

CONSTRUCTION

Borehole interval:	Borehole diameter:			
fromtoft.	in.			
fromtoft.	in.			
Casing height above land su				
If casing height is less the has a variance been appr *variance not required fo	roved?* Yes No			
or environmental remed	U U			
Casing type:				
Blank casing interval:	ft. toft.			
Blank casing diameter:	in.			
Casing joints:				
Weight:lbs	s/ft.			
Wall thickness or gauge	no.:			
Blank casing interval:	ft. toft.			
Blank casing diameter:	in.			
Casing joints:				
Weight:lbs	s/ft.			
Wall thickness or gauge	no.:			
Grout interval: ft. to	ft.			
Grout material:				
Grout interval: ft. to	oft.			
Grout material:				
Screen / perforation material	:			
Screen / perforation opening	gs:			
Screen / perforation intervals	S:			
Fromft. to	_ft.			
Slot size unit _				
Fromft. to	_ft.			
Slot size unit _				
Gravel pack intervals:				
Gravel pack not used:	Gravel size in			
From ft. to	ft.			
Gravel pack not used:				
From ft. to				

	County						
WELL	WATER U	SE					
сомі	PLETION						
Dept	th of compl	eted we	11:		ft.		
	th(s) groun						
(1)_	ft.;	(2)	ft.;				
(3) _	ft.;	(4)	dry well				
Stati	c water leve	el in wel	l:	ft.			
measured below land surface on (mm/dd/yy):							
measured above land surface on (mm/dd/yy):							
Estir	nated yield	:	_gpm				
Wate	er level was	:	ft. after		hours		
			pumping		gpm		
Pum	p installed	Yes	No				
Wate	er well disir	fected?	Yes	No			

NEAREST SOURCE OF	POTENTIAL CONTAMINATION
Source:	
Distance from well:	Direction from well:
Source description:	
Source:	
Distance from well:	Direction
Source description:	
No potential sour within 100 feet.	ce of contamination
PERMIT & ID NUMBE	RS (AS REQUIRED)
DWR Application No).:
KDHE / EPA Project	Code:
Site Name:	
KDHE UIC Class V F	Form Completed: Yes No
County Permit: Yes	s No Permit ID:

Aquifer, if known:

Date disinfected (mm/dd/yy):


FROM	то	LITHOLOGY INTERVALS						
		•						

COMMENTS

CONTRACTOR'S OR LANDOWNERS CERTIFICATION

This water well was constructed	reconstructed	pursuant to the stated water well					
contractor's license and was complet	I certify that this record is true to						
the best of my knowledge and belief.	This water well rec	ord was completed on					
under the business name of		,					
Kansas Water Well Contractor's Lice	nse No	under the authority of the designated					
person as defined in K.A.R. 28-30-2(j) and signed and certified by the electronic signature of the							
designated person at its submittal:							
Send one copy to WATER WELL OWNER	and retain one for you	r records. Fee of \$5.00 for each constructed well					
KANSAS DEPAR	TMENT OF HEALTH	AND ENVIRONMENT					

Bureau of Water, Geology Section, 1000 SW Jackson St., Suite 420, Topeka KS 66612-1367 (785) 296-3565 | K.S.A. 82a-1212 | v2022c

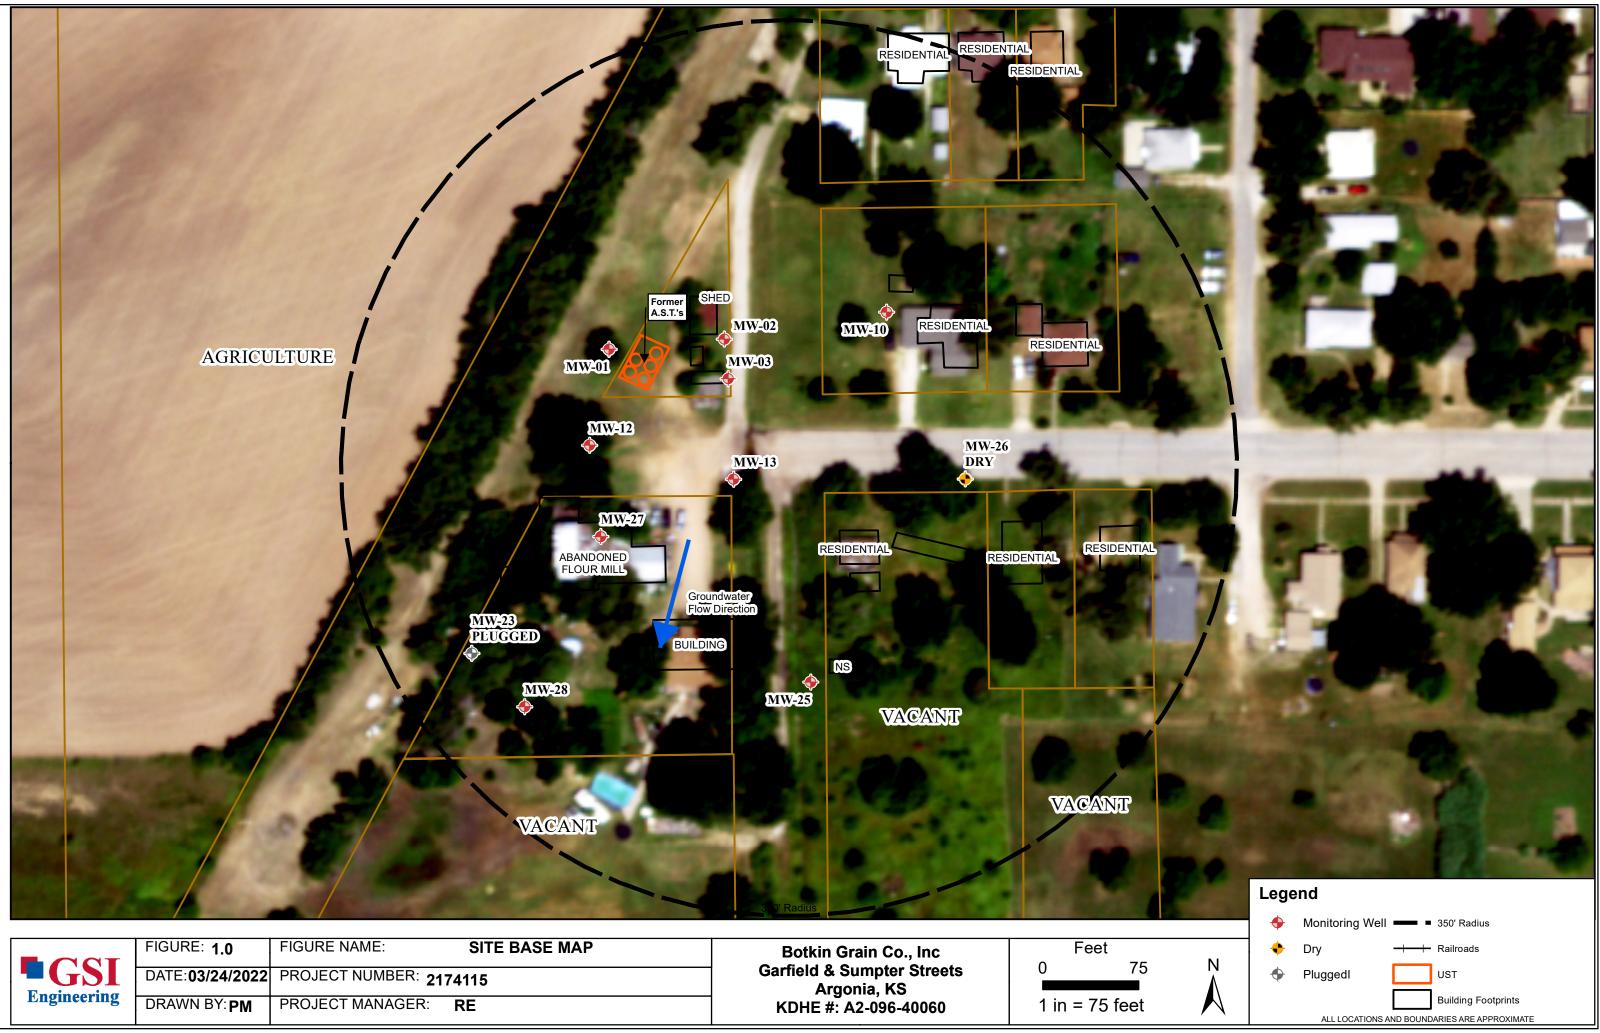

GSI Engineering	FIGURE: 1.0	URE: 1.0 FIGURE NAME: SITE BASE MAP		Botkin Grain Co., Inc	Feet	
	DATE:03/24/2022	PROJECT NUMBER: 2174115		Garfield & Sumpter Streets Argonia, KS	0	75
	DRAWN BY: PM	PROJECT MANAGER:	RE	KDHE #: A2-096-40060	1 in = 7	5 feet