KOLAR Document ID: 1644916

WATER WELL RECORD (WWC-5)

KOLAR DOC ID

Correction

Original Record

WELL ID_____ Change in Well Use

LOCATION OF WATER WELL

Latitude	Longitude	Section	Township	Range	E W	Fraction	1⁄4	1⁄4	1⁄4
Datum	Elevation	County							

WATER WELL OWNER

Name				
Business				
Address				
Well location				
at owner's address				
CONCERNICEION				

CONSTRUCTION

Borehole interval:	Borehole diameter:
fromtoft.	in.
fromtoft.	in.
Casing height above land su	
If casing height is less the has a variance been appr	
*variance not required fo or environmental reme	U
Casing type:	
Blank casing interval:	ft. toft.
Blank casing diameter:	in.
Casing joints:	
Weight:lbs	s/ft.
Wall thickness or gauge	no.:
Blank casing interval:	
Blank casing diameter:	
Casing joints:	
Weight:lbs	
Wall thickness or gauge	
Grout interval: ft. to	oft.
Grout material:	
Grout interval: ft. to	oft.
Grout material:	
Screen / perforation material	:
Screen / perforation opening	gs:
Screen / perforation intervals	S:
Fromft. to	_ft.
Slot size unit _	
From ft. to	_ft.
Slot size unit _	
Gravel pack intervals:	
Gravel pack not used:	Gravel size in
From ft. to	
Gravel pack not used:	
From ft. to	

WELL WATER USE

COMPLETION					
Depth of completed well:ft.					
Depth(s) groundwater encountered:					
(1) ft.; (2) ft.;					
(3) ft.; (4) dry well					
Static water level in well: ft.					
measured below land surface on (mm/dd/yy):					
measured above land surface on (mm/dd/yy):					
Estimated yield: gpm					
Water level was: ft. afterhours					
pumping gpm					
Pump installed? Yes No					
Water well disinfected? Yes No					
Date disinfected (mm/dd/yy):					

NEAREST SOURCE	OF POTENTIAL CONTAMINATIO
Source:	
Distance from well:	Direction from well:
Source description:	
Source:	
Distance from well:	Direction from well:
Source description:	
No potential so within 100 feet	ource of contamination
PERMIT & ID NUM	BERS (AS REQUIRED)
DWR Application	No.:
KDHE / EPA Proje	ect Code:
Site Name:	
KDHE UIC Class	V Form Completed: Yes No

County Permit: Yes No Permit ID:

of boreholes: _____ # of dewatering wells: _

Lease Name & Well #:

Aquifer, if known:

LITHOLOGIC LOG

FROM	то	LITHOLOGY INTERVALS

COMMENTS

CONTRACTOR'S OR LANDOWNERS CERTIFICATION


This water well was constructed	reconstructed	pursuant to the stated water well
contractor's license and was completed	on	I certify that this record is true to
the best of my knowledge and belief. The	his water well reco	ord was completed on
under the business name of		,
Kansas Water Well Contractor's License	e No	_ under the authority of the designated
person as defined in K.A.R. 28-30-2(j)	and signed and co	ertified by the electronic signature of the
designated person at its submittal:		
Send one copy to WATER WELL OWNER and	d retain one for you	r records. Fee of \$5.00 for each constructed well
KANSAS DEPARTM	MENT OF HEALTH	AND ENVIRONMENT

Bureau of Water, Geology Section, 1000 SW Jackson St., Suite 420, Topeka KS 66612-1367 (785) 296-3565 | K.S.A. 82a-1212 | v2022c

Form	WWC5.2 - Water Well Record	
Doc ID	1644916	
Well Owner	KDHE	
Contractor	GSI Engineering, LLC	

Lithology

From	То	Lithology Intervals
0	1	topsoil
1	9	silt,solid, low, hard, brown, no odor, no particulate, very dry
9	19	silt,dry,lighter in color
19	25	silt,dry,little darker
25	30	silt,sandy,dry,solid, low, hard, lighter brown, no odor, no particulate, well sorted and angular
30	39	sand,coarse,dry,solid, low, hard, lighter brown, no odor, no particulate, very well sorted, angular
39	55	sand,coarse,getting darker and coarse
55	59	sand,coarse,sand increasing in size
59	65	sand,coarse,10%pebbles
65	69	sand,coarse,20% pebbles
69	70	sand,coarse,grain increasing size

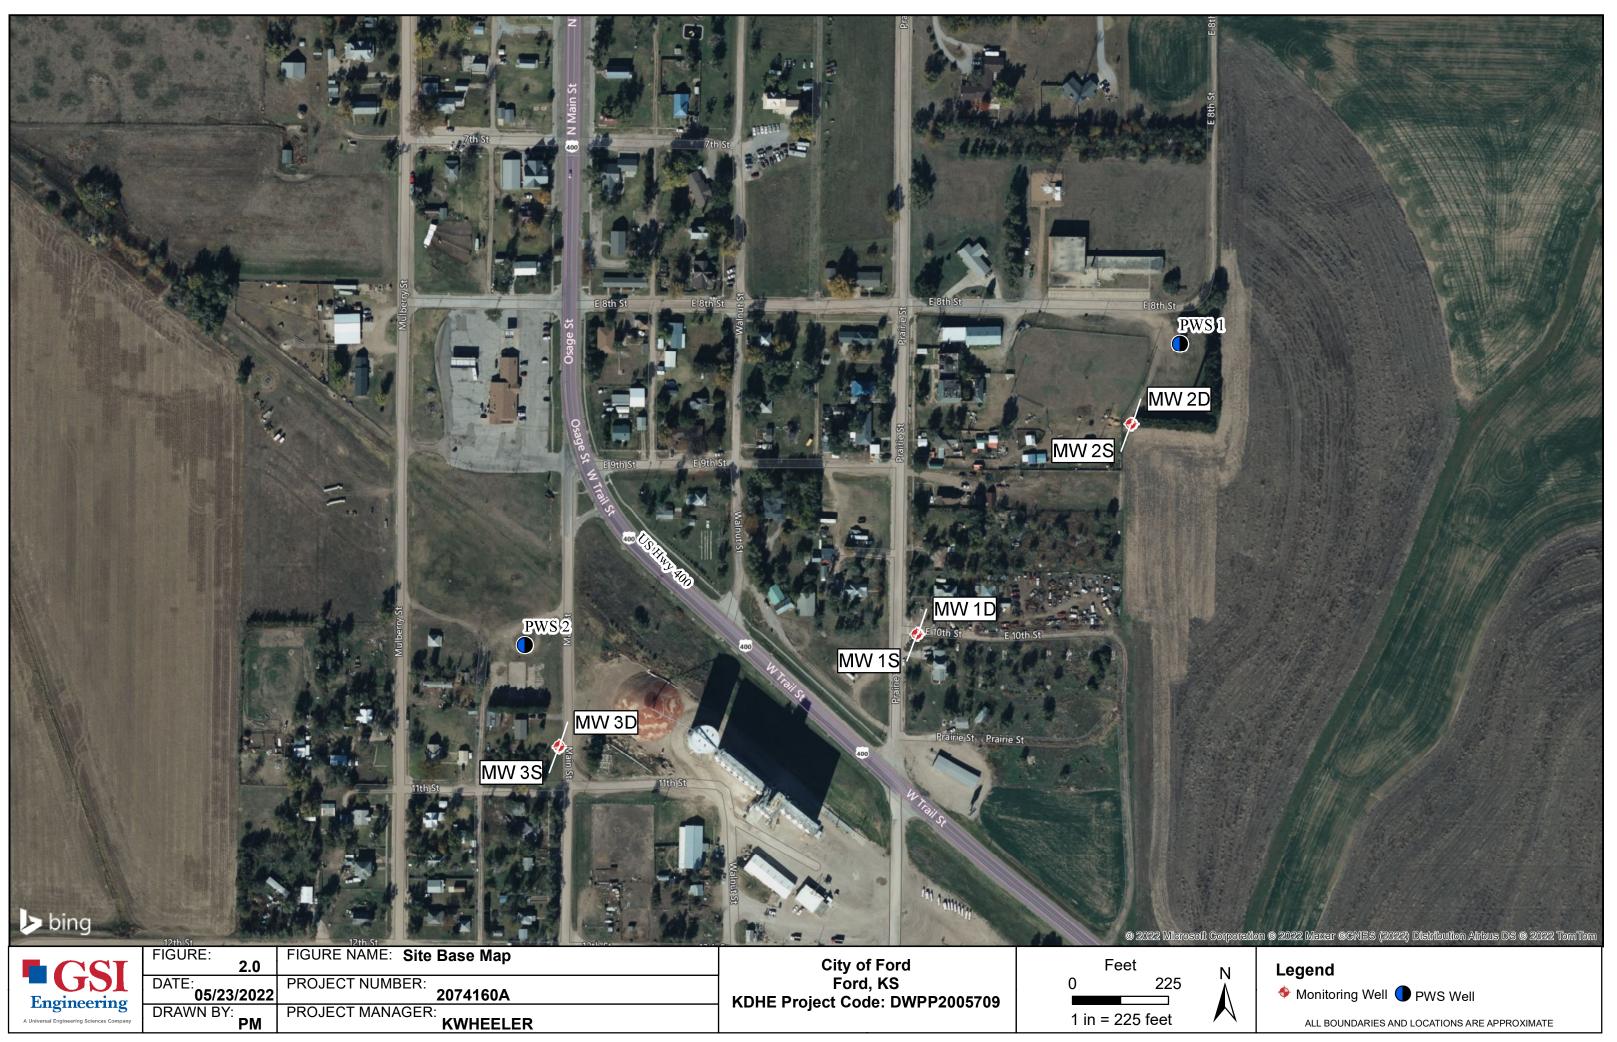

ALL BOUNDARIES AND LOCATIONS ARE APPROXIMATE