

WATER WELL RECORD (WWC-5)

KOLAR DOC ID _____ WELL ID _____
 Original Record Correction Change in Well Use

LOCATION OF WATER WELL

Latitude		Longitude		Section		Township		Range		E W	Fraction	¼	¼	¼
Datum		Elevation		County										

WATER WELL OWNER

Name	
Business	
Address	
Well location at owner's address	

WELL WATER USE

--

COMPLETION

Depth of completed well: _____ ft.
Depth(s) groundwater encountered: (1) _____ ft.; (2) _____ ft.; (3) _____ ft.; (4) dry well
Static water level in well: _____ ft. measured below land surface on (mm/dd/yy): _____ measured above land surface on (mm/dd/yy): _____
Estimated yield: _____ gpm
Water level was: _____ ft. after _____ hours pumping _____ gpm
Pump installed? Yes No
Water well disinfected? Yes No
Date disinfected (mm/dd/yy): _____
Aquifer, if known:

NEAREST SOURCE OF POTENTIAL CONTAMINATION

Source: _____
Distance from well: _____ Direction from well: _____
Source description: _____
Source: _____
Distance from well: _____ Direction from well: _____
Source description: _____
No potential source of contamination within 100 feet.

CONSTRUCTION

Borehole interval: from _____ to _____ ft.	Borehole diameter: _____ in.
from _____ to _____ ft.	_____ in.
Casing height above land surface: _____ in.	
If casing height is less than 12 in. has a variance been approved?* Yes No	
*variance not required for monitoring or environmental remediation wells	
Casing type: _____	
Blank casing interval: _____ ft. to _____ ft.	
Blank casing diameter: _____ in.	
Casing joints: _____	
Weight: _____ lbs/ft.	
Wall thickness or gauge no.: _____	
Blank casing interval: _____ ft. to _____ ft.	
Blank casing diameter: _____ in.	
Casing joints: _____	
Weight: _____ lbs/ft.	
Wall thickness or gauge no.: _____	
Grout interval: _____ ft. to _____ ft.	
Grout material: _____	
Grout interval: _____ ft. to _____ ft.	
Grout material: _____	
Screen / perforation material: _____	
Screen / perforation openings: _____	
Screen / perforation intervals: From _____ ft. to _____ ft.	
Slot size _____ unit _____	
From _____ ft. to _____ ft.	
Slot size _____ unit _____	
Gravel pack intervals: Gravel pack not used: Gravel size _____ in	
From _____ ft. to _____ ft.	
Gravel pack not used: Gravel size _____ in	
From _____ ft. to _____ ft.	

PERMIT & ID NUMBERS (AS REQUIRED)

DWR Application No.: _____
KDHE / EPA Project Code: _____
Site Name: _____
KDHE UIC Class V Form Completed: Yes No
County Permit: Yes No Permit ID: _____
Lease Name & Well #: _____
of boreholes: _____ # of dewatering wells: _____

LITHOLOGIC LOG

FROM	TO	LITHOLOGY INTERVALS


COMMENTS

--

CONTRACTOR'S OR LANDOWNERS CERTIFICATION

This water well was constructed reconstructed pursuant to the stated water well contractor's license and was completed on _____. I certify that this record is true to the best of my knowledge and belief. This water well record was completed on _____ under the business name of _____, Kansas Water Well Contractor's License No. _____ under the authority of the designated person as defined in K.A.R. 28-30-2(j) and signed and certified by the electronic signature of the designated person at its submittal: _____.

Send one copy to WATER WELL OWNER and retain one for your records. Fee of \$5.00 for each constructed well.


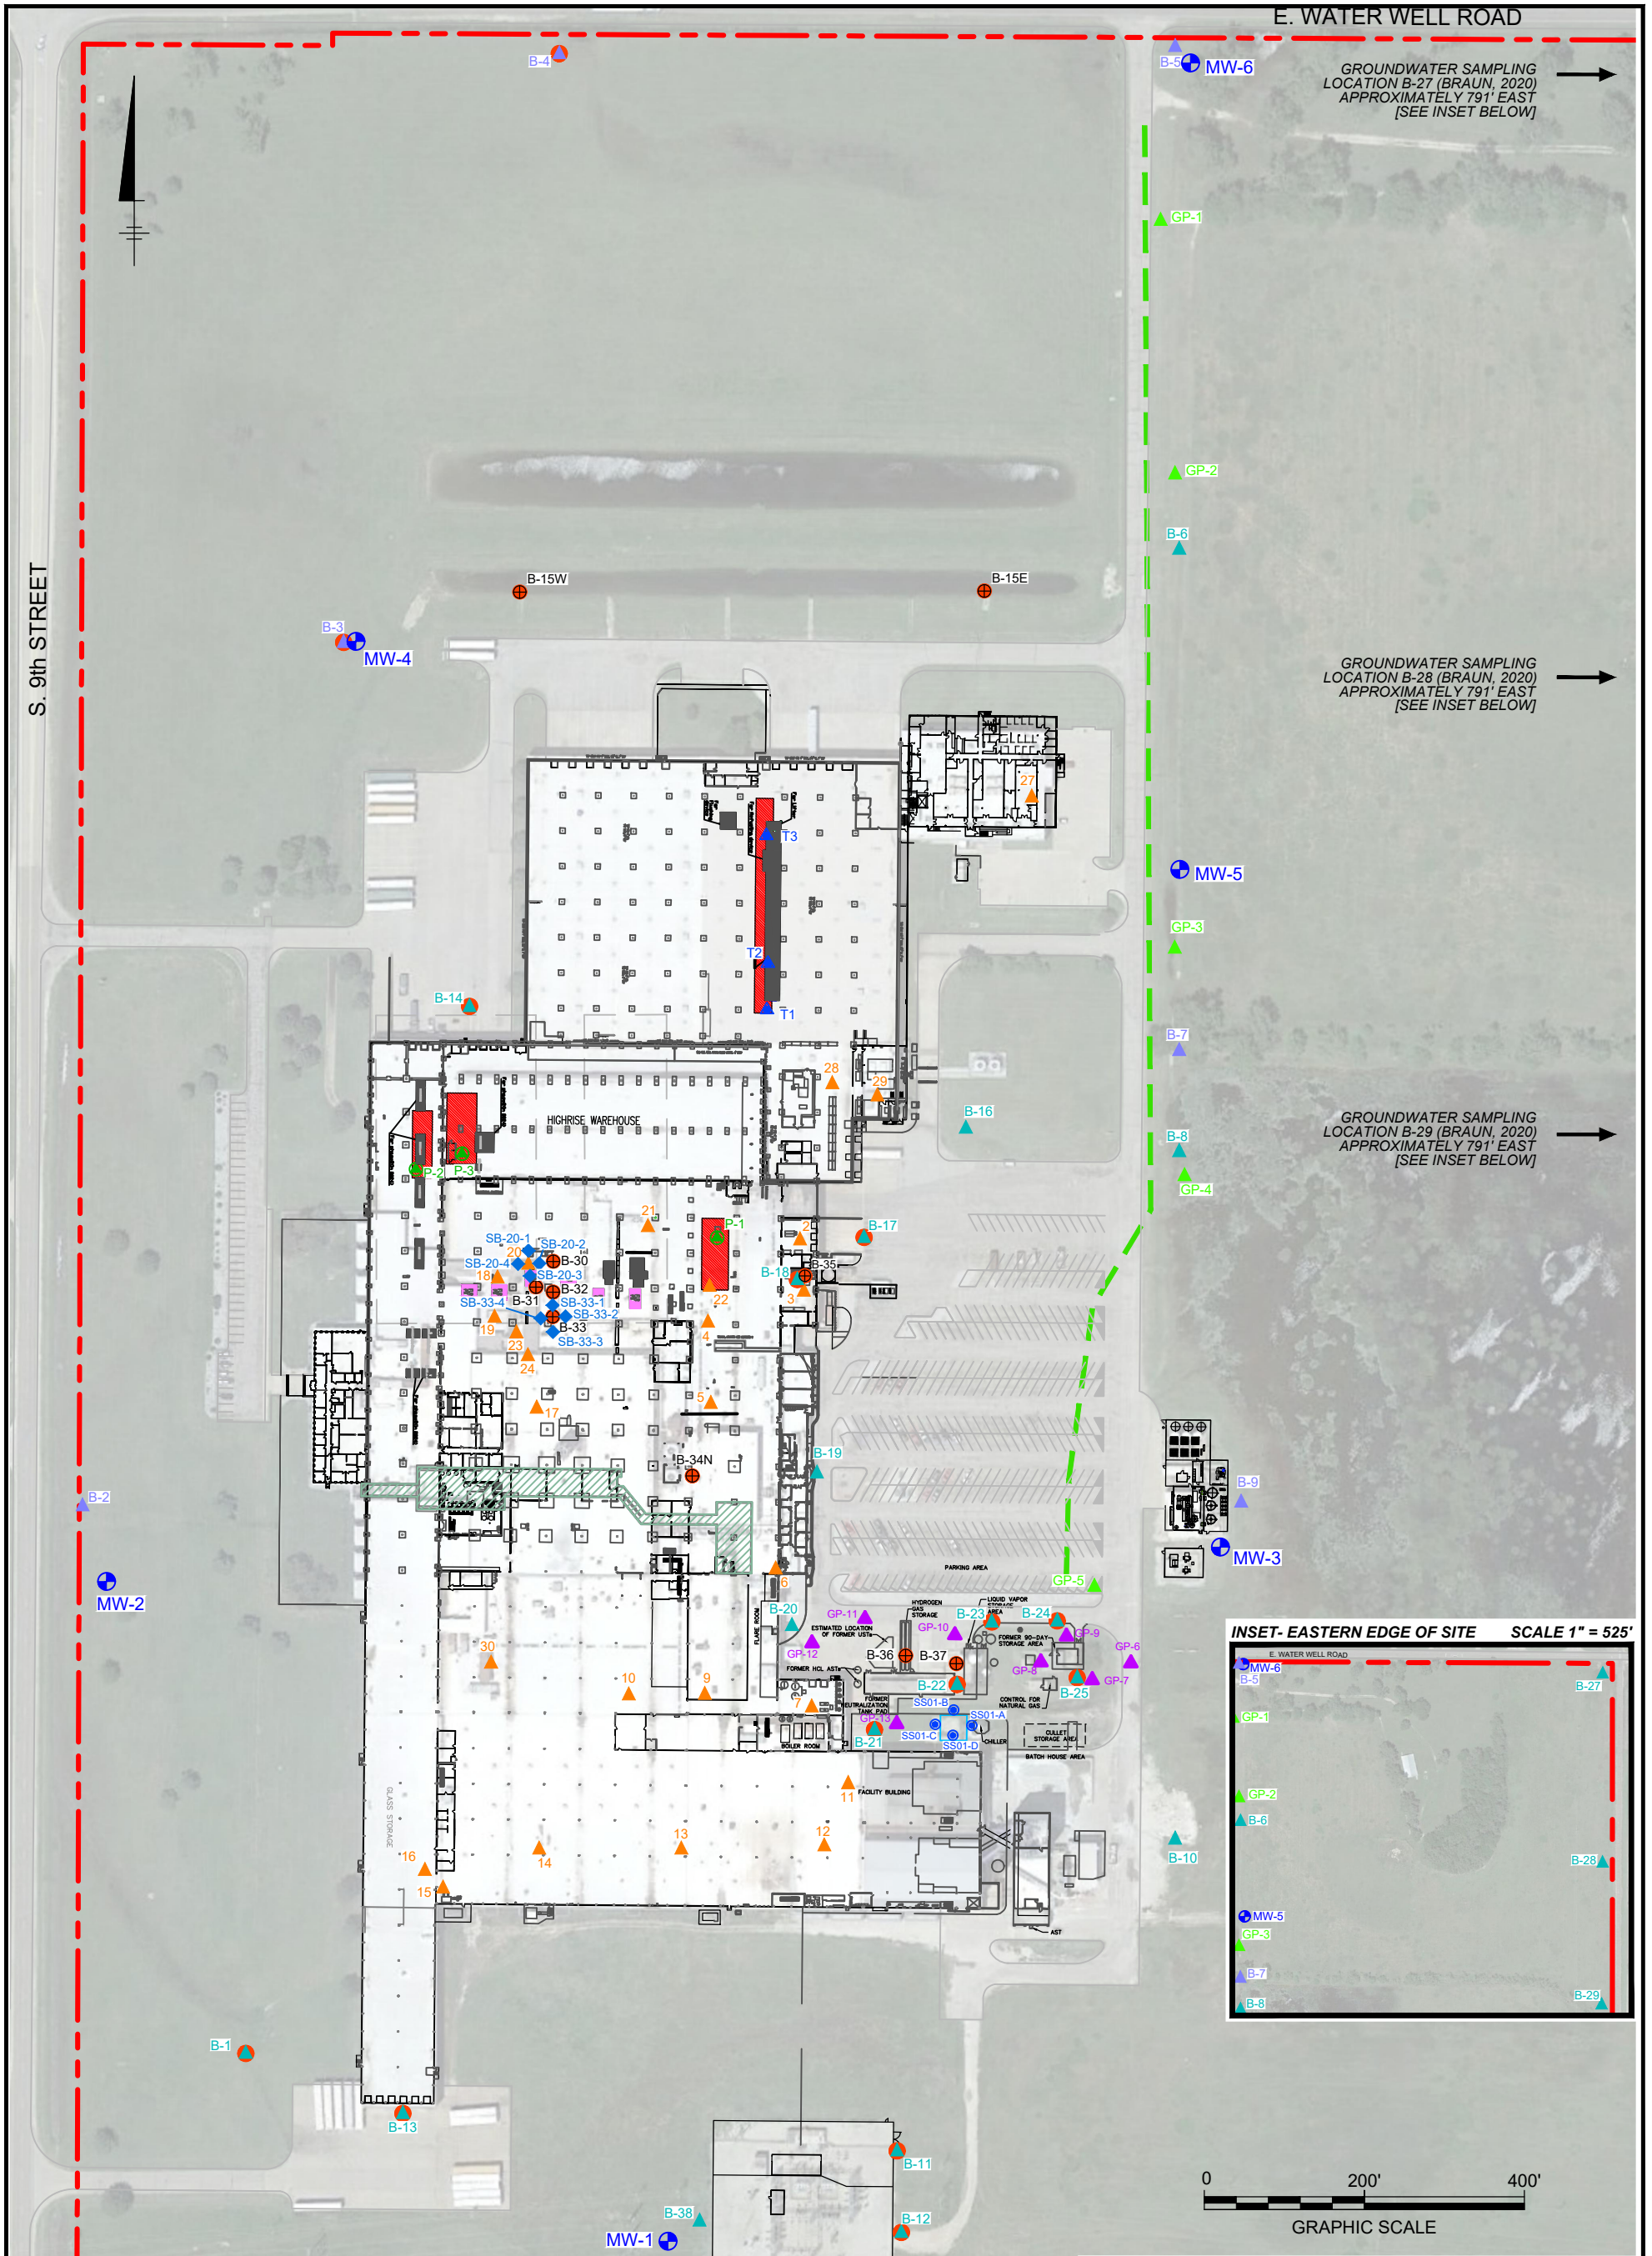


GROUNDWATER SAMPLING LOCATION B-27 (BRAUN, 2020) APPROXIMATELY 791' EAST [SEE INSET BELOW]

GROUNDWATER SAMPLING LOCATION B-28 (BRAUN, 2020) APPROXIMATELY 791' EAST [SEE INSET BELOW]

GROUNDWATER SAMPLING LOCATION B-29 (BRAUN, 2020) APPROXIMATELY 791' EAST [SEE INSET BELOW]

INSET - EASTERN EDGE OF SITE SCALE 1" = 525'

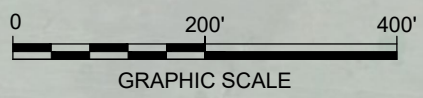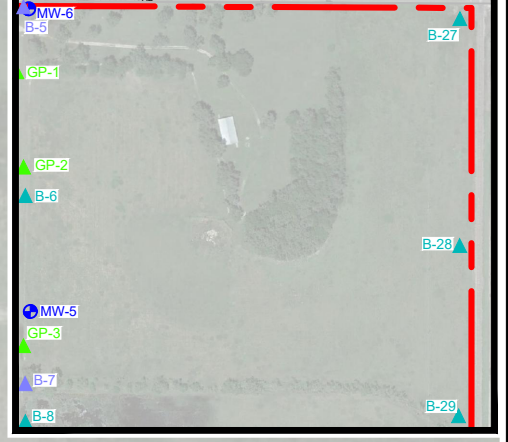

LEGEND:

- | | | | |
|---------------------------------|--|---|--|
| PROPERTY BOUNDARY | ARCADIS 2020 - SUB SLAB SOIL SAMPLING | SOIL BORING LOCATION (ARCADIS, 2021) | BRAUN 2020 - SUPPLEMENTAL PHASE II SAMPLING |
| APPROXIMATE SEWER MAIN LOCATION | TRENCH BORING LOCATION (ARCADIS, 2021) | SOIL SAMPLING LOCATION (BRAUN, 2020) | GROUNDWATER SAMPLING LOCATION (BRAUN, 2020) |
| BASEMENT | PIT SAMPLING LOCATION (ARCADIS, 2021) | GROUNDWATER SAMPLING LOCATION (BRAUN, 2020) | ARCADIS 2012 PHASE II SAMPLING |
| TRENCH LOCATIONS | BRAUN 2020 - PHASE II SAMPLING | SUBSURFACE SOIL SAMPLE, SEWER (ARCADIS, 2012) | SURFACE SOIL SAMPLE LOCATION (ARCADIS, 2012) |
| PIT LOCATIONS | GROUNDWATER SAMPLING LOCATION (BRAUN, 2020) | SOIL SAMPLE LOCATION (ARCADIS, 2012) | |
| MONITORING WELL LOCATIONS | SOIL AND GROUNDWATER SAMPLING LOCATION (BRAUN, 2020) | | |
| PROPOSED SOIL BORING | PIEZOMETER SAMPLING LOCATION (BRAUN, 2020) | | |

SIGNIFY NORTH AMERICA
 3861 S 9TH ST, SALINA, KS

SAMPLE LOCATIONS

