KOLAR Document ID: 1707759

WATER WELL RECORD (WWC-5)

KOLAR DOC ID

Correction

Lease Name & Well #:

Original Record

WELL ID_____ Change in Well Use

LOCATION OF WATER WELL

Latitude	Longitude	Section	Township	Range	E W	Fraction	1⁄4	1⁄4	1⁄4
Datum	Elevation	County							

WATER WELL OWNER

Name	
Business	
Address	
Well location	
at owner's address	
CONCERNICE	

CONSTRUCTION

Borehole interval:	Borehole diameter:
fromtoft.	in.
fromtoft.	in.
Casing height above land su	
If casing height is less th has a variance been app	
*variance not required for or environmental reme	
Casing type:	
Blank casing interval:	ft. toft.
Blank casing diameter:	in.
Casing joints:	
Weight:lbs	s/ft.
Wall thickness or gauge	no.:
Blank casing interval:	ft. toft.
Blank casing diameter:	
Casing joints:	
Weight:lbs	s/ft.
Wall thickness or gauge	
Grout interval: ft. to	oft.
Grout material:	
Grout interval: ft. to	oft.
Grout material:	
Screen / perforation material	:
Screen / perforation opening	gs:
Screen / perforation intervals	s:
Fromft. to	_ft.
Slot size unit	
Fromft. to	_ft.
Slot size unit	
Gravel pack intervals:	
Gravel pack not used:	Gravel size in
From ft. to	
Gravel pack not used:	
From ft. to	

WELL WATER USE

COMPLETION						
Depth of completed well:ft.						
Depth(s) groundwater encountered:						
(1) ft.; (2) ft.;						
(3) ft.; (4) dry well						
Static water level in well: ft.						
measured below land surface on (mm/dd/yy):						
measured above land surface on (mm/dd/yy):						
Estimated yield: gpm						
Water level was: ft. afterhours						
pumping gpm						
Pump installed? Yes No						
Water well disinfected? Yes No						
Date disinfected (mm/dd/yy):						

NEAREST SOURCE C	OF POTENTIAL CONTAMINATION
Source:	
Distance from well:	Direction from well:
Source description:	
Source:	
Distance from well:	Direction from well:
Source description:	
No potential so within 100 feet.	urce of contamination
PERMIT & ID NUME	BERS (AS REQUIRED)
DWR Application 1	No.:
	ct Code:
	Form Completed: Yes No
County Permit:	Yes No Permit ID:

of boreholes: _____ # of dewatering wells: _

Aquifer, if known:

LITHOLOGIC LOG


то	LITHOLOGY INTERVALS

COMMENTS

CONTRACTOR'S OR LANDOWNERS CERTIFICATION

This water well was constructed	reconstructed	pursuant to the stated water well
contractor's license and was completed	on	I certify that this record is true to
the best of my knowledge and belief. The	his water well reco	ord was completed on
under the business name of		,
Kansas Water Well Contractor's License	e No	_ under the authority of the designated
person as defined in K.A.R. 28-30-2(j)	and signed and co	ertified by the electronic signature of the
designated person at its submittal:		
Send one copy to WATER WELL OWNER and	d retain one for you	r records. Fee of \$5.00 for each constructed well
KANSAS DEPARTM	MENT OF HEALTH	AND ENVIRONMENT

Bureau of Water, Geology Section, 1000 SW Jackson St., Suite 420, Topeka KS 66612-1367 (785) 296-3565 | K.S.A. 82a-1212 | v2022c

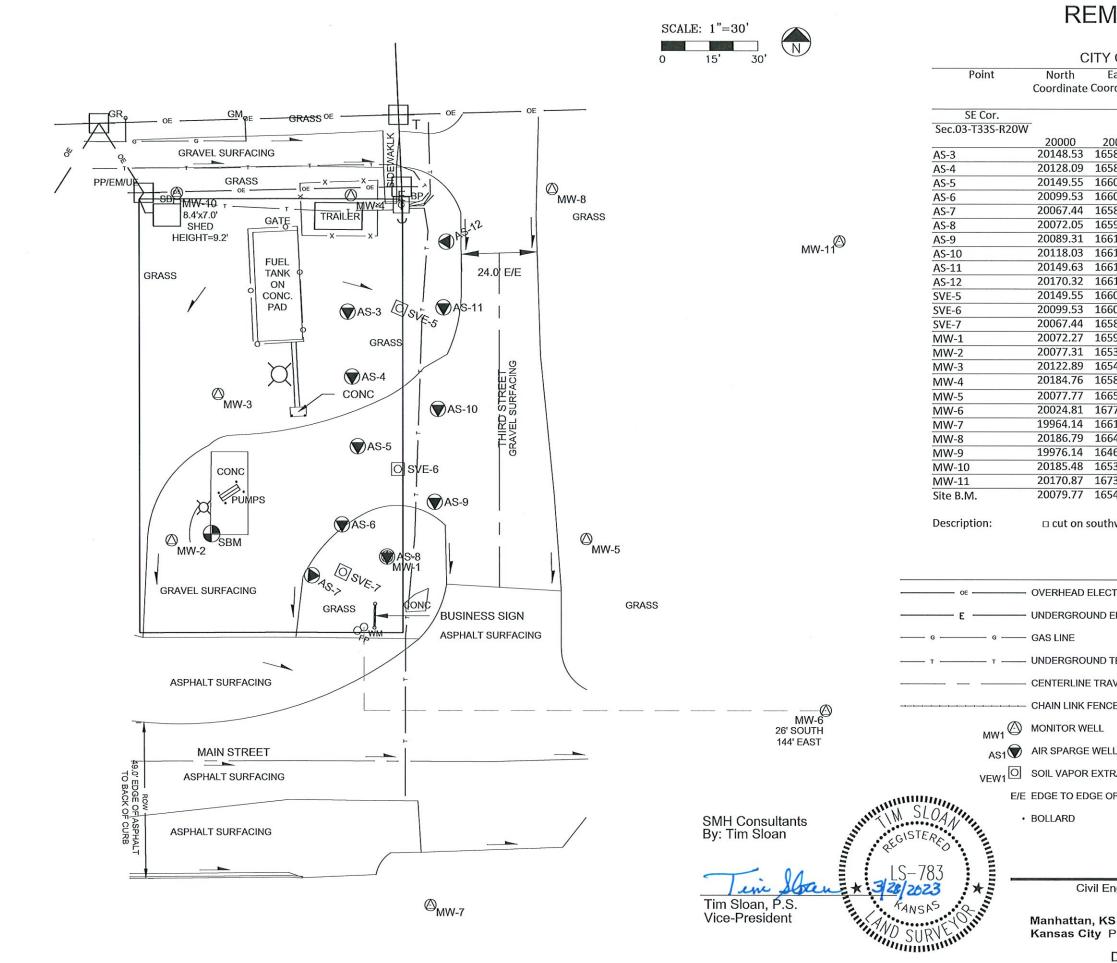

⊘ MW-9

		OITE			,	
MED	IAL S	SILE	SUR	VE,	Ý	
		RA CO-C				
			CO., KAN			
East ordinate		ce from			Fop Latitude	
orumate	North	Sec. 03 West	of Rim or PK Nail	OFPVC	Pipe North	West
	North	WESt	r ix ivali			
20000	4 4 0 5 0	044454	4500.40	4504	70 00 450 4	0.07.50070
5585.46	148.53	3414.54	1502.42	1501	-	
5586.83 5601.64	128.09 149.55	3413.17 3398.36	1501.69 1501.62	1500		
5601.04	99.53	3398.93	1501.02	1500		
5583.93	67.44	3416.07	1500.74	1500		
5597.11	72.05	3402.89	1500.48	1499		
5612.54	89.31	3387.46	1500.31	1499	61 39.4522	
5613.57	118.03	3386.43	1500.52	1499	.65 39.4523	
5615.30	149.63	3384.70	1501.26	1500	.32 39.4524	2 97.52969
5616.21	170.32	3383.79	1501.54	1500		8 97.52968
5601.64	149.55	3398.36	1501.62	1501		
5601.07	99.53	3398.93	1500.76	1500		
5583.93	67.44	3416.07	1500.74	1500		
5597.68	72.27	3402.32	1499.53	1499		
5530.58 5545.12	77.31 122.89	3469.42 3454.88	1502.74 1502.26	1502		
5586.49	184.76	3413.51	1502.20	1501		
5659.60	77.77	3340.40	1497.27	1496		
5775.01	24.81	3224.99	1493.97	1493		
5612.19	35.86 S	3387.81	1499.27	1498		
5649.02	186.79	3350.98	1500.06	1499.		
5466.57	23.86 S	3533.43	1502.01	1501		
5532.34	185.48	3467.66	1503.24	1502	85 39.4525	2 97.52997
5737.68	170.87	3262.32	1595.89	1595.	64 39.4524	8 97.52925
5543.29	79.77	3456.71	B.M. Elev.	= 1502	.07	
thwest co	orner of pu	ımp pad.				
	LEGEN	JD				
CTRIC LIN					SITE BENCHMA	ARK
DELECTRI					DRAINAGE DIR	
						ECHON
					POWER POLE	
) TELEPHO			PP/EN	NUE 🕀	& UNDERGROL	N/ ELECTRIC METE
RAVELWAY	ſ			в₽	BRACE POLE	
ICE				1	DEADMAN ANC	HOR
				T	LIGHT POLE	
ELL				• •	TELEPHONE PI	EDESTAL
TRACTION	WELL					
OF GRAVEL ROAD						
GM° GAS METER						
		VI		OIT	GASLINE RISEF	२
	(CONSUL	TANTS	wм°	WATER METER	8
Engineer				ndaca	e Architectur	
-ngineer	"'y • Là	and Ourve	ynng 👻 La	nusual	- Alonieoluli	0

Civil Engineering • Land Surveying • Landscape Architecture www.smhconsultants.com

Manhattan, KS - HQ P: (785) 776-0541 • Dodge City, KS P: (620) 255-1952 Kansas City P: (913) 444-9615 • Colorado Springs, CO P: (719) 428-8677

Drawn By:RJC Project #2302-0060 TDS #92