

WATER WELL RECORD (WWC-5)

KOLAR DOC ID _____ WELL ID _____
 Original Record Correction Change in Well Use

LOCATION OF WATER WELL

Latitude		Longitude		Section		Township		Range		E W	Fraction	¼	¼	¼
Datum		Elevation		County										

WATER WELL OWNER

Name	
Business	
Address	
Well location	
at owner's address	

WELL WATER USE

--

COMPLETION

Depth of completed well: _____ ft.
Depth(s) groundwater encountered:
(1) _____ ft.; (2) _____ ft.;
(3) _____ ft.; (4) dry well
Static water level in well: _____ ft.
measured below land surface
on (mm/dd/yy): _____
measured above land surface
on (mm/dd/yy): _____
Estimated yield: _____ gpm
Water level was: _____ ft. after _____ hours
pumping _____ gpm
Pump installed? Yes No
Water well disinfected? Yes No
Date disinfected (mm/dd/yy): _____
Aquifer, if known:

NEAREST SOURCE OF POTENTIAL CONTAMINATION

Source: _____
Distance from well: _____ Direction from well: _____
Source description: _____
Source: _____
Distance from well: _____ Direction from well: _____
Source description: _____
No potential source of contamination within 100 feet.

CONSTRUCTION

Borehole interval:	Borehole diameter:
from _____ to _____ ft.	_____ in.
from _____ to _____ ft.	_____ in.
Casing height above land surface: _____ in.	
If casing height is less than 12 in. has a variance been approved?*	
Yes No	
*variance not required for monitoring or environmental remediation wells	
Casing type: _____	
Blank casing interval: _____ ft. to _____ ft.	
Blank casing diameter: _____ in.	
Casing joints: _____	
Weight: _____ lbs/ft.	
Wall thickness or gauge no.: _____	
Blank casing interval: _____ ft. to _____ ft.	
Blank casing diameter: _____ in.	
Casing joints: _____	
Weight: _____ lbs/ft.	
Wall thickness or gauge no.: _____	
Grout interval: _____ ft. to _____ ft.	
Grout material: _____	
Grout interval: _____ ft. to _____ ft.	
Grout material: _____	
Screen / perforation material: _____	
Screen / perforation openings: _____	
Screen / perforation intervals:	
From _____ ft. to _____ ft.	
Slot size _____ unit _____	
From _____ ft. to _____ ft.	
Slot size _____ unit _____	
Gravel pack intervals:	
Gravel pack not used: Gravel size _____ in	
From _____ ft. to _____ ft.	
Gravel pack not used: Gravel size _____ in	
From _____ ft. to _____ ft.	

PERMIT & ID NUMBERS (AS REQUIRED)

DWR Application No.: _____
KDHE / EPA Project Code: _____
Site Name: _____
KDHE UIC Class V Form Completed: Yes No
County Permit: Yes No Permit ID: _____
Lease Name & Well #: _____
of boreholes: _____ # of dewatering wells: _____

LITHOLOGIC LOG

FROM	TO	LITHOLOGY INTERVALS

COMMENTS

--

CONTRACTOR'S OR LANDOWNERS CERTIFICATION

This water well was constructed reconstructed pursuant to the stated water well contractor's license and was completed on _____. I certify that this record is true to the best of my knowledge and belief. This water well record was completed on _____ under the business name of _____, Kansas Water Well Contractor's License No. _____ under the authority of the designated person as defined in K.A.R. 28-30-2(j) and signed and certified by the electronic signature of the designated person at its submittal: _____.


Send one copy to WATER WELL OWNER and retain one for your records. Fee of \$5.00 for each constructed well.

REMEDIAL SITE SURVEY

AURORA CO-OP

CITY OF AURORA, CLOUD CO., KANSAS

SCALE: 1"=30'
0 15' 30'

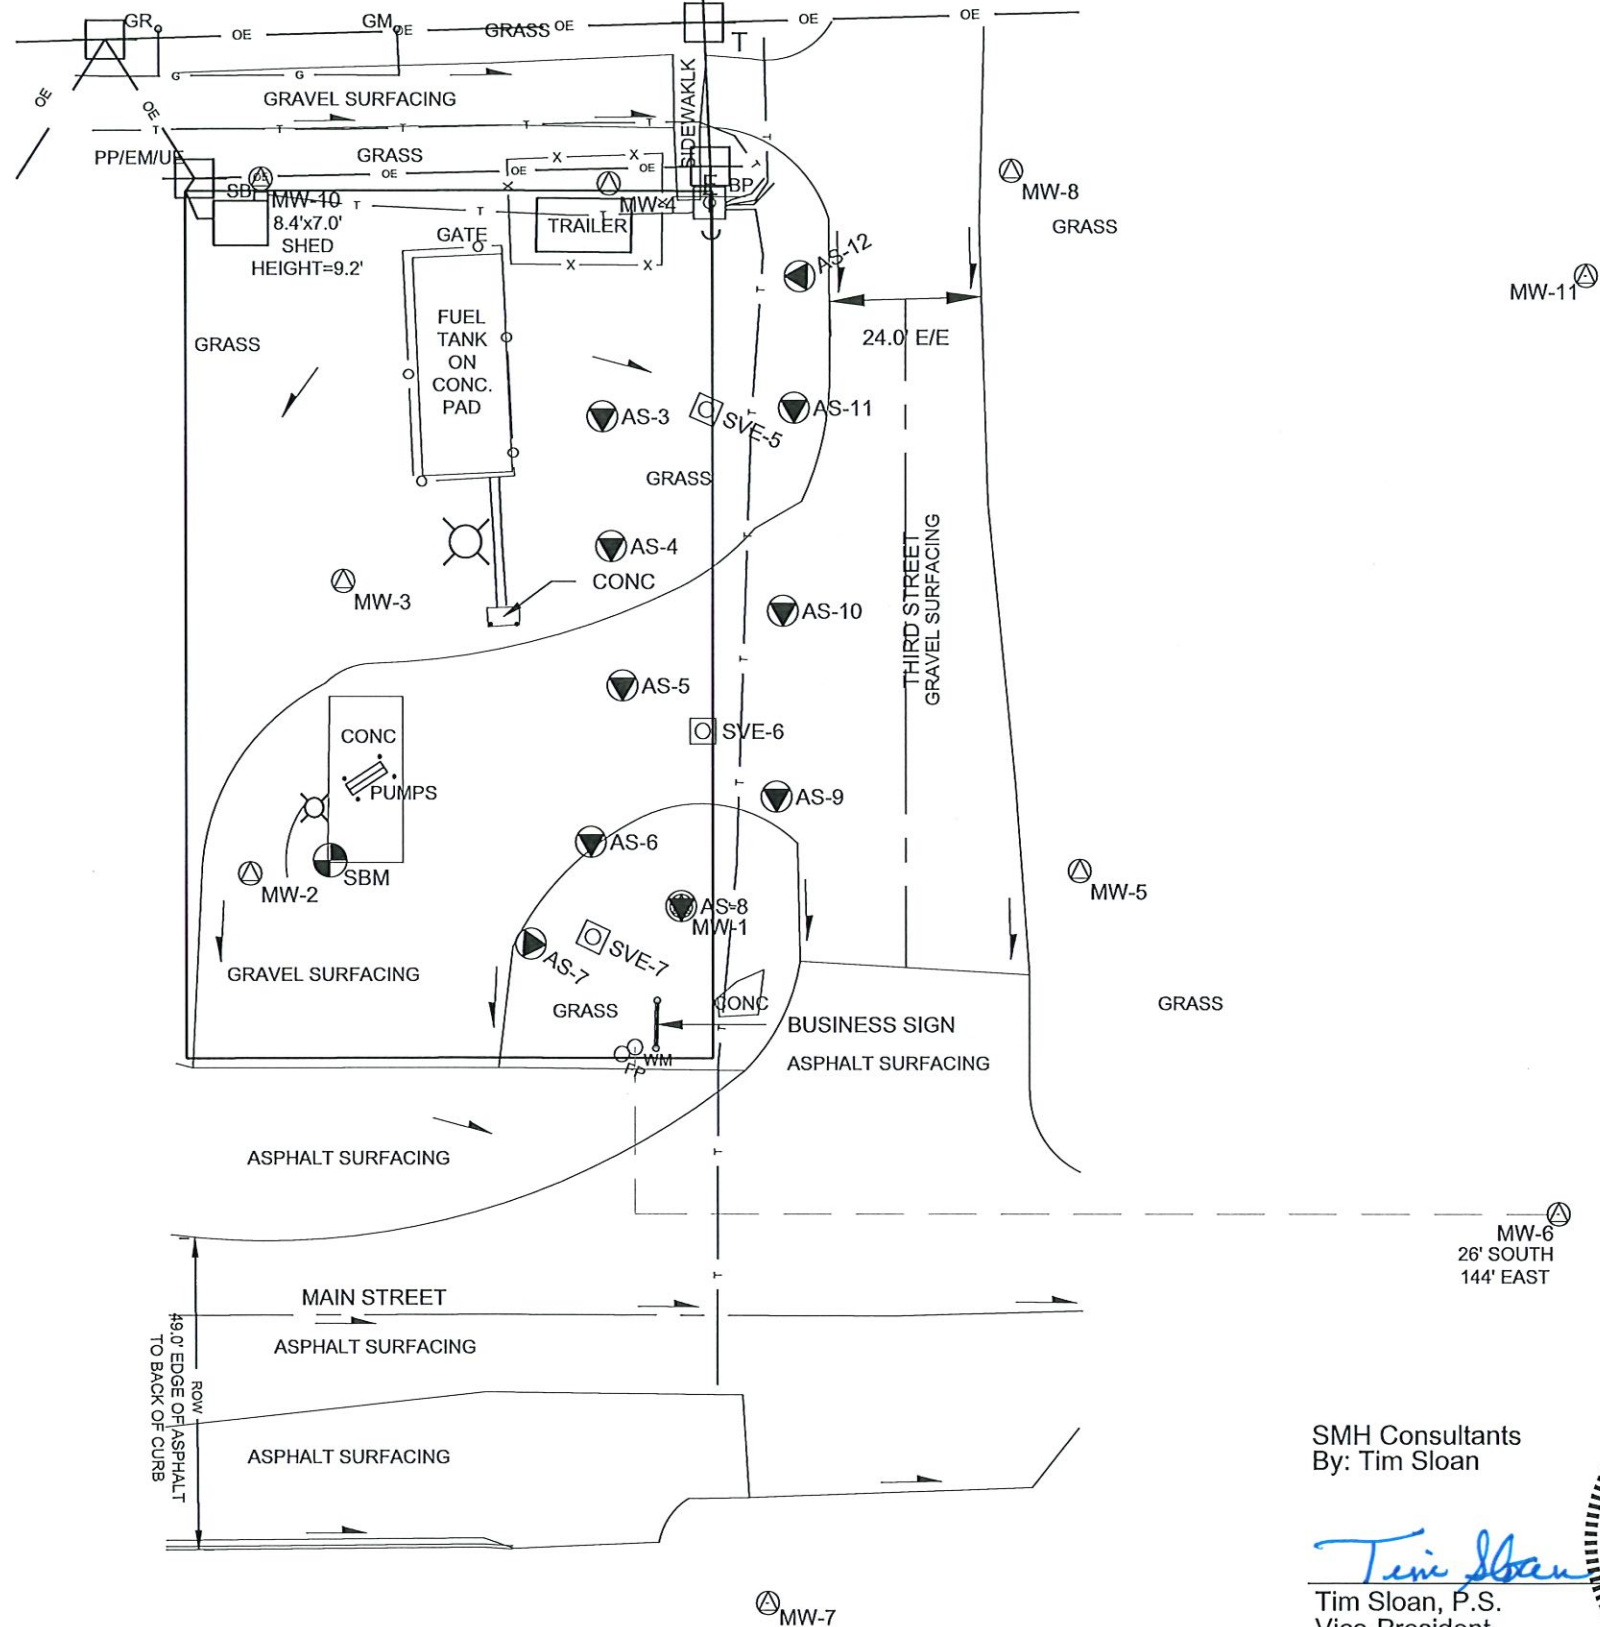

Point	North Coordinate	East Coordinate	Distance from SE Cor. Sec. 03		*Elev. Top of Rim or of PVC Pipe	Elev. Top of PVC Pipe	Latitude North	Longitude West
			North	West	PK Nail			
SE Cor. Sec.03-T33S-R20W								
	20000	20000						
AS-3	20148.53	16585.46	148.53	3414.54	1502.42	1501.78	39.45242	97.52979
AS-4	20128.09	16586.83	128.09	3413.17	1501.69	1500.97	39.45236	97.52979
AS-5	20149.55	16601.64	149.55	3398.36	1501.62	1501.09	39.45242	97.52973
AS-6	20099.53	16601.07	99.53	3398.93	1500.76	1500.09	39.45228	97.52974
AS-7	20067.44	16583.93	67.44	3416.07	1500.74	1500.16	39.45219	97.52983
AS-8	20072.05	16597.11	72.05	3402.89	1500.48	1499.82	39.45221	97.52975
AS-9	20089.31	16612.54	89.31	3387.46	1500.31	1499.61	39.45225	97.52970
AS-10	20118.03	16613.57	118.03	3386.43	1500.52	1499.65	39.45233	97.52969
AS-11	20149.63	16615.30	149.63	3384.70	1501.26	1500.32	39.45242	97.52969
AS-12	20170.32	16616.21	170.32	3383.79	1501.54	1500.45	39.45248	97.52968
SVE-5	20149.55	16601.64	149.55	3398.36	1501.62	1501.09	39.45242	97.52973
SVE-6	20099.53	16601.07	99.53	3398.93	1500.76	1500.09	39.45228	97.52974
SVE-7	20067.44	16583.93	67.44	3416.07	1500.74	1500.16	39.45219	97.52980
MW-1	20072.27	16597.68	72.27	3402.32	1499.53	1499.28	39.45221	97.52975
MW-2	20077.31	16530.58	77.31	3469.42	1502.74	1502.54	39.45222	97.52998
MW-3	20122.89	16545.12	122.89	3454.88	1502.26	1501.94	39.45235	97.52993
MW-4	20184.76	16586.49	184.76	3413.51	1502.50	1502.09	39.45252	97.52978
MW-5	20077.77	16659.60	77.77	3340.40	1497.27	1496.85	39.45222	97.52953
MW-6	20024.81	16775.01	24.81	3224.99	1493.97	1493.79	39.45208	97.52912
MW-7	19964.14	16612.19	35.86 S	3387.81	1499.27	1498.87	39.45191	97.52970
MW-8	20186.79	16649.02	186.79	3350.98	1500.06	1499.26	39.45252	97.52956
MW-9	19976.14	16466.57	23.86 S	3533.43	1502.01	1501.79	39.45195	97.53021
MW-10	20185.48	16532.34	185.48	3467.66	1503.24	1502.85	39.45252	97.52997
MW-11	20170.87	16737.68	170.87	3262.32	1595.89	1595.64	39.45248	97.52925
Site B.M.	20079.77	16543.29	79.77	3456.71	B.M. Elev. = 1502.07			

Description: □ cut on southwest corner of pump pad.

LEGEND

- OE — OVERHEAD ELECTRIC LINE
- E — UNDERGROUND ELECTRIC LINE
- G — GAS LINE
- T — UNDERGROUND TELEPHONE LINE
- — — CENTERLINE TRAVELWAY
- — — CHAIN LINK FENCE
- MW1 (triangle in circle) MONITOR WELL
- AS1 (inverted triangle) AIR SPARGE WELL
- VEW1 (square with circle) SOIL VAPOR EXTRACTION WELL
- E/E EDGE TO EDGE OF GRAVEL ROAD
- BOLLARD
- (circle with triangle) SITE BENCHMARK
- (arrow) DRAINAGE DIRECTION
- (square with cross) POWER POLE
- PP/EMUE (square with cross) POWER POLE W/ ELECTRIC METER & UNDERGROUND ELECTRIC
- BP (square with cross) BRACE POLE
- (vertical line with cross) DEADMAN ANCHOR
- (X) LIGHT POLE
- (square with circle) TELEPHONE PEDESTAL
- SB (square with circle) TELEPHONE SPLICE BOX
- GM (circle with cross) GAS METER
- GR (circle with cross) GASLINE RISER
- WM (circle with cross) WATER METER

SMH Consultants
By: Tim Sloan

Tim Sloan
Tim Sloan, P.S.
Vice-President



Civil Engineering • Land Surveying • Landscape Architecture
www.smhconsultants.com
Manhattan, KS - HQ P: (785) 776-0541 • Dodge City, KS P: (620) 255-1952
Kansas City P: (913) 444-9615 • Colorado Springs, CO P: (719) 428-8677

Drawn By:RJC Project #2302-0060 TDS #92