WELL ID


KOLAR DOC ID

Bureau of Water, Geology Section, 1000 SW Jackson St., Suite 420, Topeka KS 66612-1367 (785) 296-3565 | K.S.A. 82a-1212 | v2022c

WATER WELL RECORD (WWC-5)

From _____ ft. to _____ ft.

Latitude Longitude Section Township Range E Fraction 14 14 14 Datum Elevation County WELL WATER WELL OWNER Name Business WELL WATER WES NEAREST SOURCE OF POTENTIAL CONTAMINATION Residences Direction From well: Direction Depth of completed well: Let E. Depth of prompleted well: Direction Depth of completed well: Source Distance Direction Trom well: Source Distance Distance Direction Trom well: Source Distance Distance Direction Trom well: Source Distance	LOCATION OF WATER W	ELL				C	Original Reco	rd Correction	Chang	e in Wel	ll Use
### WELL WATER USE SOURCE Distance from well: Source General from well: Source Dustance In from well: Source description: No potential source of contamination within 100 foot. WELL WATER USE Distance University From In	Latitude			Section		Township	Range	E Fraction	1/4	1/4	1/4
WELL WATER USE WEAREST SOURCE OF POTENTIAL CONTAMINATION Source Depth of completed well: Depth of completed in completed in completed on to mindfully yell well well well: Depth of completed in completed on to mindfully yell well well well well well well w	Datum	-		County		•		VV			
Business COMPLETION Depth of completed well:	WATER WELL OWNER		WE	,	SE			NEAREST SOURCE OF P	OTENTIAL C	ONTAMIN	IATION
COMPLETION Depth of completed well: Depth of											
Depth of completed well:				MPI FTION				max			
Depth(s) groundwater encountered: (1)ft: (2)ft: (3) _ft: (4) dry well	Dusiness							from well:	_ from wel	l:	
Static water level in well: Static water level in well: fi. measured below land surface on (mm/dd/yy): measured above land surface min. min	Address			-			ft.				
Static water level in well: fit measured below land surface on (mm/dd/yy): measured below land surface on (mm/dd/yy): measured below land surface on (mm/dd/yy): measured showe land surface on			(1	(1) ft.; (2) ft.;				Source:			
Static water level in well:	Well location									n l:	
measured above land surface on fin. fromtoftin. Casing height above land surface:in. If casing height is less than 12 in. fromtoftin. Casing height above land surface:in. If casing height above land surface:in. Casing joints:				measured below land surface				Source			
From to ft. in. from the from ft. fr	CONSTRUCTION			measured a	bove l	and surface		No potential source within 100 feet.	of contami	nation	
From			meter:	on (mm/dd/yy):				PERMIT & ID NUMBERS (AS REQUIRED)			
Casing height above land surface:			-	timated yield	l:	gpm					
Pump installed? Yes No	fromtoftin.			Water level was: ft. afterhours							
Mater well disinfected? Yes No No Variance been approved?* Yes No Variance not required for monitoring or environmental remediation wells	Casing height above land surface:in.							·			
Water well disinfected? Yes No Date disinfecte				Pump installed? Yes No							
or environmental remediation wells Casing type: Casing type:	**			Water well disinfected? Yes No				_			
Aquifer, if known: # of boreholes: # of dewatering wells: # of dewatering wells: # of dewatering wells: # of boreholes: # of dewatering wells: # of boreholes: # of dewatering wells: # of dewatering wells: # of boreholes: # of dewatering wells: # of boreholes: # of dewatering wells: # of boreholes: # of dewatering wells: # of dewatering wells: # of boreholes: # of dewatering wells: # of dewatering wells: # of breholes: # of dewatering wells: # of dewatering wells: # of breholes: # of dewatering wells: # of dewate				Date disinfected (mm/dd/yy):							
Casing interval: in. in. in. ITHOLOGIC LOG	Casing type:			.c .c1							- 1
Casing joints: Weight:lbs/ft. Wall thickness or gauge no.: Blank casing interval:ft. toft. Blank casing diameter:in. Casing joints: Weight:lbs/ft. Wall thickness or gauge no.: Grout interval:ft. toft. Grout material: Grout material: Screen / perforation openings: Screen / perforation intervals: Fromft. toft. Slot sizeunit Fromft. toft. Slot sizeunit Gravel pack intervals: Gravel pack intervals: Fromft. toft. Slot sizeunit Slo	_										
Weight:lbs/ft. Wall thickness or gauge no.: Blank casing interval:											
Wall thickness or gauge no: Blank casing interval: If. toft. Blank casing diameter:in. Casing joints: Weight:lbs/ft. Wall thickness or gauge no: Grout interval: If. toft. Grout material: Grout material: Grout material: Screen / perforation openings: Screen / perforation intervals: Fromft. toft. Slot size unit Fromft. toft. Slot size unit Gravel pack intervals: Gravel pack intervals: Gravel pack intervals: Blank casing interval: If. toft. Comments COMMENTS COMMENTS COMMENTS CONTRACTOR'S OR LANDOWNERS CERTIFICATION This water well was constructed pursuant to the stated water well contractor's license and was completed on I certify that this record is true to the best of my knowledge and belief. This water well record was completed on Kansas Water Well Contractor's License No under the authority of the designated on, as water well contractor's License No under the authority of the designated on, as water well contractor's License No under the authority of the designated on, as water well contractor's License No under the authority of the designated on, as water well contractor's License No under the authority of the designated on, as water well contractor's License No under the authority of the designated on, as water well contractor's License No under the authority of the designated on, as water well contractor's License No under the authority of the designated on, as water well contractor's License No under the authority of the designation of the, as water well contractor's License No under the authority of the designation of the, as water well contractor's License No under the authority of the, as water well contractor's License No under the authority of the, as water well well contractor's License No			 	ROM 10	٠	LITHOLOGY IN	TERVALS				
Blank casing interval:ft. toft. Blank casing diameter:in. Casing joints: Weight:lbs/ft. Wall thickness or gauge no: Grout interval:ft. toft. Grout material: Grout material: Screen / perforation material: Screen / perforation intervals: Fromft. toft. Slot size unit Fromft. toft. Slot size unit Gravel pack intervals:											
Blank casing diameter:in. Casing joints: Weight:lbs/ft. Wall thickness or gauge no.: Grout interval: ft. to ft. Grout material: Grout material: Screen / perforation material: Screen / perforation openings: From ft. to ft. Slot size unit From ft. to ft. Slot size unit Gravel pack intervals: Gravel pack intervals: Gravel pack intervals: Gravel pack intervals: Weight:lbs/ft. Wall thickness or gauge no.: COMMENTS COMMENTS COMMENTS COMMENTS CONTRACTOR'S OR LANDOWNERS CERTIFICATION This water well was constructed pursuant to the stated water well contractor's license and was completed on I certify that this record is true to the best of my knowledge and belief. This water well record was completed on under the business name of, Kansas Water Well Contractor's License No under the authority of the designated person as defined in K A R 28-30-2(i) and signed and certified by the electronic signature of the least of the person as defined in K A R 28-30-2(i) and signed and certified by the electronic signature of the least of the le											
Casing joints: Weight:lbs/ft. Wall thickness or gauge no: Grout interval:ft. toft. Grout material: Grout material: Comments Commen	_										
Weight:lbs/ft. Wall thickness or gauge no.: Grout interval:ft. toft. Grout material: Grout material: Screen / perforation openings: Screen / perforation intervals: Fromft. toft. Slot sizeunit Fromft. toft. Slot sizeunit Gravel pack intervals: Gravel pack intervals: CONTRACTOR'S OR LANDOWNERS CERTIFICATION This water well was constructedreconstructed pursuant to the stated water well contractor's license and was completed on I certify that this record is true to the best of my knowledge and belief. This water well record was completed on under the business name of, Kansas Water Well Contractor's License No under the authority of the designated person as defined in K. A. R. 28-30-2(i) and signed and certified by the electronic signature of the person as defined in K. A. R. 28-30-2(i) and signed and certified by the electronic signature of the person as defined in K. A. R. 28-30-2(i) and signed and certified by the electronic signature of the person as defined in K. A. R. 28-30-2(i) and signed and certified by the electronic signature of the person as defined in K. A. R. 28-30-2(i) and signed and certified by the electronic signature of the person as defined in K. A. R. 28-30-2(i) and signed and certified by the electronic signature of the person as defined in K. A. R. 28-30-2(i) and signed and certified by the electronic signature of the person as defined in K. A. R. 28-30-2(i) and signed and certified by the electronic signature of the person as defined in K. A. R. 28-30-2(i) and signed and certified by the electronic signature of the person as defined in K. A. R. 28-30-2(i) and signed and certified by the electronic signature of the person as defined in K. A. R. 28-30-2(i) and signed and certified by the electronic signature of the person as defined in K. A. R. 28-30-2(i) and signed and certified by the electronic signature of the person as defined in K. A. R. 28-30-2(i) and signed a											
Grout interval:ft. toft. Grout material: Grout material: Grout material: Screen / perforation material: Screen / perforation openings: Screen / perforation intervals: Fromft. toft. Slot size unit Fromft. toft. Slot size unit Gravel pack intervals: Gravel pack intervals:											
Grout interval: ft. to ft. Grout material: COMMENTS COMMENTS COMMENTS COMMENTS COMMENTS COMMENTS CONTRACTOR'S OR LANDOWNERS CERTIFICATION This water well was constructed pursuant to the stated water well contractor's license and was completed on I certify that this record is true to the best of my knowledge and belief. This water well record was completed on Where the business name of I certify that this record is true to the best of my knowledge and belief. This water well record was completed on Where the business name of I certify that this record is true to the best of my knowledge and belief. This water well record was completed on Where the business name of Where the preson as defined in K. A. R. 28-30-2(i) and signed and certified by the electronic signature of the preson as defined in K. A. R. 28-30-2(i) and signed and certified by the electronic signature of the preson as defined in K. A. R. 28-30-2(i) and signed and certified by the electronic signature of the preson as defined in K. A. R. 28-30-2(i) and signed and certified by the electronic signature of the preson as defined in K. A. R. 28-30-2(i) and signed and certified by the electronic signature of the preson as defined in K. A. R. 28-30-2(i) and signed and certified by the electronic signature of the preson as defined in K. A. R. 28-30-2(i) and signed and certified by the electronic signature of the preson as defined in K. A. R. 28-30-2(i) and signed and certified by the electronic signature of the preson as defined in K. A. R. 28-30-2(i) and signed and certified by the electronic signature of the preson as defined in K. A. R. 28-30-2(i) and signed and certified by the electronic signature of the preson as defined in K. A. R. 28-30-2(i) and signed and certified by the electronic signature of the preson as defined in K. A. R. 28-30-2(i) and signed and certified by the electronic signature of the preson as defined in K. A. R. 28-30-2(i) and signed and certifie	Wall thickness or gau	ge no.:									
Grout interval: ft. to ft. Grout material: COMMENTS COMMENTS COMMENTS COMMENTS COMMENTS COMMENTS CONTRACTOR'S OR LANDOWNERS CERTIFICATION Screen / perforation openings: CONTRACTOR'S OR LANDOWNERS CERTIFICATION This water well was constructed pursuant to the stated water well contractor's license and was completed on I certify that this record is true to the best of my knowledge and belief. This water well record was completed on Was as water Well Contractor's License No under the authority of the designated person as defined in K. A. R. 28-30-2(i) and signed and certified by the electronic signature of the person as defined in K. A. R. 28-30-2(i) and signed and certified by the electronic signature of the person as defined in K. A. R. 28-30-2(i) and signed and certified by the electronic signature of the person as defined in K. A. R. 28-30-2(i) and signed and certified by the electronic signature of the person as defined in K. A. R. 28-30-2(i) and signed and certified by the electronic signature of the person as defined in K. A. R. 28-30-2(i) and signed and certified by the electronic signature of the person as defined in K. A. R. 28-30-2(i) and signed and certified by the electronic signature of the person as defined in K. A. R. 28-30-2(i) and Grout material: Screen / perforation material:											
CONTRACTOR'S OR LANDOWNERS CERTIFICATION Screen / perforation intervals: Fromft. toft. Slot size unit Fromft. toft. Slot size unit Gravel pack intervals: CONTRACTOR'S OR LANDOWNERS CERTIFICATION This water well was constructed reconstructed pursuant to the stated water well contractor's license and was completed on I certify that this record is true to the best of my knowledge and belief. This water well record was completed on under the business name of Kansas Water Well Contractor's License No under the authority of the designated person as defined in K. A. R. 28-30-2(i) and signed and certified by the electronic signature of the person as defined in K. A. R. 28-30-2(i) and signed and certified by the electronic signature of the person as defined in K. A. R. 28-30-2(i) and signed and certified by the electronic signature of the person as defined in K. A. R. 28-30-2(i) and signed and certified by the electronic signature of the person as defined in K. A. R. 28-30-2(i) and signed and certified by the electronic signature of the person as defined in K. A. R. 28-30-2(i) and signed and certified by the electronic signature of the person as defined in K. A. R. 28-30-2(i) and signed and certified by the electronic signature of the person as defined in K. A. R. 28-30-2(i) and signed and certified by the electronic signature of the person as defined in K. A. R. 28-30-2(i) and signed and certified by the electronic signature of the person as defined in K. A. R. 28-30-2(i) and signed and certified by the electronic signature of the person as defined in K. A. R. 28-30-2(i) and signed and certified by the electronic signature of the person as defined in K. A. R. 28-30-2(i) and signed and certified by the electronic signature of the person as defined in K. A. R. 28-30-2(i) and signed and certified by the electronic signature of the person as defined in K. A. R. 28-30-2(i) and signed and certified by the electronic signature of the person as defined in	Grout material:		CO	MMENTS							
CONTRACTOR'S OR LANDOWNERS CERTIFICATION Screen / perforation intervals: Fromft. toft. Slot size unit Fromft. toft. Slot size unit Gravel pack intervals: CONTRACTOR'S OR LANDOWNERS CERTIFICATION This water well was constructed reconstructed pursuant to the stated water well contractor's license and was completed on I certify that this record is true to the best of my knowledge and belief. This water well record was completed on under the business name of Kansas Water Well Contractor's License No under the authority of the designated person as defined in K. A. R. 28-30-2(i) and signed and certified by the electronic signature of the person as defined in K. A. R. 28-30-2(i) and signed and certified by the electronic signature of the person as defined in K. A. R. 28-30-2(i) and signed and certified by the electronic signature of the person as defined in K. A. R. 28-30-2(i) and signed and certified by the electronic signature of the person as defined in K. A. R. 28-30-2(i) and signed and certified by the electronic signature of the person as defined in K. A. R. 28-30-2(i) and signed and certified by the electronic signature of the person as defined in K. A. R. 28-30-2(i) and signed and certified by the electronic signature of the person as defined in K. A. R. 28-30-2(i) and signed and certified by the electronic signature of the person as defined in K. A. R. 28-30-2(i) and signed and certified by the electronic signature of the person as defined in K. A. R. 28-30-2(i) and signed and certified by the electronic signature of the person as defined in K. A. R. 28-30-2(i) and signed and certified by the electronic signature of the person as defined in K. A. R. 28-30-2(i) and signed and certified by the electronic signature of the person as defined in K. A. R. 28-30-2(i) and signed and certified by the electronic signature of the person as defined in K. A. R. 28-30-2(i) and signed and certified by the electronic signature of the person as defined in	Screen / perforation mater	rial									
Screen / perforation intervals: Fromft. toft. Slot sizeunit Slot sizeunit Gravel pack intervals: This water well was constructed reconstructed pursuant to the stated water well contractor's license and was completed on I certify that this record is true to the best of my knowledge and belief. This water well record was completed on under the business name of Kansas Water Well Contractor's License No under the authority of the designated person as defined in K. A. R. 28-30-2(i) and signed and certified by the electronic signature of the line.				NTRACTOR'	S OR	LANDOWNFRS	CERTIFICATION				
Fromft. toft. Slot size unit Fromft. toft. Slot size unit Slot size unit Gravel pack intervals: Contractor's license and was completed on I certify that this record is true to the best of my knowledge and belief. This water well record was completed on under the business name of, Kansas Water Well Contractor's License No under the authority of the designated person as defined in K. A. R. 28-30-2(i) and signed and certified by the electronic signature of the									he stated w	ater well	
Slot size unit the best of my knowledge and belief. This water well record was completed on under the business name of , Slot size unit Gravel pack intervals: Slot size unit unit	-							•			
Fromft. toft. Slot sizeunit Gravel pack intervals: Where the business name of, where the authority of the designated of the person as defined in K. A. R. 28–30-2(i) and signed and certified by the electronic signature of the person as defined in K. A. R. 28–30-2(i) and signed and certified by the electronic signature of the person as defined in K. A. R. 28–30-2(i) and signed and certified by the electronic signature of the person as defined in K. A. R. 28–30-2(i) and signed and certified by the electronic signature of the person as defined in K. A. R. 28–30-2(i) and signed and certified by the electronic signature of the person as defined in K. A. R. 28–30-2(i) and signed and certified by the electronic signature of the person as defined in K. A. R. 28–30-2(i) and signed and certified by the electronic signature of the person as defined in K. A. R. 28–30-2(i) and signed and certified by the electronic signature of the person as defined in K. A. R. 28–30-2(i) and signed and certified by the electronic signature of the person as defined in K. A. R. 28–30-2(i) and signed and certified by the electronic signature of the Slot size unit, Gravel pack intervals: Kansas Water Well Contractor's License No under the authority of the designated person as defined in K. A. R. 28-30-2(i) and signed and certified by the electronic signature of the						_		_			-
Gravel pack intervals: Kansas Water Well Contractor's License No under the authority of the designated											
Gravel pack not used: Gravel size in person as defined in K.A.R. 28-30-2(j) and signed and certified by the electronic signature of the	Gravel pack intervals:								-	_	
•	Gravel pack not used:	Gravel size	in -					d and certified by the el	ectronic sig	gnature o	t the
Fromft. toft. designated person at its submittal:	From ft. to	ft.						·			
Gravel pack not used: Gravel sizein Send one copy to WATER WELL OWNER and retain one for your records. Fee of \$5.00 for each constructed well. KANSAS DEPARTMENT OF HEALTH AND ENVIRONMENT	Gravel pack not used:	Gravel size _	in Ser	d one copy to	WAT			•		constructe	ed well.

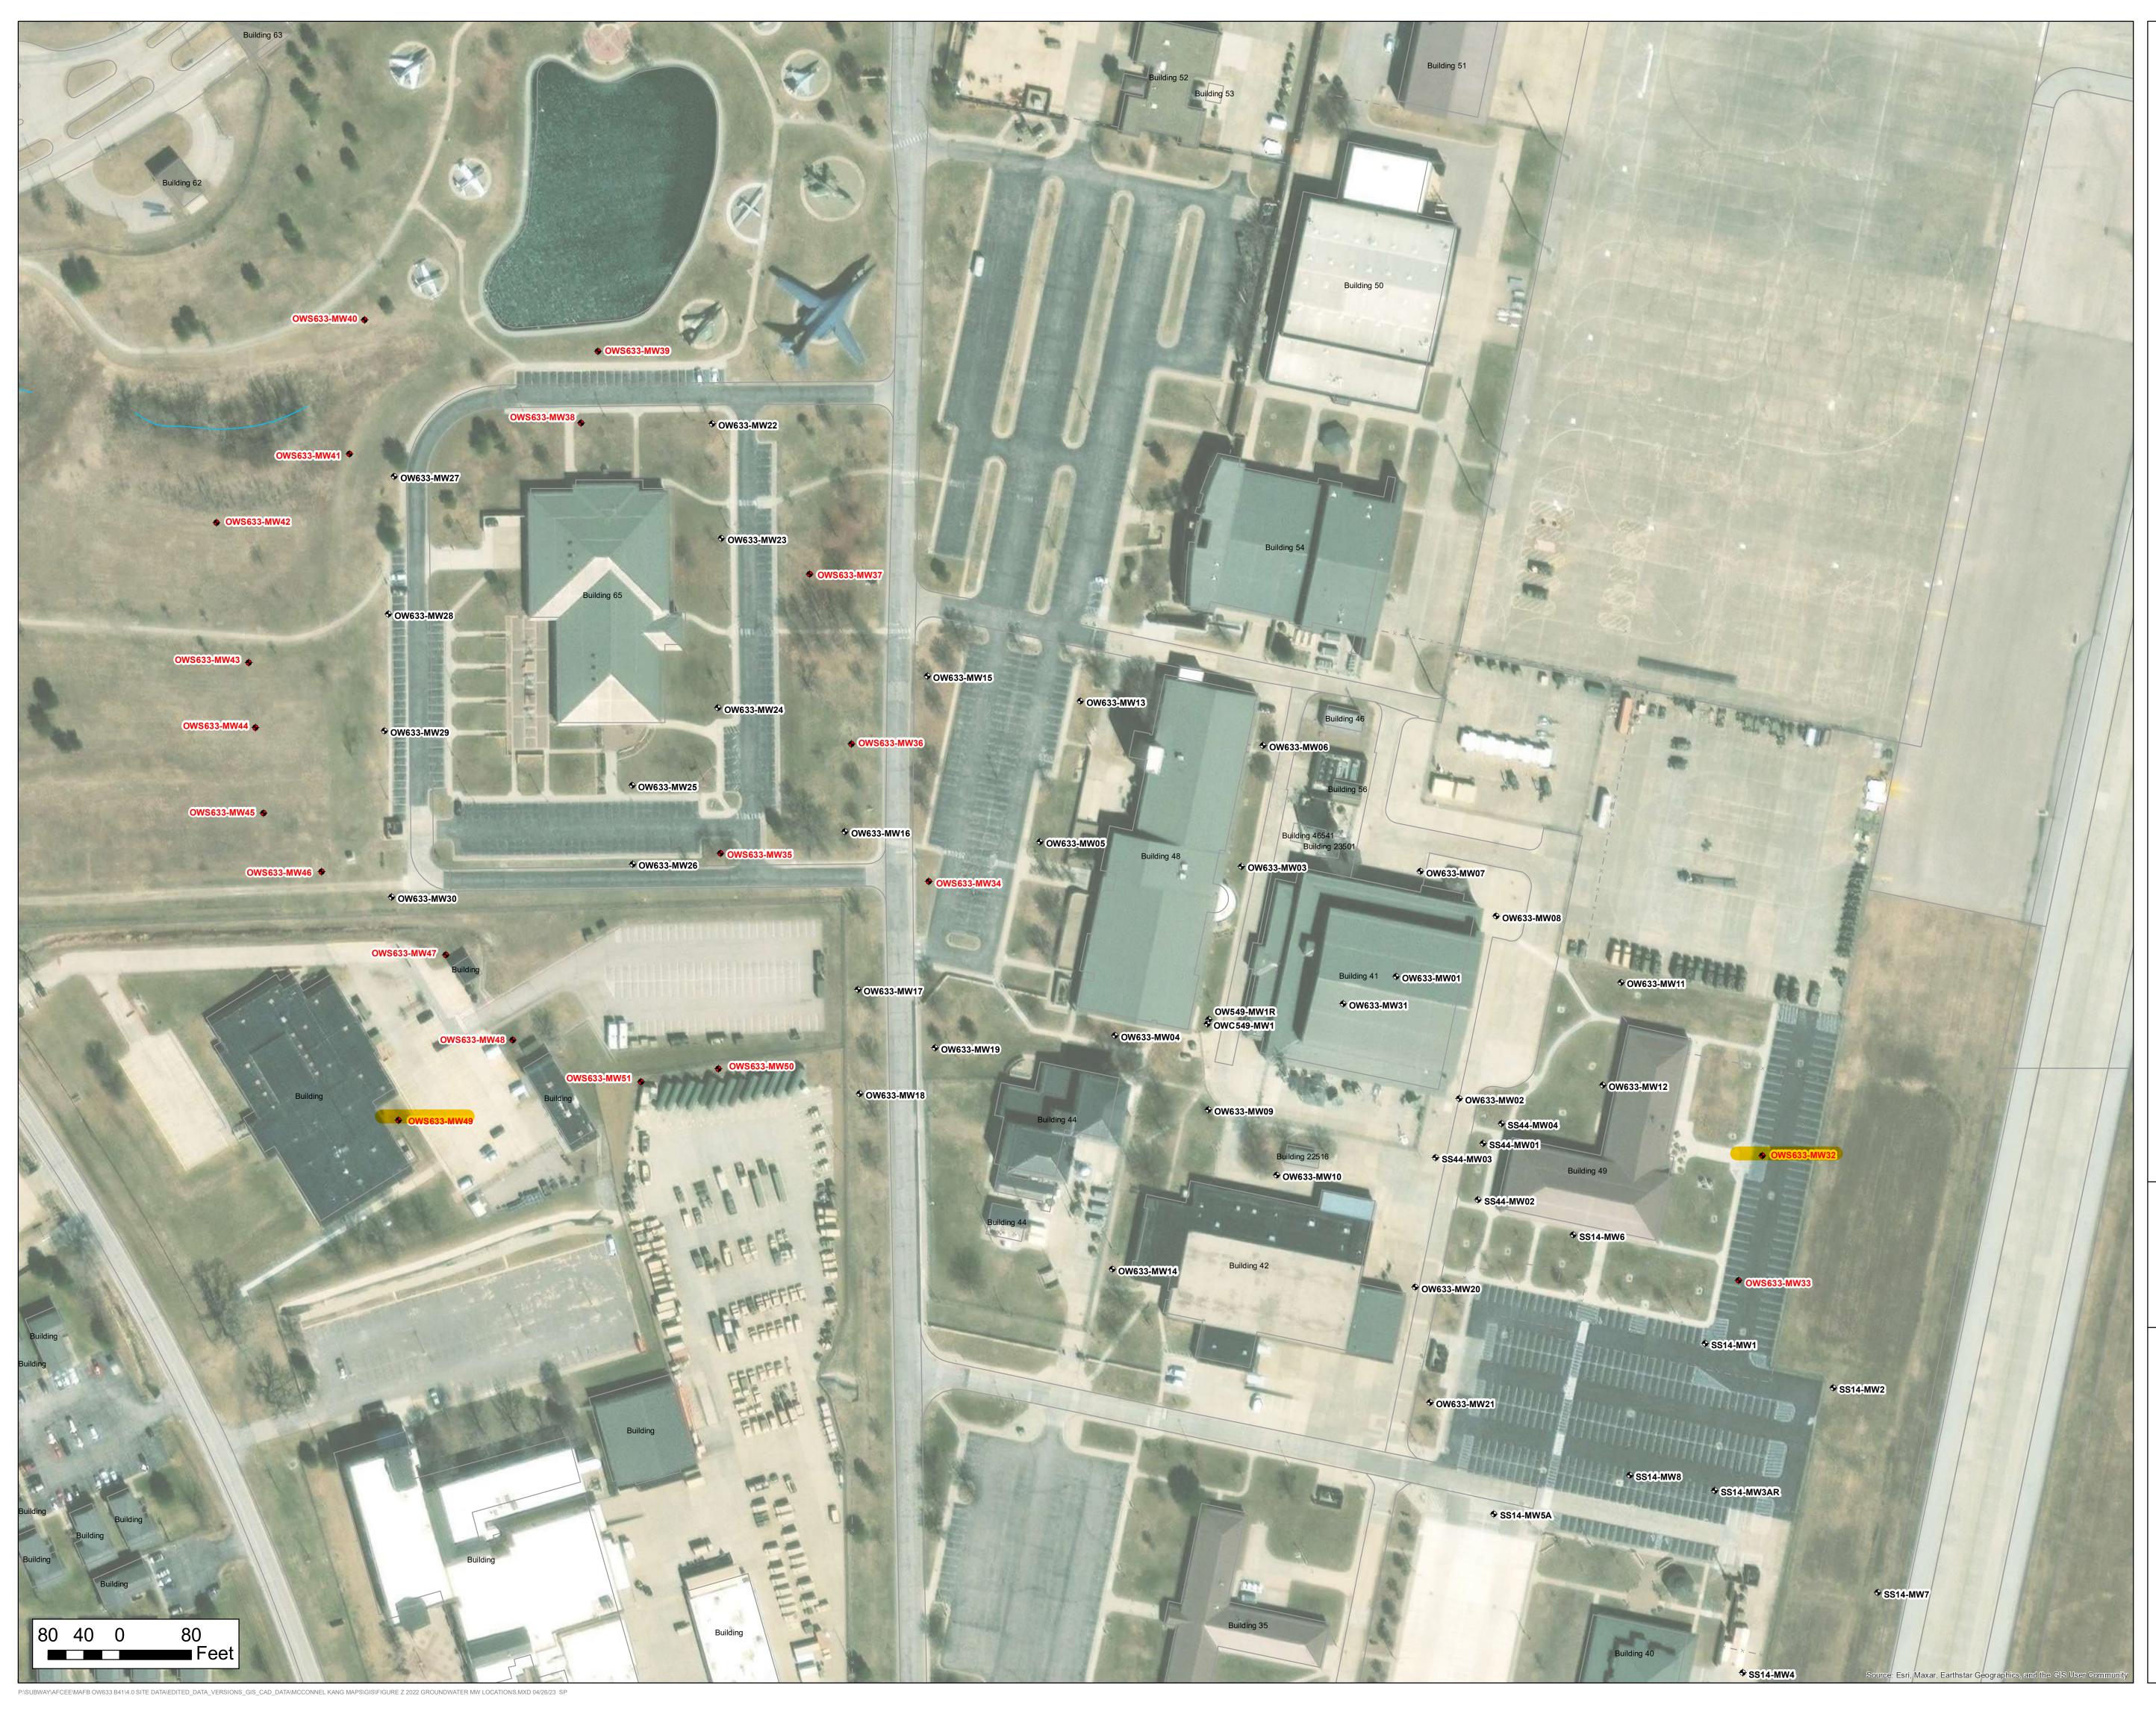

Legend

- Proposed Monitoring Well Locations
- Existing Monitoring Wells



Drawn By: SP Checked By: MS Groundwater Data Date: 2022 Project No: 112IG-AMC-T41781 Source: USAF, Tetra Tech, URS



OW633 Groundwater Monitoring Wells

McConnell Air Force Base Sedgwick County, Kansas

Figure Z

Source: ESRI, USGS

Date: 4/26/2023