

WATER WELL RECORD (WWC-5)

KOLAR DOC ID _____ WELL ID _____

Original Record Correction Change in Well Use

LOCATION OF WATER WELL

Latitude		Longitude		Section		Township		Range		E W	Fraction	¼	¼	¼
Datum		Elevation		County										

WATER WELL OWNER

Name	
Business	
Address	
Well location at owner's address	

WELL WATER USE

--

COMPLETION

Depth of completed well: _____ ft.
Depth(s) groundwater encountered:
(1) _____ ft.; (2) _____ ft.;
(3) _____ ft.; (4) dry well
Static water level in well: _____ ft.
measured below land surface
on (mm/dd/yy): _____
measured above land surface
on (mm/dd/yy): _____
Estimated yield: _____ gpm
Water level was: _____ ft. after _____ hours
pumping _____ gpm
Pump installed? Yes No
Water well disinfected? Yes No
Date disinfected (mm/dd/yy): _____
Aquifer, if known:

NEAREST SOURCE OF POTENTIAL CONTAMINATION

Source: _____
Distance from well: _____ Direction from well: _____
Source description: _____
Source: _____
Distance from well: _____ Direction from well: _____
Source description: _____
No potential source of contamination within 100 feet.

CONSTRUCTION

Borehole interval:	Borehole diameter:
from _____ to _____ ft.	_____ in.
from _____ to _____ ft.	_____ in.
Casing height above land surface: _____ in.	
If casing height is less than 12 in. has a variance been approved?*	Yes No
*variance not required for monitoring or environmental remediation wells	
Casing type: _____	
Blank casing interval: _____ ft. to _____ ft.	
Blank casing diameter: _____ in.	
Casing joints: _____	
Weight: _____ lbs/ft.	
Wall thickness or gauge no.: _____	
Blank casing interval: _____ ft. to _____ ft.	
Blank casing diameter: _____ in.	
Casing joints: _____	
Weight: _____ lbs/ft.	
Wall thickness or gauge no.: _____	
Grout interval: _____ ft. to _____ ft.	
Grout material: _____	
Grout interval: _____ ft. to _____ ft.	
Grout material: _____	
Screen / perforation material: _____	
Screen / perforation openings: _____	
Screen / perforation intervals:	
From _____ ft. to _____ ft.	
Slot size _____ unit _____	
From _____ ft. to _____ ft.	
Slot size _____ unit _____	
Gravel pack intervals:	
Gravel pack not used: Gravel size _____ in	
From _____ ft. to _____ ft.	
Gravel pack not used: Gravel size _____ in	
From _____ ft. to _____ ft.	

PERMIT & ID NUMBERS (AS REQUIRED)

DWR Application No.: _____
KDHE / EPA Project Code: _____
Site Name: _____
KDHE UIC Class V Form Completed: Yes No
County Permit: Yes No Permit ID: _____
Lease Name & Well #: _____
of boreholes: _____ # of dewatering wells: _____

LITHOLOGIC LOG

FROM	TO	LITHOLOGY INTERVALS

COMMENTS

--

CONTRACTOR'S OR LANDOWNERS CERTIFICATION

This water well was constructed reconstructed pursuant to the stated water well contractor's license and was completed on _____. I certify that this record is true to the best of my knowledge and belief. This water well record was completed on _____ under the business name of _____, Kansas Water Well Contractor's License No. _____ under the authority of the designated person as defined in K.A.R. 28-30-2(j) and signed and certified by the electronic signature of the designated person at its submittal: _____.

Send one copy to WATER WELL OWNER and retain one for your records. Fee of \$5.00 for each constructed well.

Form	WWC5.2 - Water Well Record
Doc ID	1724627
Well Owner	Atlas Technical Consultants LLC
Contractor	GSI Engineering, LLC

Lithology

From	To	Lithology Intervals
0	.5	other, Asphalt
.5	5	clay-lean, black, dry, sand and gravel traces, no odor, very dense to dense, medium to fine grained
5	12.5	clay, sandy, dry, loose, traces of gravel, no odor, light brown to brown
12.5	15	clay-lean, moist, dense, with sand, no odor, well sorted, brown, yellow, green
15	17	clay, sandy, moist, green/brown, well sorted
17	17.5	clay-lean, very dense
17.5	18.5	clay, sandy, moist, no odor
18.5	20	shale, unknown, dry, brown to light brown

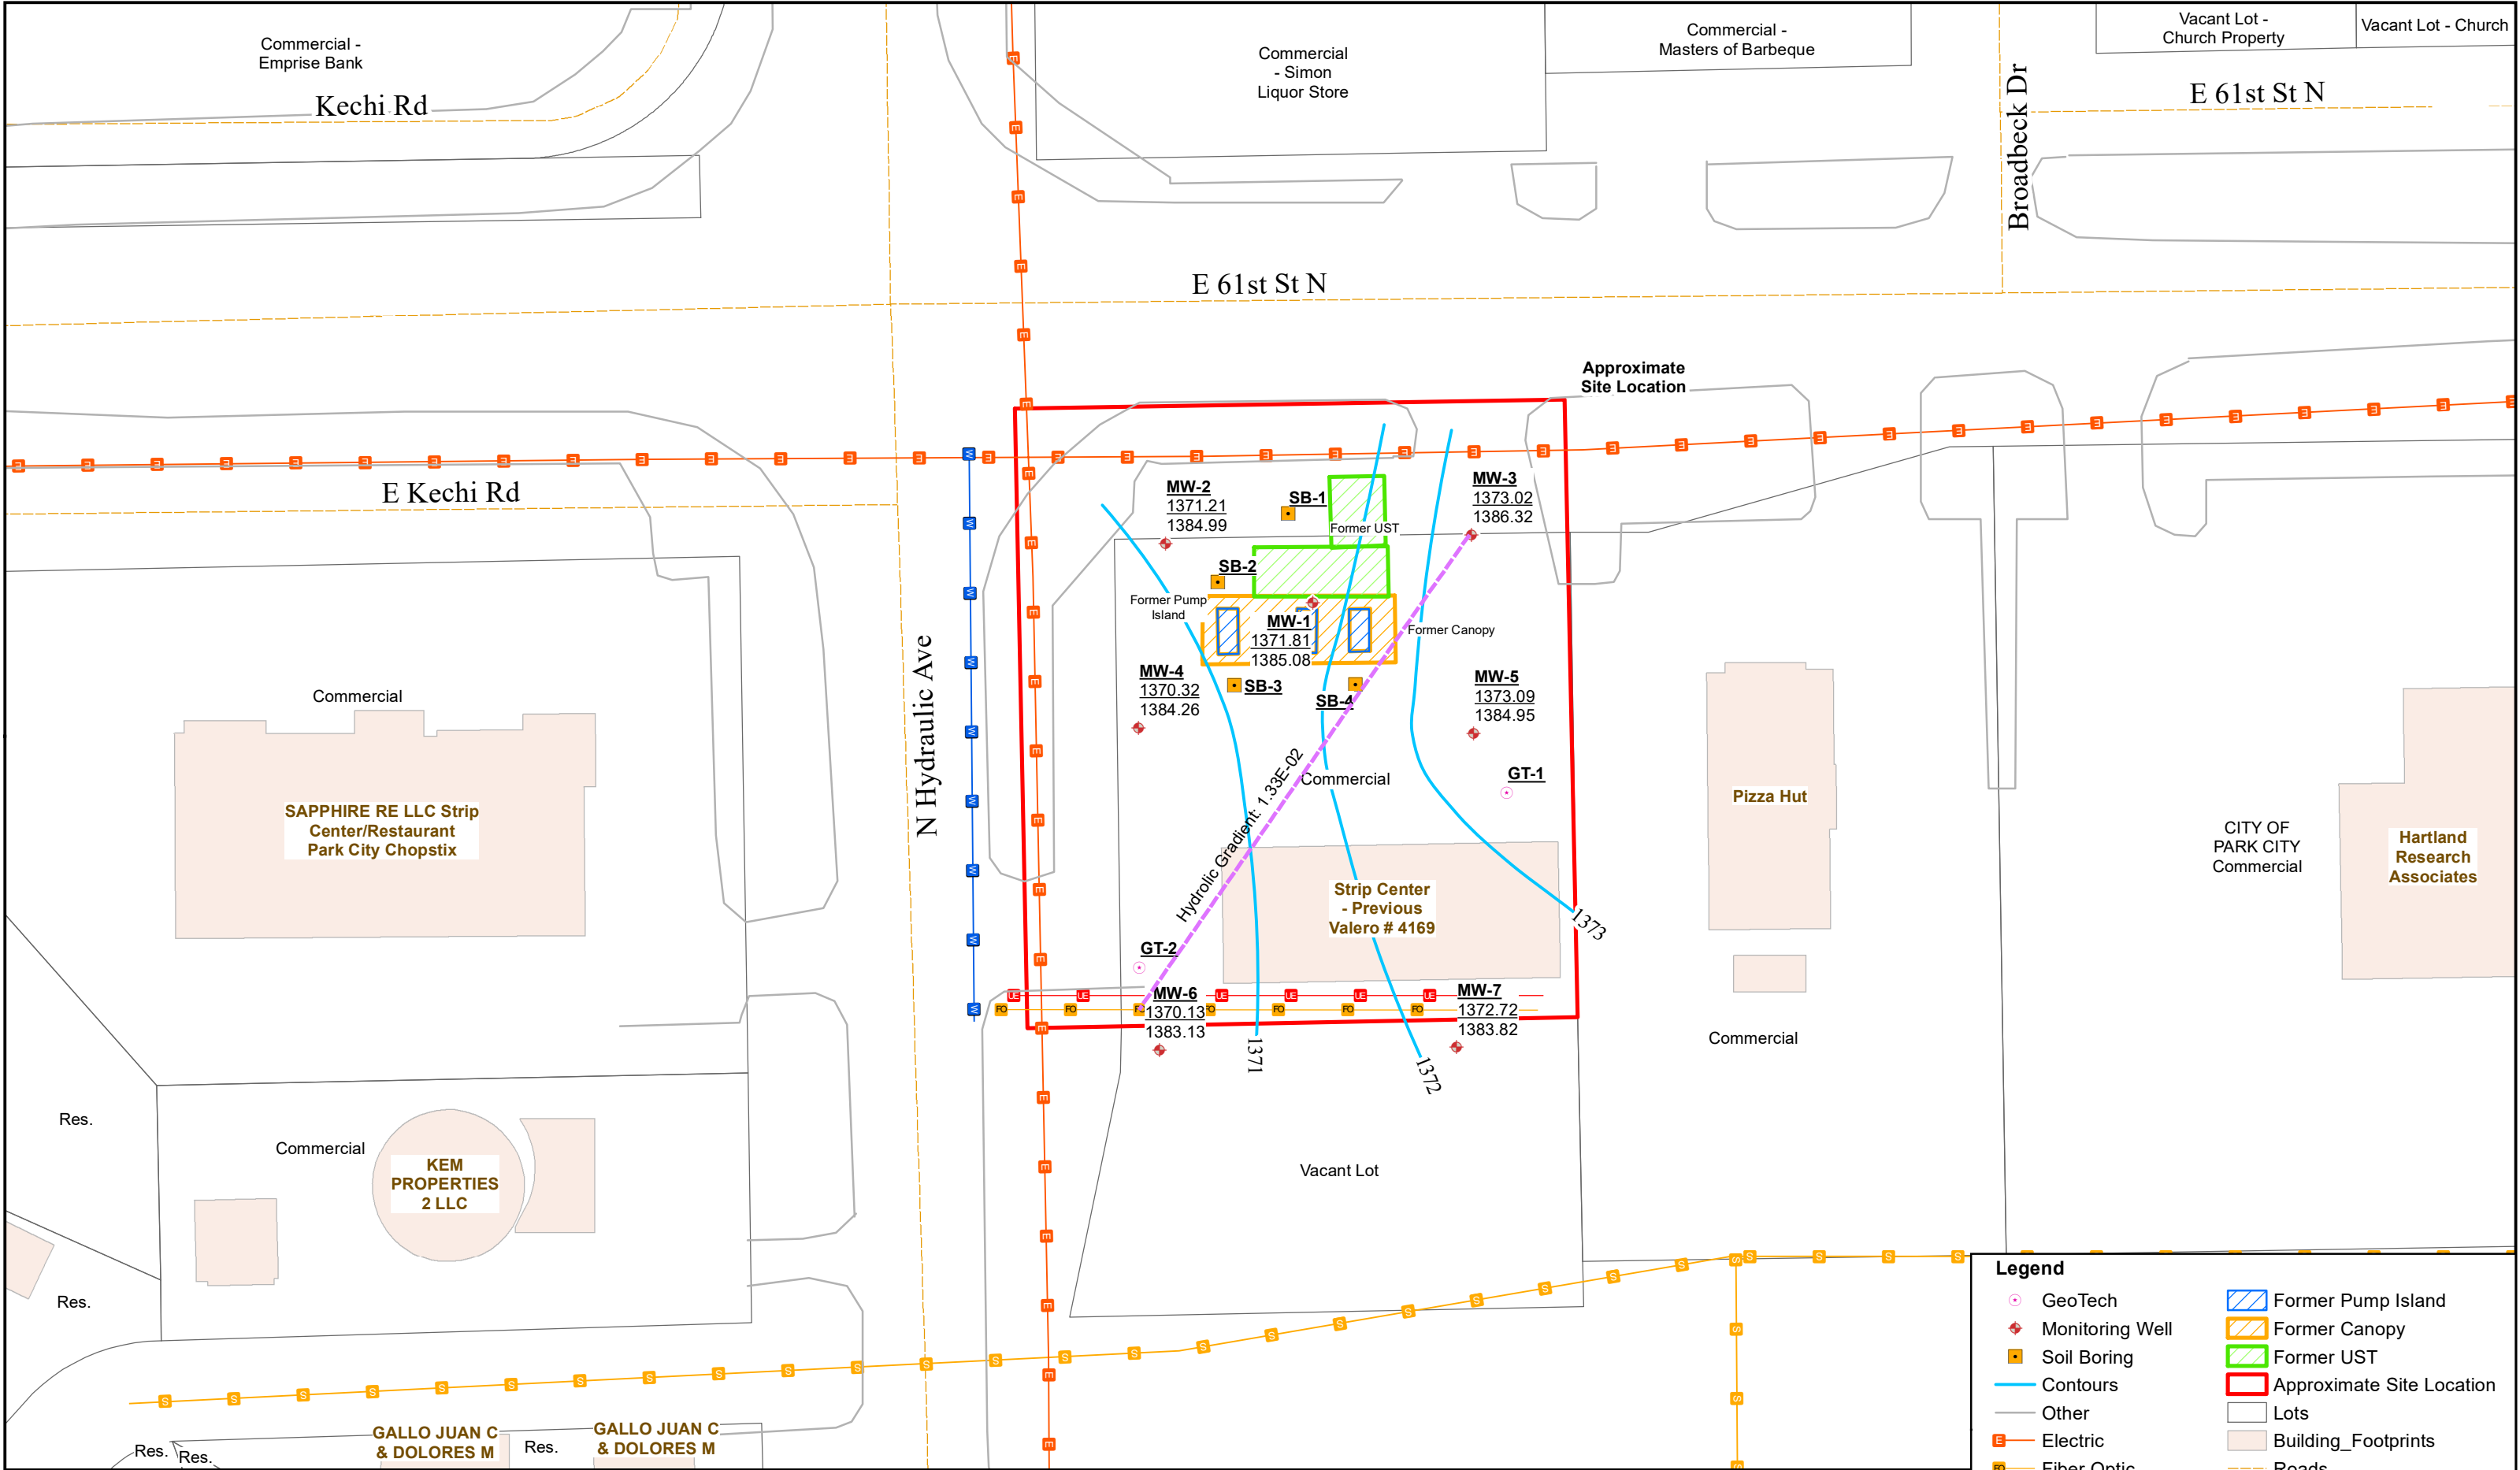




FIGURE: 3.0
DATE: 06/05/2023
DRAWN BY: PMCLAUGHLIN

FIGURE NAME: Groundwater Flow Map
PROJECT NUMBER: 22W2043.01
PROJECT MANAGER: NALLEN

Valero # 4169
1701 E 61st
Park City, KS 67219
KDHE#: U2-087-14603

Feet
0 50
1 in = 50 feet



Legend

GeoTech	Former Pump Island
Monitoring Well	Former Canopy
Soil Boring	Former UST
Contours	Approximate Site Location
Other	Lots
Electric	Building_Footprints
Fiber Optic	Roads
Municipal Sewer	<p>1372.72 = Groundwater Elevation 1383.82 = Groundwater Top of Casing Measured: 05/04/2023 Units: Feet</p>
Underground Electric	

ALL BOUNDARIES AND LOCATIONS ARE APPROXIMATE