

WATER WELL RECORD (WWC-5)

KOLAR DOC ID _____ WELL ID _____
 Original Record Correction Change in Well Use

LOCATION OF WATER WELL

Latitude		Longitude		Section		Township		Range		E W	Fraction	¼	¼	¼
Datum		Elevation		County										

WATER WELL OWNER

Name	
Business	
Address	
Well location	
at owner's address	

WELL WATER USE

--

COMPLETION

Depth of completed well: _____ ft.
Depth(s) groundwater encountered:
(1) _____ ft.; (2) _____ ft.;
(3) _____ ft.; (4) dry well
Static water level in well: _____ ft.
measured below land surface
on (mm/dd/yy): _____
measured above land surface
on (mm/dd/yy): _____
Estimated yield: _____ gpm
Water level was: _____ ft. after _____ hours
pumping _____ gpm
Pump installed? Yes No
Water well disinfected? Yes No
Date disinfected (mm/dd/yy): _____
Aquifer, if known:

NEAREST SOURCE OF POTENTIAL CONTAMINATION

Source: _____
Distance from well: _____ Direction from well: _____
Source description: _____
Source: _____
Distance from well: _____ Direction from well: _____
Source description: _____
No potential source of contamination within 100 feet.

CONSTRUCTION

Borehole interval:	Borehole diameter:
from _____ to _____ ft.	_____ in.
from _____ to _____ ft.	_____ in.
Casing height above land surface: _____ in.	
If casing height is less than 12 in. has a variance been approved?*	
Yes No	
*variance not required for monitoring or environmental remediation wells	
Casing type: _____	
Blank casing interval: _____ ft. to _____ ft.	
Blank casing diameter: _____ in.	
Casing joints: _____	
Weight: _____ lbs/ft.	
Wall thickness or gauge no.: _____	
Blank casing interval: _____ ft. to _____ ft.	
Blank casing diameter: _____ in.	
Casing joints: _____	
Weight: _____ lbs/ft.	
Wall thickness or gauge no.: _____	
Grout interval: _____ ft. to _____ ft.	
Grout material: _____	
Grout interval: _____ ft. to _____ ft.	
Grout material: _____	
Screen / perforation material: _____	
Screen / perforation openings: _____	
Screen / perforation intervals:	
From _____ ft. to _____ ft.	
Slot size _____ unit _____	
From _____ ft. to _____ ft.	
Slot size _____ unit _____	
Gravel pack intervals:	
Gravel pack not used: Gravel size _____ in	
From _____ ft. to _____ ft.	
Gravel pack not used: Gravel size _____ in	
From _____ ft. to _____ ft.	

PERMIT & ID NUMBERS (AS REQUIRED)

DWR Application No.: _____
KDHE / EPA Project Code: _____
Site Name: _____
KDHE UIC Class V Form Completed: Yes No
County Permit: Yes No Permit ID: _____
Lease Name & Well #: _____
of boreholes: _____ # of dewatering wells: _____

LITHOLOGIC LOG

FROM	TO	LITHOLOGY INTERVALS

COMMENTS

--

CONTRACTOR'S OR LANDOWNERS CERTIFICATION

This water well was constructed reconstructed pursuant to the stated water well contractor's license and was completed on _____. I certify that this record is true to the best of my knowledge and belief. This water well record was completed on _____ under the business name of _____, Kansas Water Well Contractor's License No. _____ under the authority of the designated person as defined in K.A.R. 28-30-2(j) and signed and certified by the electronic signature of the designated person at its submittal: _____.

Send one copy to WATER WELL OWNER and retain one for your records. Fee of \$5.00 for each constructed well.

NOTE: Figures exhibited within this report are only to be used within the context of this report. Placement of property lines, wells, structures, and roads is based on the available information from county appraiser maps, surveys, site visits, and/or previous vendor reports and should be considered approximate.

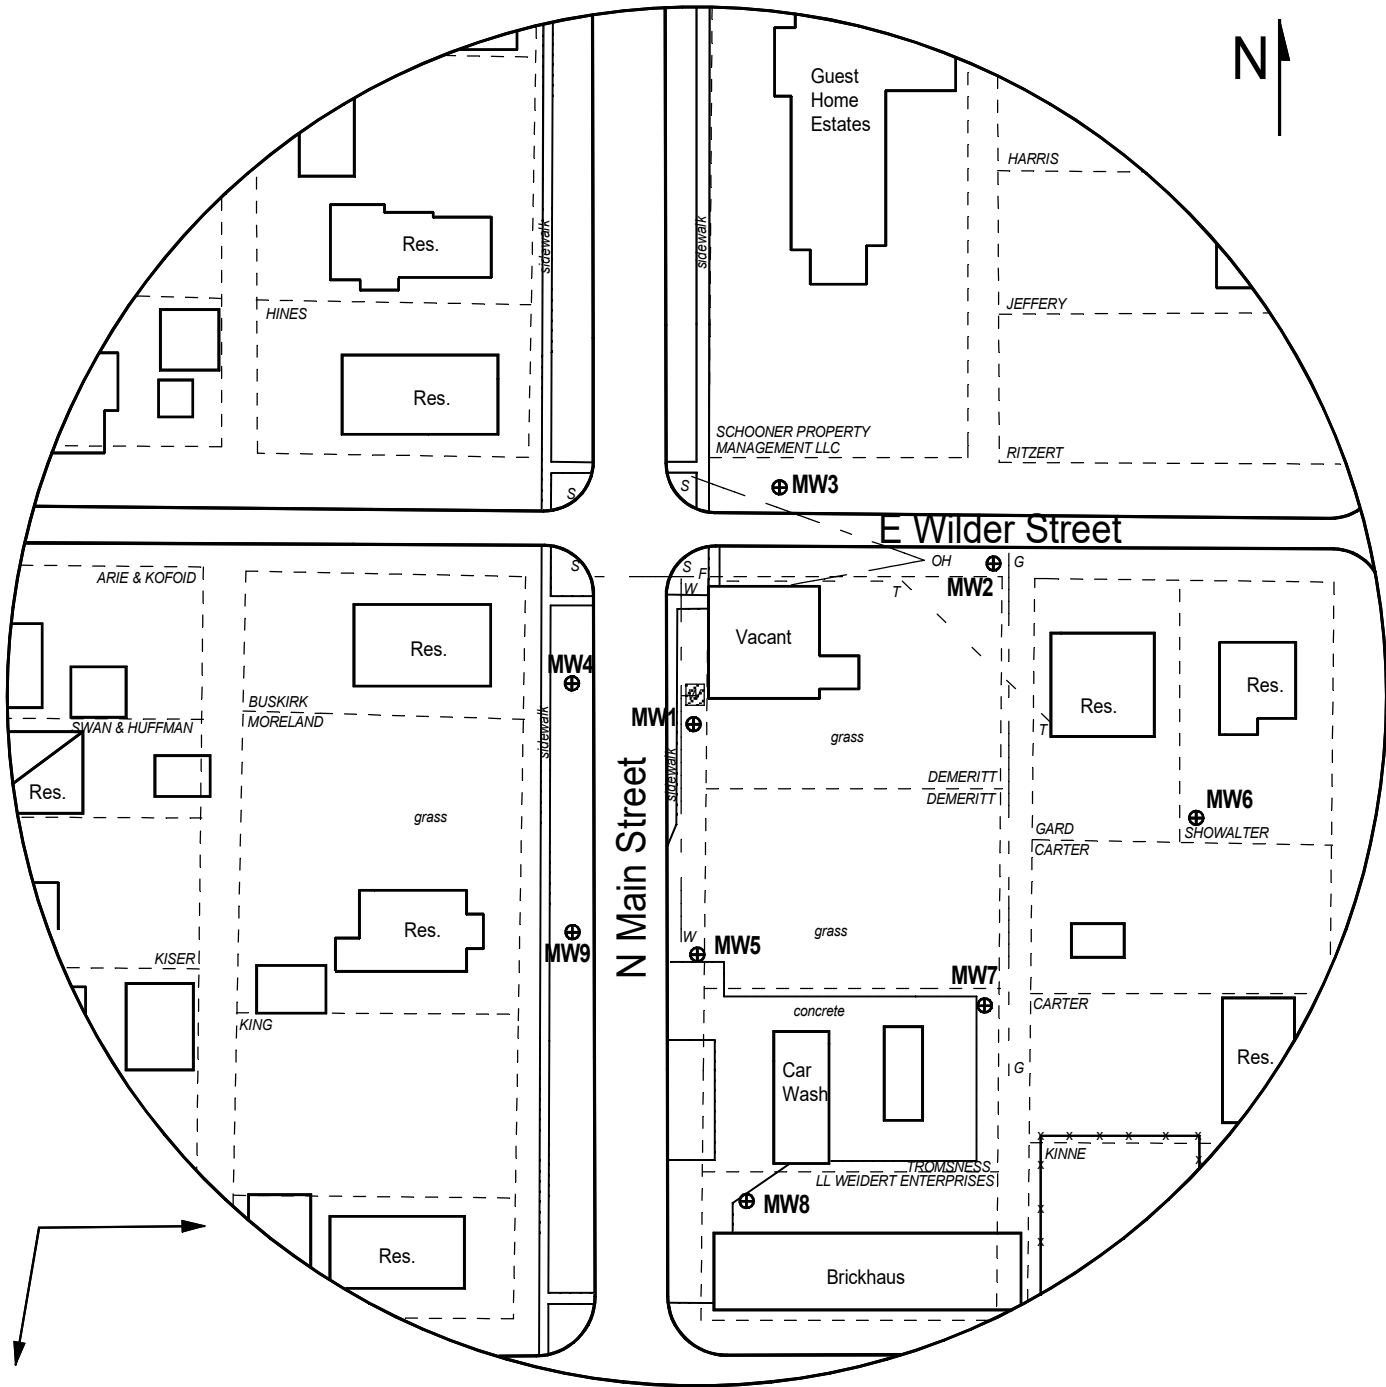


FIGURE 3 - 350 FT RADIUS AREA BASE MAP

LEGEND:

- Approximate Location of Former UST Basin
- Building with Basement
- Proposed Monitoring Well
- Proposed Soil Boring
- Fire Hydrant
- Overhead Lines (25-40 ft high)
- Sewer (2 - 6 ft BGS)
- Sanitary Sewer (2 - 6 ft BGS)
- Gas (2 - 6 ft BGS)
- Water (2 - 6 ft BGS)

NOTE: SB5 & SB6 will be drilled to collect hydrological samples.
NOTE: Utility depths and locations are approximate.



PROJECT:

City of Erie
226 N. Main
Erie, KS
KDHE ID: U3-067-15295
Date: 2/23/23



1311 E 25th St., Suite B (785) 841-8707 office
Lawrence, KS 66046 (785) 865-4282 fax

DENNIS L HANDKE

1820 NW 59th Terrace
TOPEKA, KANSAS 66618
785-286-4047 Home

Jess Chapman
Larsen & Associates
1311 E. 25th Street, Suite B
Lawrence, Kansas, 66046

September 14, 2023

RE: Monitor Well Elevation Survey
226 N. Main St., Erie, Kansas

Proj. 23-00EE
City of Erie
U3-067-15295

Bench Mark: Chisled Sq. on West edge of concrete floor of storage unit of car wash.
Elev: 896.83 North 4060.22 West 2545.79 (from SE Cor. Sec. 32-28-20E)

MW-1	rim	893.90	North	4261.21	SW1/4,SW1/4,NW1/4,NE1/4
	top pipe	893.49	West	2589.14	Lat= 37.56971 Long = 95.24331
MW-2	rim	891.43	North	4344.17	NW1/4,SW1/4,NW1/4,NE1/4
	top pipe	890.87	West	2484.56	Lat= 37.56994 Long = 95.24294
MW-3	rim	892.59	North	4382.93	NW1/4,SW1/4,NW1/4,NE1/4
	top pipe	892.16	West	2549.94	Lat= 37.57005 Long = 95.24317
MW-4	rim	894.72	North	4275.45	SE1/4,SE1/4,NE1/4,NW1/4
	top pipe	894.43	West	2657.40	Lat= 37.56975 Long = 95.24354
MW-5	rim	895.20	North	4139.67	SW1/4,SW1/4,NW1/4,NE1/4
	top pipe	894.76	West	2587.87	Lat= 37.56938 Long = 95.24330
MW-6	rim	890.98	North	4196.70	SW1/4,SW1/4,NW1/4,NE1/4
	top pipe	890.65	West	2326.72	Lat= 37.56953 Long = 95.24240
MW-7	rim	896.90	North	4112.35	SW1/4,SW1/4,NW1/4,NE1/4
	top pipe	896.42	West	2451.30	Lat= 37.56930 Long = 95.24283
MW-8	rim	896.18	North	4018.99	SW1/4,SW1/4,NW1/4,NE1/4
	top pipe	895.69	West	2568.50	Lat= 37.56905 Long = 95.24324
MW-9	rim	895.50	North	4149.37	SE1/4,SE1/4,NE1/4,NW1/4
	top pipe	895.09	West	2656.09	Lat= 37.56941 Long = 95.24354

Lat & Long derived from Erie 7.5' quad map. WGS 84.

Elevation established from NGS BM ERIE 1934. NAVD 88.

If you have any questions, please feel free to call me. Thank you for the opportunity to be of service to you.

Dennis L Handke BLS

