
#### **WATER WELL RECORD** (WWC-5)

From \_\_\_\_\_ ft. to \_\_\_\_\_ ft.

<b>WATER WELL R</b>	ECORD (W)	NC-5)				KOLAR D	OC ID	WELL ID		
OCATION OF WATER W	/ELL				Or	iginal Recor	d Correction	Change	in Wel	ll Use
Latitude	Longitude		S	ection	Township	Range	E W Fraction	1/4	1/4	1/4
Datum	Elevation		C	County	-		**			
WATER WELL OWNER			WELL W	ATER USE			NEAREST SOURCE OF P	OTENTIAL CO	NTAMIN	10ITAN
Name							Source:			
Business			COMPLI	ETION						
Busiliess							from well:	_ from well	:	
Address					ed well: vater encountered:	ft.	Source description:			
			(1)	ft.; (	(2) ft.;		Source:			
Well location					4) dry well		Distance from well:			
at owner's address	Static water level in well: ft.  measured below land surface				Source description:					
CONSTRUCTION  Borehole interval:	on (mm/dd/yy):  measured above land surface on (mm/dd/yy):				No potential source of contamination within 100 feet.					
	Borehole diar						PERMIT & ID NUMBERS	S (AS REQUIF	RED)	
fromtoft. fromtoft.		in. in.			gpm ft. after	hours	DWR Application No.:			
Casing height above land					pumping		KDHE / EPA Project C	ode:		
If casing height is les	Pump installed? Yes No				Site Name:					
has a variance been a		No					KDHE UIC Class V Fo	rm Complete	d: Yes	No
*variance not require			Water well disinfected? Yes No				County Permit: Yes No Permit ID:			
or environmental re	mediation wells		Date di	sinfected (	mm/dd/yy):		Lease Name & Well #:			
Casing type:			Aquifer	; if known			# of boreholes:	# of dewateri	ing wells:	
Blank casing interval:		_ n.								
Blank casing diameter:			FROM	OGIC LOG	LITHOLOGY INT	FDVALC				
Casing joints: Weight:			FROM	10	LITHOLOGY IN I	ERVALS				
Wall thickness or gau										
Blank casing interval:										
Blank casing diameter:		r.								
Casing joints:										
Weight:	lbs/ft.									
Wall thickness or gau	_									
Grout interval:f										
Grout material:										
Grout interval:f			COMME	NTS						
Grout material:										
Screen / perforation mate										
Screen / perforation oper					OR LANDOWNERS CI	RTIFICATION				
Screen / perforation inter			This w	ater well	was constructed	reconstru	cted pursuant to t	he stated wa	ater well	Ĺ
Fromft. to			contra	ctor's lice	nse and was comple	eted on	I certify tha	t this record	is true	to
Slot size u			the bes	st of my k	nowledge and belie	f. This water v	vell record was complet	ed on		
From ft. to			under	the busin	ess name of					,
Slot size u	nit		Kansas	s Water V	Vell Contractor's Lic	ense No.	under the aut	hority of the	design:	ated
Gravel pack intervals:							d and certified by the el	-	_	
Gravel pack not used		in	-			Zy) und signed	a and certified by the el	cettonic sign	nature 0	- uic
From ft. to _	ft.			-	on at its submittal:_					
Gravel pack not used	: Gravel size _	in	Send one	e copy to W	VATER WELL OWNE	R and retain one	e for your records. Fee of \$5	0.00 for each c	onstructe	ed well

KANSAS DEPARTMENT OF HEALTH AND ENVIRONMENT Bureau of Water, Geology Section, 1000 SW Jackson St., Suite 420, Topeka KS 66612-1367 (785) 296-3565 | K.S.A. 82a-1212 | v2022c

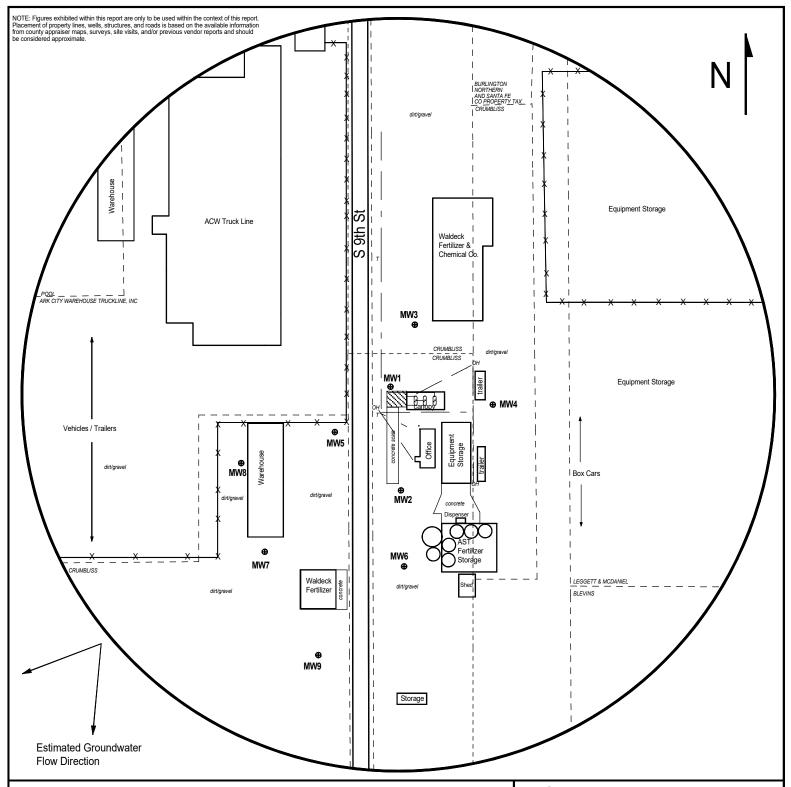

## FIGURE 2 - 500 FT RADIUS AREA BASE MAP



1311 E 25th St., Suite B Lawrence, KS 66046

(785) 841-8707 office (785) 865-4282 fax

### **PROJECT:**

Waldeck Oil Company 700 South 9th, Arkansas City, KS KDHE ID: U2-018-15380 Date: 6/8/23

0 100 feet

## LEGEND:

Approximate Location of Active UST Basin, Product Lines, and Pump Island

- - - Property Lines

--- City Line/Property Line

Proposed Monitoring Well

X Proposed Soil Boring

\_\_\_\_\_\_ Overhead Lines (25-40 ft high)
\_\_\_\_\_\_ Sanitary Sewer (2 - 6 ft BGS)
\_\_\_\_ \_ \_ \_ \_ \_ \_ \_ Telephone (2 - 6 ft BGS)

NOTE: SB5 and SB6 will be drilled to collect hydrologic data. NOTE: Utility depths, heights and locations are approximate.

# **DENNIS L HANDKE**

1820 NW 59th Terrace TOPEKA, KANSAS 66618 785-286-4047 Home

Jessica Chapman Larsen & Associates 1311 E. 25<sup>th</sup> Street, Suite B Lawrence, Kansas, 66046

September1, 2023

RE: Monitor Well Elevation Survey 700 South 9th St., Arkansas City, Kansas Proj. 23-00DD Waldeck Oil Company U2-018-15380

Bench Mark: Chisled Sq. on NW corner of concrete scale platform West of scale office. Elev: 1078.40 North 4701.10 West 3206.50 (from SE Co (from SE Cor. Sec. 36-34-3E

Elev: 1078.40		078.40	North 4701	.10	West 3206.5	o0 (from SE Cor. Sec. 36-34
	MW-1	rim top pipe	1077.41 1076.92	North West	4748.27 3204.08	SW1/4,NE1/4,NE1/4,NW1/4 Lat= 37.05478 Long = 97.05077
	MW-2	rim top pipe	1077.45 1077.05	North West	4603.57 3191.97	NW1/4,SE1/4,NE1/4,NW1/4 Lat= 37.05438 Long = 97.05073
	MW-3	rim top pipe	1077.01 1076.64	North West	4823.77 3166.50	SW1/4,NE1/4,NE1/4,NW1/4 Lat= 37.05499 Long = 97.05065
	MW-4	rim top pipe	1077.06 1076.72	North West	4719.31 3075.81	SW1/4,NE1/4,NE1/4,NW1/4 Lat= 37.05470 Long = 97.05033
	MW-5	rim top pipe	1077.88 1077.43	North West	4688.88 3283.96	SW1/4,NE1/4,NE1/4,NW1/4 Lat= 37.05461 Long = 97.05105
	MW-6	rim top pipe	1076.51 1076.15	North West	4521.42 3196.67	NW1/4,NE1/4,NE1/4,NW1/4 Lat= 37.05416 Long = 97.05074
	MW-7	rim top pipe	1077.79 1077.39	North West	4538.71 3358.63	NE1/4,SW1/4,NE1/4,NW1/4 Lat= 37.05420 Long = 97.05130
	MW-8	rim top pipe	1078.91 1078.52	North West	4642.25 3399.31	SE1/4,NW1/4,NE1/4,NW1/4 Lat= 37.05448 Long = 97.05144
	MW-9	rim top pipe	1075.93 1075.45	North West	4388.88 3307.43	NE1/4,SW1/4,NE1/4,NW1/4 Lat= 37.05379 Long = 97.05112

Lat & Long derived from Arkansas City 7.5' quad map. WGS 84.

Elevation established from NGS BM Arkansas City 1933. NAVD 88.

have any apestions, please feel free to call me. Thank you for the opportunity to be

MAND SURV