# KOLAR Document ID: 1734942

# WATER WELL RECORD (WWC-5)

KOLAR DOC ID

Source: Distance

from well:

Source description:

Source:

Distance

Source

from well:

description:

Site Name:

within 100 feet.

DWR Application No.:\_

Lease Name & Well #:

KDHE / EPA Project Code:

Correction

Original Record

ft.

WELL ID Change in Well Use

NEAREST SOURCE OF POTENTIAL CONTAMINATION

No potential source of contamination

KDHE UIC Class V Form Completed: Yes No

County Permit: Yes No Permit ID:

# of boreholes: \_\_\_\_\_ # of dewatering wells: \_

PERMIT & ID NUMBERS (AS REQUIRED)

Direction

from well:

Direction

from well:

## LOCATION OF WATER WELL

Latitude	Longitude	Section	Township	Range	E W	Fraction	1⁄4	1⁄4	1⁄4
Datum	Elevation	County							

## WATER WELL OWNER

Name				
Business				
Address				
Well location				
at owner's address				
CONSTRUCTION				

### CONSTRUCTION

Borehole interval:	Borehole diameter:
fromtoft.	in.
fromtoft.	in.
Casing height above land su	
If casing height is less th has a variance been app *variance not required fo	roved?* Yes No
or environmental reme	U U
Casing type:	
Blank casing interval:	ft. toft.
Blank casing diameter:	in.
Casing joints:	
Weight:lbs	s/ft.
Wall thickness or gauge	no.:
Blank casing interval:	ft. toft.
Blank casing diameter:	in.
Casing joints:	
Weight:lbs	s/ft.
Wall thickness or gauge	no.:
Grout interval: ft. to	oft.
Grout material:	
Grout interval: ft. to	oft.
Grout material:	
Screen / perforation material	:
Screen / perforation opening	gs:
Screen / perforation intervals	8:
Fromft. to	_ft.
Slot size unit	
Fromft. to	_ft.
Slot size unit	
Gravel pack intervals:	
Gravel pack not used:	Gravel size in
From ft. to	ft.
Gravel pack not used:	
From ft. to	

## WELL WATER USE COMPLETION Depth of completed well: Depth(s) groundwater encountered: ft.; (2) ft.; (1) (3) ft.; (4) dry well ft. Static water level in well:

measured below land surface on (mm/dd/yy): measured above land surface on (mm/dd/yy):

Estimated yield:	gpm	
Water level was:	ft. after	hours

pumping \_ gpm

Pump installed? Yes No

Water well disinfected? Yes No

Date disinfected (mm/dd/yy):

# Aquifer, if known:

## LIT


ITHOLOGIC LOG					
FROM	то	LITHOLOGY INTERVALS			

### COMMENTS

## CONTRACTOR'S OR LANDOWNERS CERTIFICATION

This water well was constructed	reconstructed	pursuant to the stated water well
contractor's license and was complete	ed on	I certify that this record is true to
the best of my knowledge and belief.	This water well reco	ord was completed on
under the business name of		,
Kansas Water Well Contractor's Licer	1se No	_ under the authority of the designated
person as defined in K.A.R. 28-30-2(j	j) and signed and co	ertified by the electronic signature of the
designated person at its submittal:		
Send one copy to WATER WELL OWNER a	and retain one for you	r records. Fee of \$5.00 for each constructed well
KANSAS DEPAR	<b>FMENT OF HEALTH</b>	AND ENVIRONMENT

Bureau of Water, Geology Section, 1000 SW Jackson St., Suite 420, Topeka KS 66612-1367 (785) 296-3565 | K.S.A. 82a-1212 | v2022c

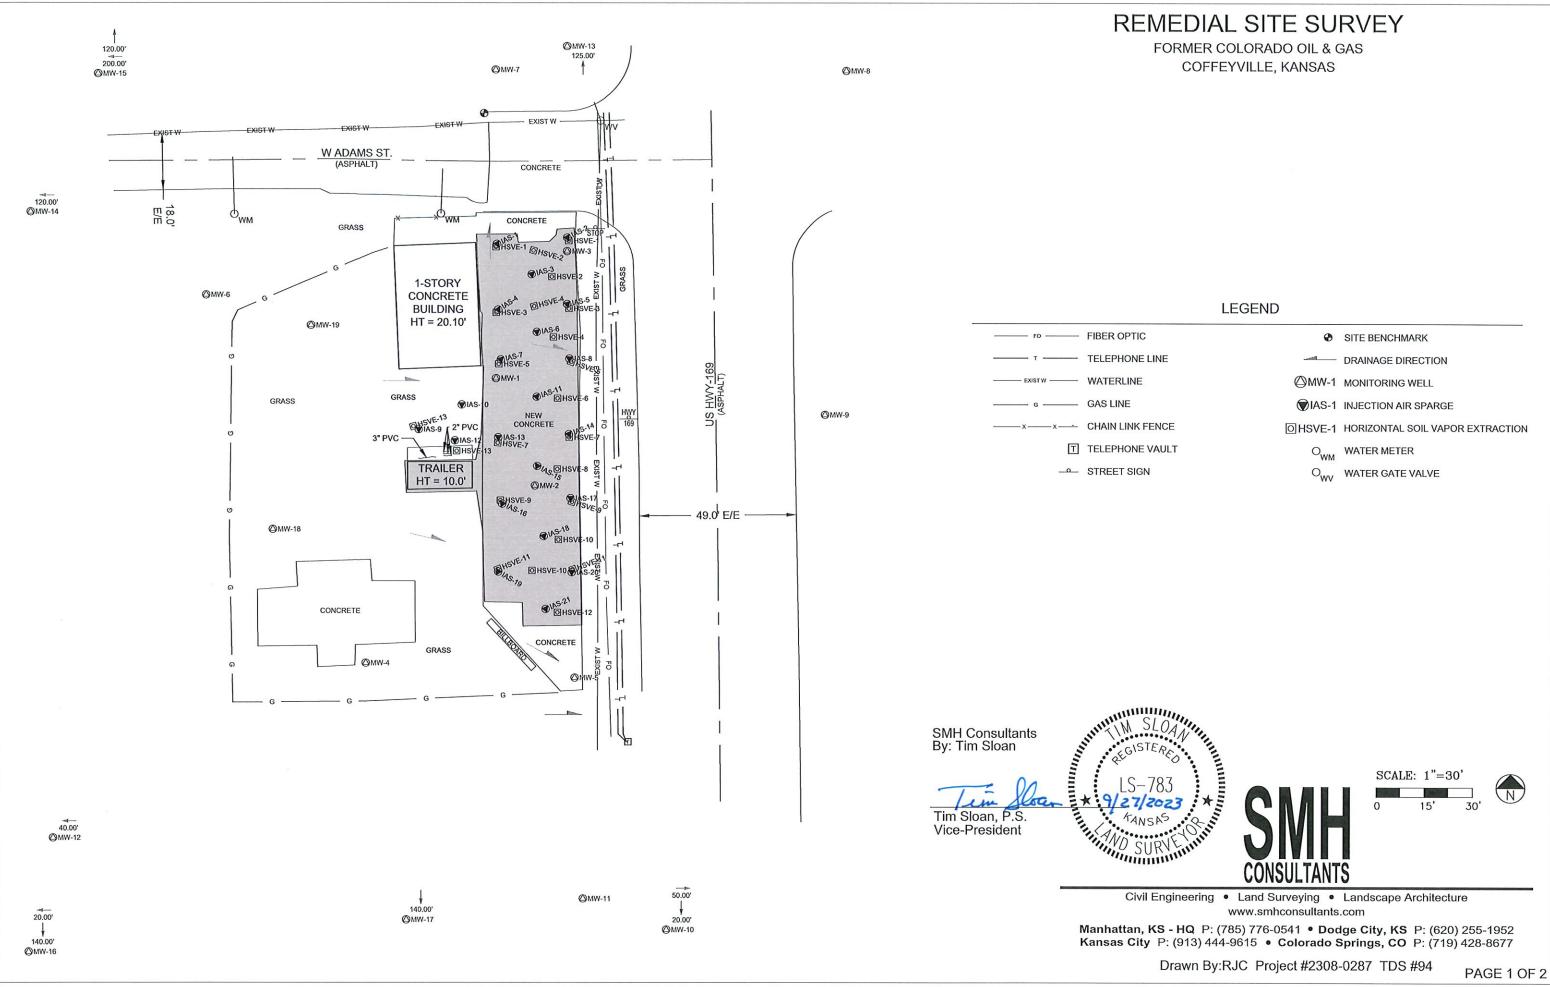

	۲	SITE BENCHMARK
INE		DRAINAGE DIRECTION
	⊘MW-1	MONITORING WELL
	<b>WIAS-1</b>	INJECTION AIR SPARGE
INCE	OHSVE-1	HORIZONTAL SOIL VAPOR EXTRACTION
AULT	0 <sub>WM</sub>	WATER METER
	Owv	WATER GATE VALVE