KOLAR Document ID: 1735400

WATER WELL RECORD (WWC-5)

KOLAR DOC ID

Original Record

Correction

Lease Name & Well #: ____

of boreholes: _____ # of dewatering wells: _

WELL ID_____ Change in Well Use

LOCATION OF WATER WELL

Latitude	Longitude	Section	Township	Range	E W	Fraction	1⁄4	1⁄4	1⁄4
Datum	Elevation	County							

WATER WELL OWNER

Name					
Business					
Address					
Well location					
at owner's address					
CONCEPTION					

CONSTRUCTION

Borehole interval:	Borehole diameter:		
fromtoft.	in.		
fromtoft.	in.		
Casing height above land su			
If casing height is less th has a variance been app *variance not required fo	roved?* Yes No		
or environmental reme	U U		
Casing type:			
Blank casing interval:	ft. toft.		
Blank casing diameter:	in.		
Casing joints:			
Weight:lbs	s/ft.		
Wall thickness or gauge	no.:		
Blank casing interval:	ft. toft.		
Blank casing diameter:	in.		
Casing joints:			
Weight:lbs	s/ft.		
Wall thickness or gauge	no.:		
Grout interval: ft. to	oft.		
Grout material:			
Grout interval: ft. to	oft.		
Grout material:			
Screen / perforation material	:		
Screen / perforation opening	gs:		
Screen / perforation interval	s:		
Fromft. to	_ft.		
Slot size unit			
Fromft. to	_ft.		
Slot size unit			
Gravel pack intervals:			
Gravel pack not used:	Gravel size in		
From ft. to	ft.		
Gravel pack not used:			
From ft. to			

	County								
WELL	WELL WATER USE								
сом	COMPLETION								
Dept	th of comp	leted we	ell:		ft.				
	- th(s) groui								
(1)_									
(3)_	ft.;	(4)	dry well						
Stati	Static water level in well: ft.								
measured below land surface on (mm/dd/yy):									
	measured above land surface on (mm/dd/yy):								
Estir	Estimated yield: gpm								
Wate	Water level was: ft. after hours								
			pumping		gpm				
Pum	p installed	l? Yes	s No						
Wate	Water well disinfected? Yes No								
Date	Date disinfected (mm/dd/yy):								

NEAREST SOURCE OF	POTENTIAL CONTAMINATION
Source:	
Distance from well:	Direction from well:
Source description:	
Source:	
Distance from well:	Direction from well:
Source description:	
No potential sou within 100 feet.	rce of contamination
PERMIT & ID NUMBE	ERS (AS REQUIRED)
DWR Application N	0.:
KDHE / EPA Project	t Code:
Site Name:	
	Form Completed: Yes No
County Permit: Ye	es No Permit ID:

Aquifer, if known:


FROM	то	LITHOLOGY INTERVALS						

COMMENTS

CONTRACTOR'S OR LANDOWNERS CERTIFICATION

This water well was constructed	reconstructed	pursuant to the stated water well
contractor's license and was complete	I certify that this record is true to	
the best of my knowledge and belief.	This water well rec	ord was completed on
under the business name of		,
Kansas Water Well Contractor's Lice	nse No	_ under the authority of the designated
person as defined in K.A.R. 28-30-2(j) and signed and c	ertified by the electronic signature of the
designated person at its submittal:		
Send one copy to WATER WELL OWNER	and retain one for you	r records. Fee of \$5.00 for each constructed well.
KANSAS DEPAR	TMENT OF HEALTH	AND ENVIRONMENT

Bureau of Water, Geology Section, 1000 SW Jackson St., Suite 420, Topeka KS 66612-1367 (785) 296-3565 | K.S.A. 82a-1212 | v2022c

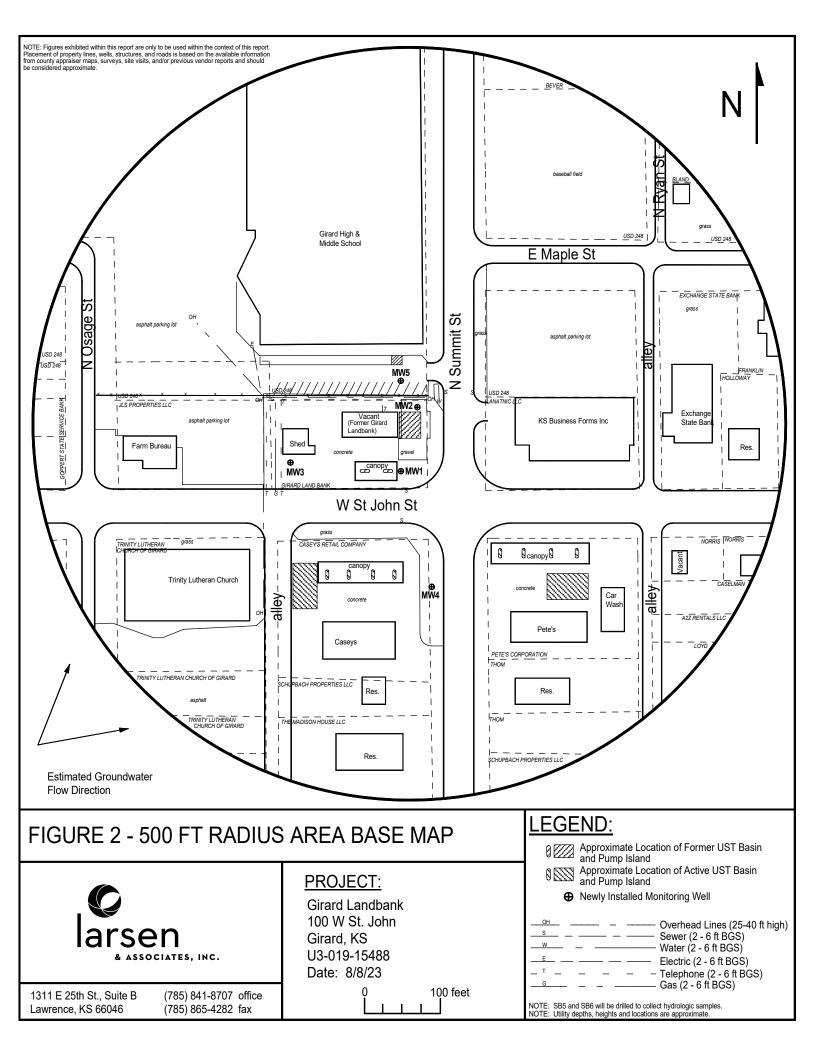

DENNIS L HANDKE

1820 NW 59th Terrace TOPEKA, KANSAS 66618 785-286-4047 Home

October 10, 2023

Jess Chapman Larsen & Associates 1311 E. 25th Street, Suite B Lawrence, Kansas, 66046

RE: Monitor Well Elevation Survey 100 W. St. John, Girard, Kansas

Proj. 23-00GG Girard Landbank U3-019-15488

Bench I Elev: 9		ed Sq. on East North 35.11	0	the East cone est 2940.59	crete pump island South of building. (from SE Cor. Sec. 13-29-23E)
MW-1	rim	997.94	North	35.02	SW1/4,SE1/4,SE1/4,SW1/4
	top pipe	997.45	West	2932.35	Lat= 37.51393 Long = 94.84373
MW-2	rim	997.31	North	121.48	SE1/4,SE1/4,SE1/4,SW1/4
	top pipe	996.93	West	2903.09	Lat= 37.51417 Long = 94.84362
MW-3	rim	997.04	North	45.58	SW1/4,SE1/4,SE1/4,SW1/4
	top pipe	996.54	West	3083.81	Lat= 37.51396 Long = 94.84426
MW-4	rim	998.06	South	110.14	NE1/4,NE1/4,NE1/4,NW1/4 (Sec. 24-29-23)
	top pipe	997.76	West	2896.55	Lat= 37.51353 Long = 94.84361
MW-5	rim	997.13	North	151.90	SW1/4,SE1/4,SE1/4,SW1/4
	top pipe	996.72	West	2937.52	Lat= 37.51425 Long = 94.84375

Lat & Long derived from Girard 7.5' quad map. WGS 84.

Elevation established from NGS BM A 253. NAVD 88.

If you have any questions, please feel free to call me. Thank you for the opportunity to be

