

WATER WELL RECORD (WWC-5)

KOLAR DOC ID _____ WELL ID _____
 Original Record Correction Change in Well Use

LOCATION OF WATER WELL

Latitude		Longitude		Section		Township		Range		E W	Fraction	¼	¼	¼
Datum		Elevation		County										

WATER WELL OWNER

Name	
Business	
Address	
Well location at owner's address	

WELL WATER USE

--

COMPLETION

Depth of completed well: _____ ft.
Depth(s) groundwater encountered: (1) _____ ft.; (2) _____ ft.; (3) _____ ft.; (4) dry well
Static water level in well: _____ ft. measured below land surface on (mm/dd/yy): _____ measured above land surface on (mm/dd/yy): _____
Estimated yield: _____ gpm
Water level was: _____ ft. after _____ hours pumping _____ gpm
Pump installed? Yes No
Water well disinfected? Yes No
Date disinfected (mm/dd/yy): _____
Aquifer, if known:

NEAREST SOURCE OF POTENTIAL CONTAMINATION

Source: _____
Distance from well: _____ Direction from well: _____
Source description: _____
Source: _____
Distance from well: _____ Direction from well: _____
Source description: _____
No potential source of contamination within 100 feet.

CONSTRUCTION

Borehole interval: from _____ to _____ ft.	Borehole diameter: _____ in.
from _____ to _____ ft.	_____ in.
Casing height above land surface: _____ in.	
If casing height is less than 12 in. has a variance been approved?* Yes No	
*variance not required for monitoring or environmental remediation wells	
Casing type: _____	
Blank casing interval: _____ ft. to _____ ft.	
Blank casing diameter: _____ in.	
Casing joints: _____	
Weight: _____ lbs/ft.	
Wall thickness or gauge no.: _____	
Blank casing interval: _____ ft. to _____ ft.	
Blank casing diameter: _____ in.	
Casing joints: _____	
Weight: _____ lbs/ft.	
Wall thickness or gauge no.: _____	
Grout interval: _____ ft. to _____ ft.	
Grout material: _____	
Grout interval: _____ ft. to _____ ft.	
Grout material: _____	
Screen / perforation material: _____	
Screen / perforation openings: _____	
Screen / perforation intervals: From _____ ft. to _____ ft.	
Slot size _____ unit _____	
From _____ ft. to _____ ft.	
Slot size _____ unit _____	
Gravel pack intervals: Gravel pack not used: Gravel size _____ in	
From _____ ft. to _____ ft.	
Gravel pack not used: Gravel size _____ in	
From _____ ft. to _____ ft.	

PERMIT & ID NUMBERS (AS REQUIRED)

DWR Application No.: _____
KDHE / EPA Project Code: _____
Site Name: _____
KDHE UIC Class V Form Completed: Yes No
County Permit: Yes No Permit ID: _____
Lease Name & Well #: _____
of boreholes: _____ # of dewatering wells: _____

LITHOLOGIC LOG

FROM	TO	LITHOLOGY INTERVALS

COMMENTS

--

CONTRACTOR'S OR LANDOWNERS CERTIFICATION

This water well was constructed reconstructed pursuant to the stated water well contractor's license and was completed on _____. I certify that this record is true to the best of my knowledge and belief. This water well record was completed on _____ under the business name of _____, Kansas Water Well Contractor's License No. _____ under the authority of the designated person as defined in K.A.R. 28-30-2(j) and signed and certified by the electronic signature of the designated person at its submittal: _____.

Send one copy to WATER WELL OWNER and retain one for your records. Fee of \$5.00 for each constructed well.

NOTE: Figures exhibited within this report are only to be used within the context of this report. Placement of property lines, wells, structures, and roads is based on the available information from county appraiser maps, surveys, site visits, and/or previous vendor reports and should be considered approximate.

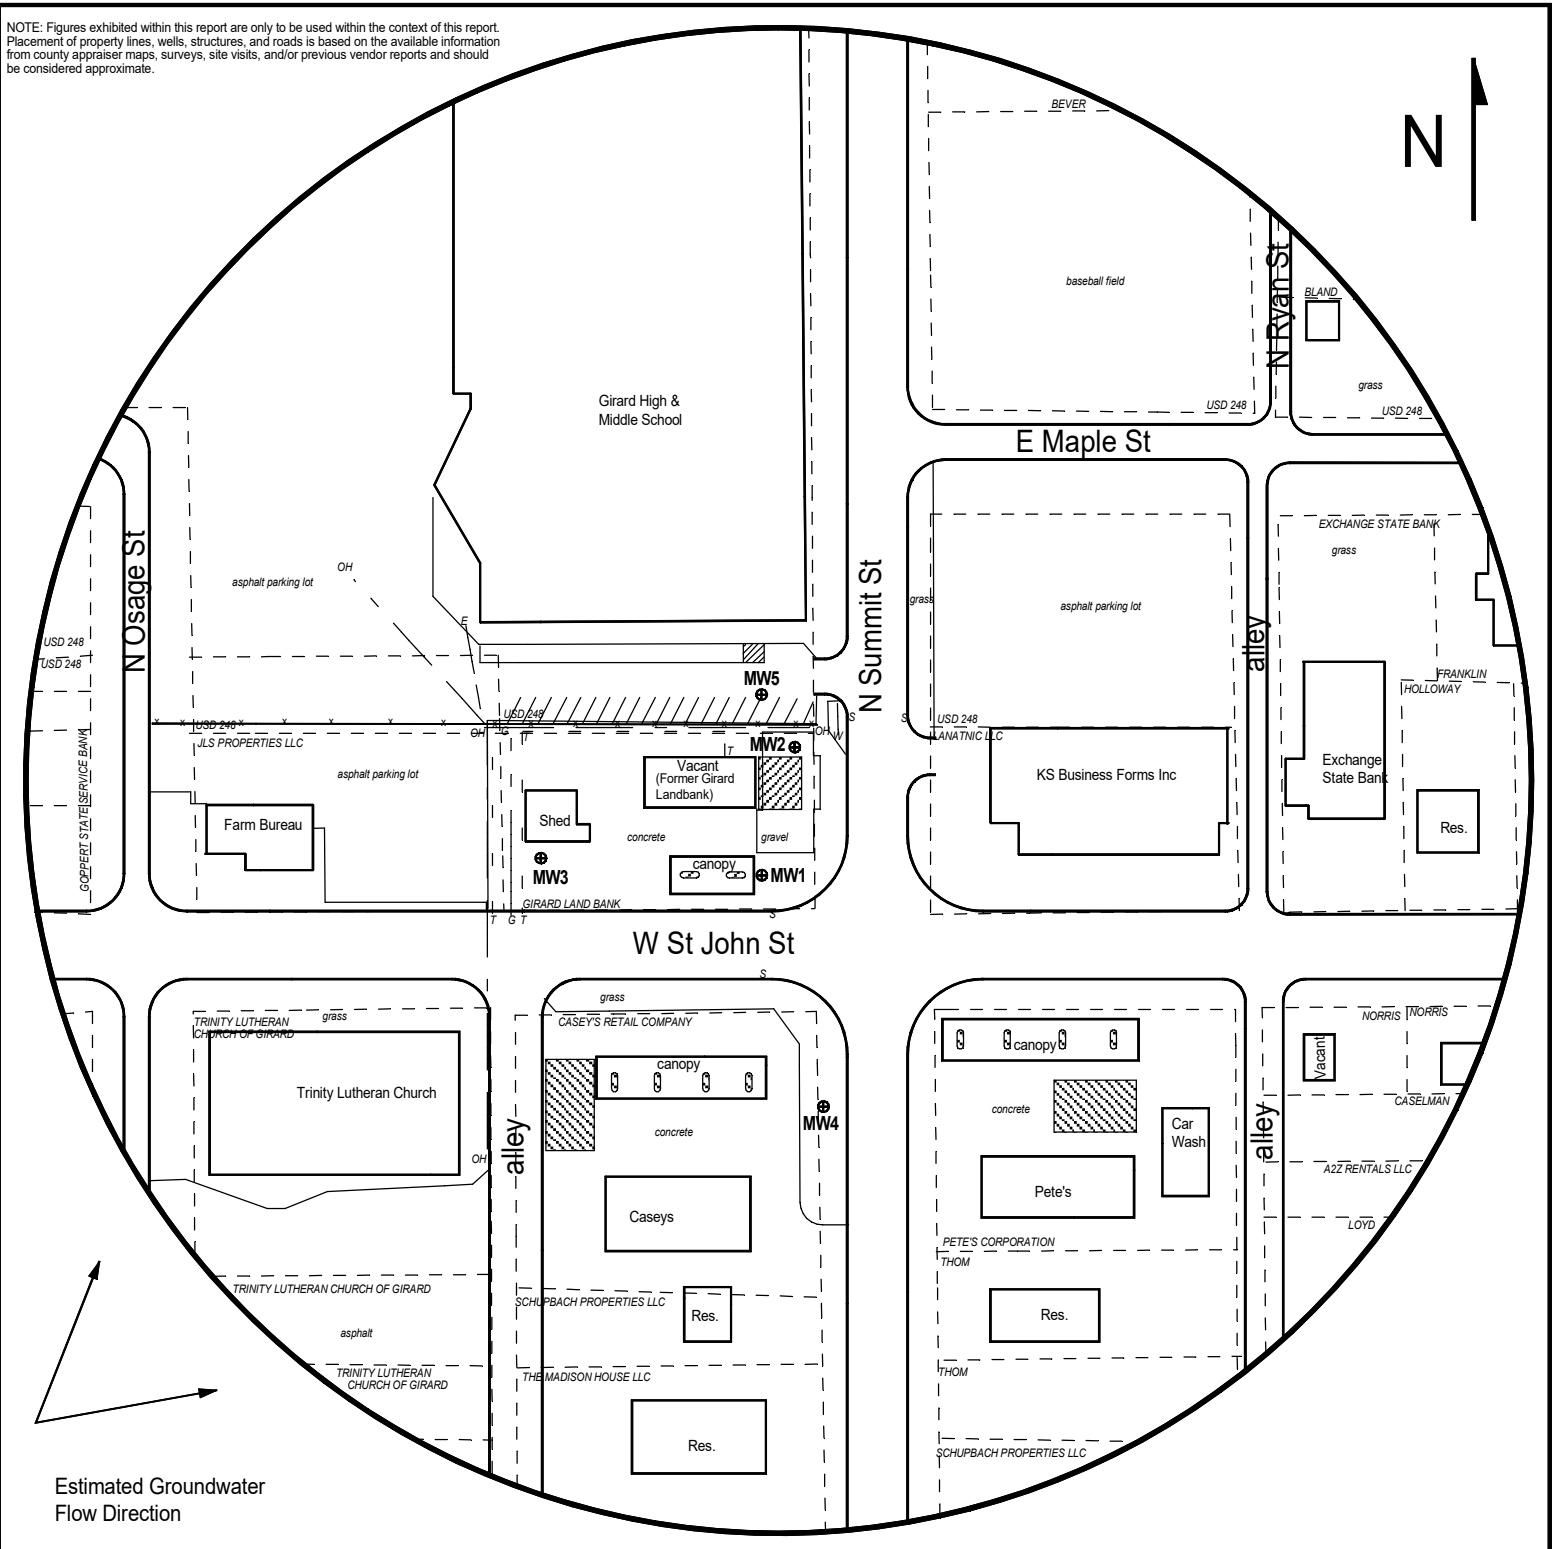





FIGURE 2 - 500 FT RADIUS AREA BASE MAP

LEGEND:

-  Approximate Location of Former UST Basin and Pump Island
-  Approximate Location of Active UST Basin and Pump Island
-  Newly Installed Monitoring Well

- OH ——— Overhead Lines (25-40 ft high)
- S ——— Sewer (2 - 6 ft BGS)
- W ——— Water (2 - 6 ft BGS)
- E ——— Electric (2 - 6 ft BGS)
- T ——— Telephone (2 - 6 ft BGS)
- G ——— Gas (2 - 6 ft BGS)

NOTE: SB5 and SB6 will be drilled to collect hydrologic samples.
NOTE: Utility depths, heights and locations are approximate.

PROJECT:

Girard Landbank
100 W St. John
Girard, KS
U3-019-15488
Date: 8/8/23



1311 E 25th St., Suite B (785) 841-8707 office
Lawrence, KS 66046 (785) 865-4282 fax

DENNIS L HANDKE

1820 NW 59th Terrace
TOPEKA, KANSAS 66618
785-286-4047 Home

Jess Chapman
Larsen & Associates
1311 E. 25th Street, Suite B
Lawrence, Kansas, 66046

October 10, 2023

RE: Monitor Well Elevation Survey
100 W. St. John, Girard, Kansas

Proj. 23-00GG
Girard Landbank
U3-019-15488

Bench Mark: Chisled Sq. on East edge of the East concrete pump island South of building.
Elev: 998.52 North 35.11 West 2940.59 (from SE Cor. Sec. 13-29-23E)

MW-1	rim	997.94	North	35.02	SW1/4,SE1/4,SE1/4,SW1/4
	top pipe	997.45	West	2932.35	Lat= 37.51393 Long = 94.84373
MW-2	rim	997.31	North	121.48	SE1/4,SE1/4,SE1/4,SW1/4
	top pipe	996.93	West	2903.09	Lat= 37.51417 Long = 94.84362
MW-3	rim	997.04	North	45.58	SW1/4,SE1/4,SE1/4,SW1/4
	top pipe	996.54	West	3083.81	Lat= 37.51396 Long = 94.84426
MW-4	rim	998.06	South	110.14	NE1/4,NE1/4,NE1/4,NW1/4 (Sec. 24-29-23)
	top pipe	997.76	West	2896.55	Lat= 37.51353 Long = 94.84361
MW-5	rim	997.13	North	151.90	SW1/4,SE1/4,SE1/4,SW1/4
	top pipe	996.72	West	2937.52	Lat= 37.51425 Long = 94.84375

Lat & Long derived from Girard 7.5' quad map. WGS 84.

Elevation established from NGS BM A 253. NAVD 88.

If you have any questions, please feel free to call me. Thank you for the opportunity to be of service to you.

