KOLAR Document ID: 1739217

WATER WELL RECORD (WWC-5)

KOLAR DOC ID

Correction

Lease Name & Well #: ____

of boreholes: _____ # of dewatering wells: _

Original Record

WELL ID Change in Well Use

LOCATION OF WATER WELL

Latitude	Longitude	Section	Township	Range	E W	Fraction	1⁄4	1⁄4	1⁄4
Datum	Elevation	County							

WATER WELL OWNER

Name					
Business					
Address					
Well location					
at owner's address					
CONSTRUCTION					

CONSTRUCTION

Borehole interval:	Borehole diameter:
fromtoft.	in.
fromto ft.	in.
Casing height above land su	
If casing height is less the has a variance been appr	
*variance not required for or environmental remed	Ų
Casing type:	
Blank casing interval:	ft. toft.
Blank casing diameter:	in.
Casing joints:	
Weight:lbs	s/ft.
Wall thickness or gauge	no.:
Blank casing interval:	ft. toft.
Blank casing diameter:	in.
Casing joints:	
Weight:lbs	s/ft.
Wall thickness or gauge	
Grout interval: ft. to	9ft.
Grout material:	
Grout interval: ft. to	9ft.
Grout material:	
Screen / perforation material	:
Screen / perforation opening	gs:
Screen / perforation intervals	8:
Fromft. to	_ft.
Slot size unit	
Fromft. to	_ft.
Slot size unit	
Gravel pack intervals:	
Gravel pack not used:	Gravel size in
From ft. to	
Gravel pack not used:	
From ft. to	

	County						
WELL WATER USE							
сом	PLETION						
Dep	th of compl	eted well	l:		ft.		
	th(s) groun						
(1)_	ft.;	(2)	ft.;				
(3) _	ft.;	(4)	lry well				
Stati	c water leve	el in well	:	ft.			
	neasured be on (mm/dd/		l surface				
-	neasured at on (mm/dd/		l surface				
Estiı	nated yield	:	_ gpm				
Wate	er level was	:	_ ft. after		hours		
		I	oumping		gpm		
Pun	np installed	Yes	No				
Wate	er well disir	fected?	Yes	No			

NEAREST SOURCE OF	POTENTIAL CONTAMINATION
Source:	
Distance from well:	Direction from well:
Source description:	
Source:	
Distance from well:	Direction
Source description:	
No potential sour within 100 feet.	ce of contamination
PERMIT & ID NUMBE	RS (AS REQUIRED)
DWR Application No).:
KDHE / EPA Project	Code:
Site Name:	
KDHE UIC Class V F	Form Completed: Yes No
County Permit: Yes	s No Permit ID:

Aquifer, if known:

Date disinfected (mm/dd/yy):


FROM	то	LITHOLOGY INTERVALS
	1	

COMMENTS

CONTRACTOR'S OR LANDOWNERS CERTIFICATION

This water well was constructed	reconstructed	pursuant to the stated water well				
contractor's license and was complete	I certify that this record is true to					
the best of my knowledge and belief.	This water well rec	ord was completed on				
under the business name of		,				
Kansas Water Well Contractor's Licer	nse No	_ under the authority of the designated				
person as defined in K.A.R. 28-30-2(j) and signed and certified by the electronic signature of the						
designated person at its submittal:		·				
Send one copy to WATER WELL OWNER a	and retain one for you	r records. Fee of \$5.00 for each constructed well.				
KANSAS DEPAR	TMENT OF HEALTH	AND ENVIRONMENT				

Bureau of Water, Geology Section, 1000 SW Jackson St., Suite 420, Topeka KS 66612-1367 (785) 296-3565 | K.S.A. 82a-1212 | v2022c

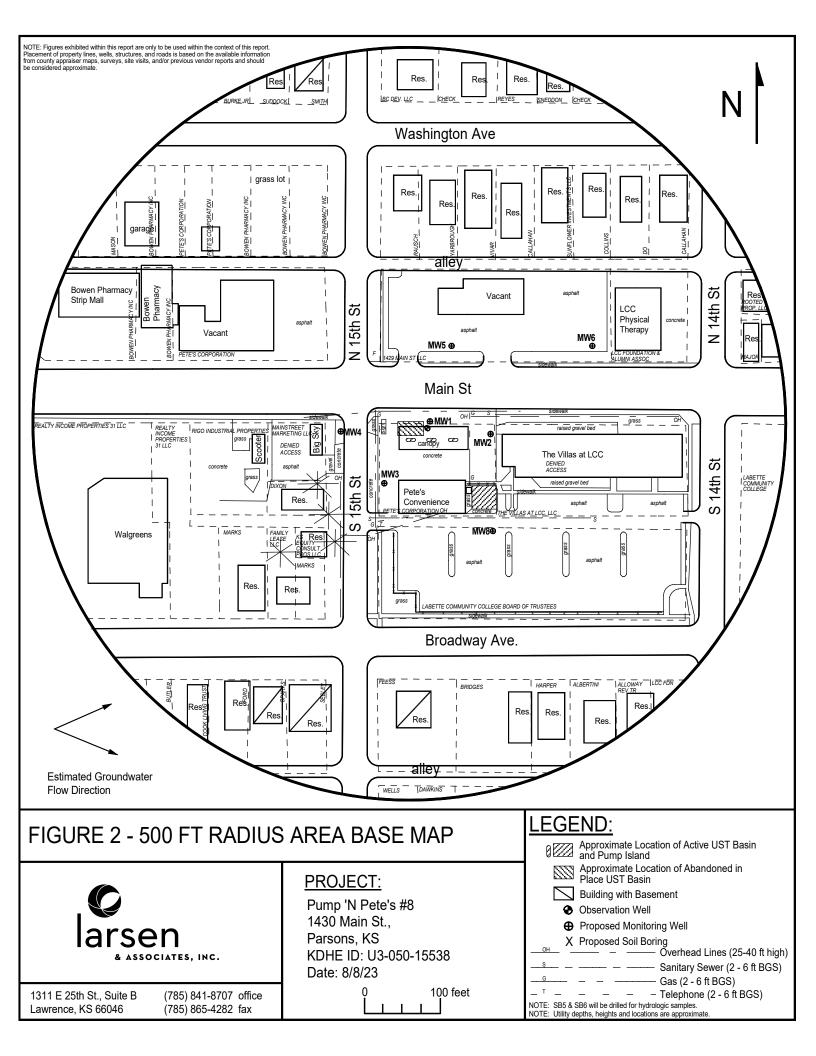

DENNIS L HANDKE 1820 NW 59th Terrace TOPEKA, KANSAS 66618 785-286-4047 Home

Jess Chapman Larsen & Associates

1311 E. 25th Street, Suite B Lawrence, Kansas 66046

RE: Monitor Well Elevation Survey 1430 Main, Parsons, Kansas

November 9, 2022 Revised November 28, 2023

> Proj. 23-00KK Pump 'N Pete's #8 KDHE ID U3-050-15538

Bench Mark: Chisled Sq. on top of NE bolt of North sign base near the Northwest corner of property.

Elev: 897.2	25 Nort	h 5337.79	West	2327.88	(from SE Cor. Sec. 19-31-20E)
MW-1	rim	896.14	North	5332.09	NE1/4,NW1/4,NW1/4,NE1/4
	top pipe	895.77	West	2271.83	Lat = 37.34036 Long = 95.25729
MW-2	rim	895.49	North	5324.29	NE1/4,NW1/4,NW1/4,NE1/4
	top pipe	895.14	West	2183.28	Lat = 37.34034 Long = 95.25698
MW-3	rim	895.55	North	5250.53	NE1/4,NW1/4,NW1/4,NE1/4
	top pipe	895.07	West	2332.73	Lat = 37.34014 Long = 95.25750
MW-4	rim	897.50	North	5323.12	NW1/4,NW1/4,NW1/4,NE1/4
	top pipe	897.00	West	23 8 2.45	Lat = 37.34034 Long = 95.25767
MW-5	rim	894.97	North	5426.03	SW1/4,SW1/4,SW1/4,SE1/4 (Sec. 18-31-20E)
	top pipe	894.34	West	2237.89	Lat = 37.34062 Long = 95.25717
MW-6	rim	890.76	North	5427.91	SE1/4,SW1/4,SW1/4,SE1/4 (Sec. 18-31-20E)
	top pipe	890.44	West	2067.19	Lat = 37.34062 Long = 95.25658
MW-8	rim	895.07	North	51 96.88	NE1/4,NW1/4,NW1/4,NE1/4
	top pipe	894.52	West	2187.44	Lat = 37.33999 Long = 95.25700

Elevation derived from NGS BM Z 54 RESET. NAVD 88

Lat & Long derived from Parsons West. 7.5 Quad Map WGS84

If you have any questions, please feel free to call me. Thank you for the opportunity to be of source to you. NSTER Thremsche Contract North Call North Contract NO SURVENTION NO SURVENTION