

WATER WELL RECORD (WWC-5)

KOLAR DOC ID _____ WELL ID _____
 Original Record Correction Change in Well Use

LOCATION OF WATER WELL

Latitude		Longitude		Section		Township		Range		E W	Fraction	¼	¼	¼
Datum		Elevation		County										

WATER WELL OWNER

Name	
Business	
Address	
Well location at owner's address	

WELL WATER USE

--

COMPLETION

Depth of completed well: _____ ft.
Depth(s) groundwater encountered: (1) _____ ft.; (2) _____ ft.; (3) _____ ft.; (4) dry well
Static water level in well: _____ ft. measured below land surface on (mm/dd/yy): _____ measured above land surface on (mm/dd/yy): _____
Estimated yield: _____ gpm
Water level was: _____ ft. after _____ hours pumping _____ gpm
Pump installed? Yes No
Water well disinfected? Yes No
Date disinfected (mm/dd/yy): _____
Aquifer, if known:

NEAREST SOURCE OF POTENTIAL CONTAMINATION

Source: _____
Distance from well: _____ Direction from well: _____
Source description: _____
Source: _____
Distance from well: _____ Direction from well: _____
Source description: _____
No potential source of contamination within 100 feet.

CONSTRUCTION

Borehole interval: from _____ to _____ ft.	Borehole diameter: _____ in.
from _____ to _____ ft.	_____ in.
Casing height above land surface: _____ in.	
If casing height is less than 12 in. has a variance been approved?* Yes No	
*variance not required for monitoring or environmental remediation wells	
Casing type: _____	
Blank casing interval: _____ ft. to _____ ft.	
Blank casing diameter: _____ in.	
Casing joints: _____	
Weight: _____ lbs/ft.	
Wall thickness or gauge no.: _____	
Blank casing interval: _____ ft. to _____ ft.	
Blank casing diameter: _____ in.	
Casing joints: _____	
Weight: _____ lbs/ft.	
Wall thickness or gauge no.: _____	
Grout interval: _____ ft. to _____ ft.	
Grout material: _____	
Grout interval: _____ ft. to _____ ft.	
Grout material: _____	
Screen / perforation material: _____	
Screen / perforation openings: _____	
Screen / perforation intervals: From _____ ft. to _____ ft.	
Slot size _____ unit _____	
From _____ ft. to _____ ft.	
Slot size _____ unit _____	
Gravel pack intervals: Gravel pack not used: Gravel size _____ in	
From _____ ft. to _____ ft.	
Gravel pack not used: Gravel size _____ in	
From _____ ft. to _____ ft.	

PERMIT & ID NUMBERS (AS REQUIRED)

DWR Application No.: _____
KDHE / EPA Project Code: _____
Site Name: _____
KDHE UIC Class V Form Completed: Yes No
County Permit: Yes No Permit ID: _____
Lease Name & Well #: _____
of boreholes: _____ # of dewatering wells: _____

LITHOLOGIC LOG

FROM	TO	LITHOLOGY INTERVALS


COMMENTS

--

CONTRACTOR'S OR LANDOWNERS CERTIFICATION

This water well was constructed reconstructed pursuant to the stated water well contractor's license and was completed on _____. I certify that this record is true to the best of my knowledge and belief. This water well record was completed on _____ under the business name of _____, Kansas Water Well Contractor's License No. _____ under the authority of the designated person as defined in K.A.R. 28-30-2(j) and signed and certified by the electronic signature of the designated person at its submittal: _____.

Send one copy to WATER WELL OWNER and retain one for your records. Fee of \$5.00 for each constructed well.

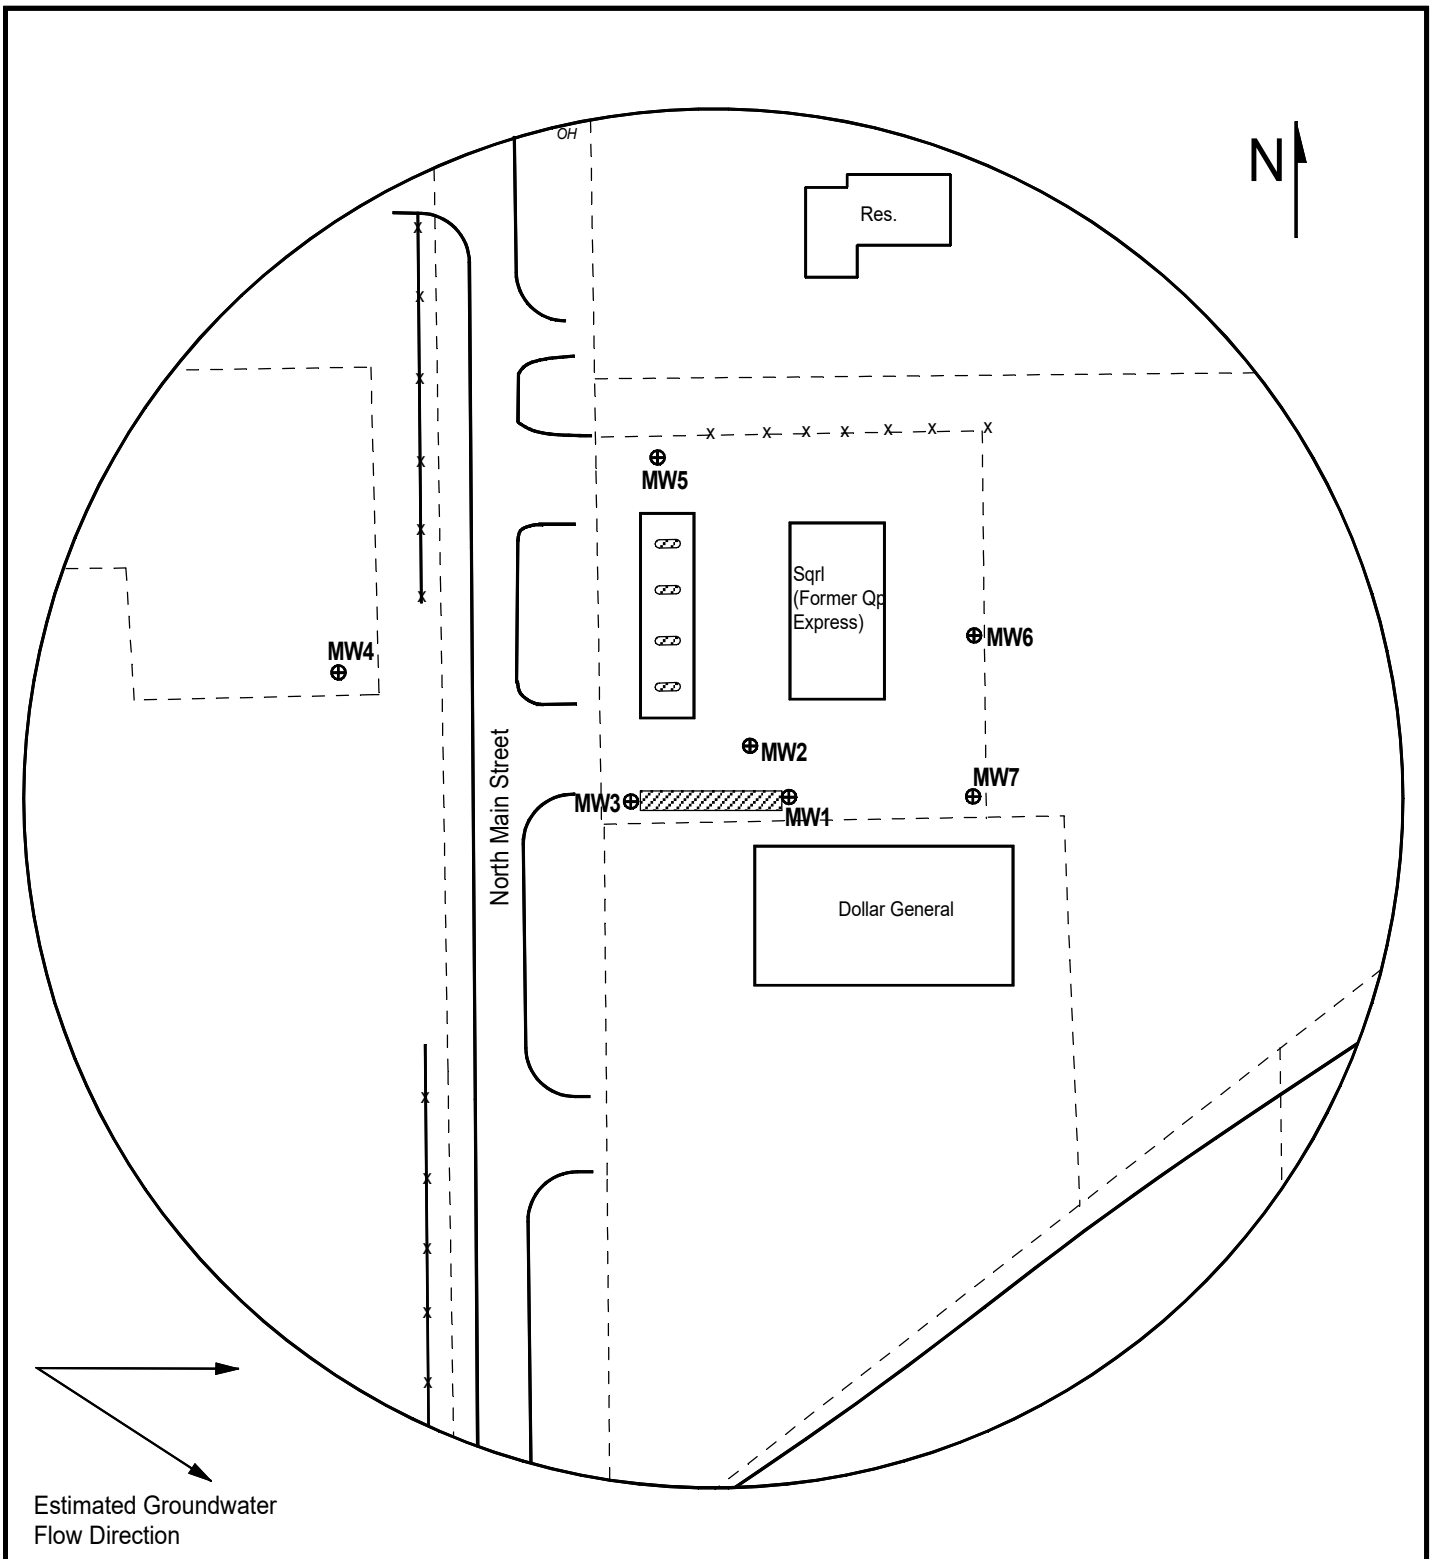

Estimated Groundwater
Flow Direction

FIGURE 3 - 350 FT RADIUS AREA BASE MAP

LEGEND:

- Approximate Location of Active UST Basin and Pump Islands
- New Monitoring Well (Installed 11/13-16/23)
- Soil Boring (Drilled 11/15/23)
- Overhead Lines
- Electric Lines (2 - 6 ft BGS)
- Telephone Lines (2 - 6 ft BGS)
- Sewer Manhole



PROJECT:

QP Express 102
1110 North Main
Cheney, KS
KDHE ID: U2-087-15349
Date: 11/16/23



1311 E 25th St., Suite B (785) 841-8707 office
Lawrence, KS 66046 (785) 865-4282 fax

NOTE: Utility depths and locations are approximate.

DENNIS L HANDKE

1820 NW 59th Terrace
TOPEKA, KANSAS 66618
785-286-4047 Home

Jess Chapman
Larsen & Associates
1311 E. 25th Street, Suite B
Lawrence, Kansas, 66046

December 8, 2023

RE: Monitor Well Elevation Survey
1110 N. Main St., Cheney, Kansas

Proj. 23-00NN
QP Express 102
U2-087-15349

Bench Mark: Chisled Sq. on the South center of concrete light base North of the gas pumps.
Elev: 1379.02 North 2408.29 West 2576.63 (from SE Cor. Sec. 5-28-4W)

MW-1	rim	1377.94	North	2219.27	SW1/4,NW1/4,NW1/4,SE1/4
	top pipe	1377.48	West	2494.70	Lat= 37.63893 Long = 97.78039
MW-2	rim	1377.63	North	2245.40	SW1/4,NW1/4,NW1/4,SE1/4
	top pipe	1377.26	West	2511.57	Lat= 37.63900 Long = 97.78045
MW-3	rim	1377.31	North	2216.29	SW1/4,NW1/4,NW1/4,SE1/4
	top pipe	1376.98	West	2571.15	Lat= 37.63892 Long = 97.78065
MW-4	rim	1377.06	North	2284.11	SE1/4,NE1/4,NE1/4,SW1/4
	top pipe	1376.83	West	2720.05	Lat= 37.63910 Long = 97.78117
MW-5	rim	1377.86	North	2395.86	NW1/4,NW1/4,NW1/4,SE1/4
	top pipe	1377.59	West	2571.66	Lat= 37.63941 Long = 97.78066
MW-6	rim	1375.99	North	2258.02	SW1/4,NW1/4,NW1/4,SE1/4
	top pipe	1375.57	West	2430.73	Lat= 37.63904 Long = 97.78017
MW-7	rim	1375.63	North	2215.30	SW1/4,NW1/4,NW1/4,SE1/4
	top pipe	1375.23	West	2418.42	Lat= 37.63892 Long = 97.78013

Lat & Long derived from Cheney 7.5' quad map. WGS 84.

Elevation established from existing USGS BM Y-312 1956. NAVD 88

If you have any questions, please feel free to call me. Thank you for the opportunity to be of service to you.

