WELL ID

KOLAR DOC ID

WATER WELL RECORD (WWC-5)

OCATION OF WATER WE	LL					Original Rec	ord Co	orrection	Chang	e in Wel	l Use	
Latitude	Longitude		Secti	on	Township	Range	e E		1/4	1/4	1/4	
Datum	Elevation		Cour	nty			•					
WATER WELL OWNER		'	WELL WATER USE				NEAREST	NEAREST SOURCE OF POTENTIAL CONTAMINATION				
Name							Source:					
Business			COMPLETIC	ON					Directio from we			
			Depth of co	nmplete	ed well:	ft.		Ш;	from we	11:		
Address					rater encountered:		Source descripti	on:				
					2) ft.;		Source:					
Well location					dry well		Distance		Dinastia			
			Static wate	r level ii	n well:	 t.	from wel	ll:	from we	11:		
at owner's address			measured below land surface on (mm/dd/yy):					Source description:				
CONSTRUCTION									ce of contami	nation		
Borehole interval: Borehole diameter:			measured above land surface on (mm/dd/yy):					within 100 feet.				
fromto ft.		in.	Estimated yield: gpm				PERMIT & ID NUMBERS (AS REQUIRED)					
fromtoft.		in.			ft. after	hours	DWR Ap	pplication No	.:			
Casing height above land surface: in.					pumping	gpm	KDHE / EPA Project Code:					
If casing height is less than 12 in.			Pump installed? Yes No					Site Name:				
has a variance been app		s No	Water well	disinfe	cted? Vac No			KDHE UIC Class V Form Completed: Yes No				
*variance not required for monitoring or environmental remediation wells			Water well disinfected? Yes No Date disinfected (mm/dd/yy):					County Permit: Yes No Permit ID:				
Casing type:			Date districted (mm/ dd/yy).				Lease Name & Well #: # of boreholes: # of dewatering wells:					
Blank casing interval:	ft. to	ft.	Aquifer, if	known:			# Of DOTE		# of dewate	ring wells:		
Blank casing diameter:			LITHOLOGI	C LOG								
Casing joints:			FROM	то	LITHOLOGY	NTERVALS						
Weight:ll												
Wall thickness or gauge												
Blank casing diameters		ft.										
Blank casing diameter: Casing joints:												
Weight: ll		— <u> </u>										
Wall thickness or gauge												
Grout interval: ft.												
Grout interval: ft. 1												
Grout material:			COMMENT	S								
Screen / perforation material Screen / perforation opening			CONTRAC	OD/C C	R LANDOWNERS	CEDTIFICATIO	NI .					
Screen / perforation openin	·								41	11		
recen / perforation intervals: This water well was constructed reconstructed pursuant to the stated water well Fromft. toft. contractor's license and was completed on I certify that this record is true to												
Slot size unit						_		-				
From ft. to				•	nowledge and be			•				
Slot size unit					ess name of							
Gravel pack intervals:					ell Contractor's				-	_		
Gravel pack not used:	Gravel size	in	•		d in K.A.R. 28-3	, .	ned and certi	ified by the	electronic si	gnature o	f the	
From ft. to	ft.				on at its submitta			· ·				
Gravel pack not used:	Gravel size	in S	Send one co	py to W	ATER WELL OW		•			constructe	ed well.	
From ft. to	ft.		I	Bureau o	of Water, Geology	E PARTMENT OF Section, 1000 SV 85) 296-3565 K	V Jackson St.,	Suite 420, Top		2-1367		

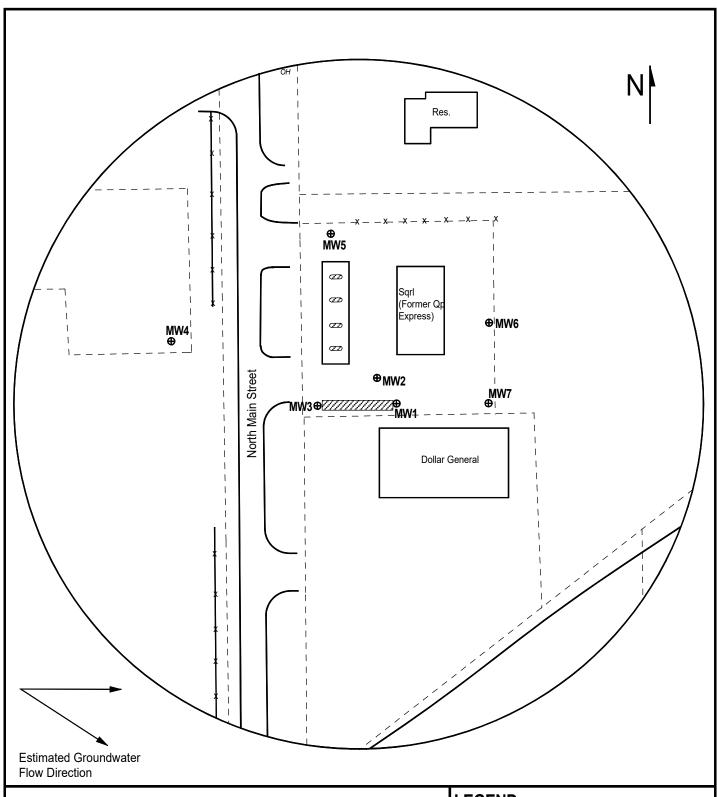


FIGURE 3 - 350 FT RADIUS AREA BASE MAP



1311 E 25th St., Suite B Lawrence, KS 66046 (785) 841-8707 office (785) 865-4282 fax

PROJECT:

QP Express 102 1110 North Main Cheney, KS KDHE ID: U2-087-15349 Date: 11/16/23

0 100 ft

LEGEND:

θ Approximate Location of Active UST Basin and Pump Islands

◆ New Monitoring Well (Installed 11/13-16/23)

X Soil Boring (Drilled 11/15/23)

OH --- -- Overhead Lines

E - Electric Lines (2 - 6 ft BGS)

- - Telephone Lines (2 - 6 ft BGS)

s Sewer Manhole

NOTE: Utility depths and locations are approximate.

DENNIS L HANDKE

1820 NW 59th Terrace TOPEKA, KANSAS 66618 785-286-4047 Home

Jess Chapman Larsen & Associates 1311 E. 25th Street, Suite B Lawrence, Kansas, 66046 December 8, 2023

RE: Monitor Well Elevation Survey 1110 N. Main St., Cheney, Kansas

Proj. 23-00NN QP Express 102 U2-087-15349

Bench Mark: Chisled Sq. on the South cer Elev: 1379.02 North 2408.29				er of concrete Vest 2576.63	
	rim	1377.94	North	2219.27	SW1/4,NW1/4,NW1/4,SE1/4
	top pipe	1377.48	West	2494.70	Lat= 37.63893 Long = 97.78039
	rim	1377.63	North	2245.40	SW1/4,NW1/4,NW1/4,SE1/4
	top pipe	1377.26	West	2511.57	Lat= 37.63900 Long = 97.78045
	rim	1377.31	North	2216.29	SW1/4,NW1/4,NW1/4,SE1/4
	top pipe	1376.98	West	2571.15	Lat= 37.63892 Long = 97.78065
	rim	1377.06	North	2284.11	SE1/4,NE1/4,NE1/4,SW1/4
	top pipe	1376.83	West	2720.05	Lat= 37.63910 Long = 97.78117
	rim	1377.86	North	2395.86	NW1/4,NW1/4,NW1/4,SE1/4
	top pipe	1377.59	West	2571.66	Lat= 37.63941 Long = 97.78066
	rim	1375.99	North	2258.02	SW1/4,NW1/4,NW1/4,SE1/4
	top pipe	1375.57	West	2430.73	Lat= 37.63904 Long = 97.78017
	rim	1375.63	North	2215.30	SW1/4,NW1/4,NW1/4,SE1/4
	top pipe	1375.23	West	2418.42	Lat= 37.63892 Long = 97.78013

Lat & Long derived from Cheney 7.5' quad map. WGS 84.

Elevation established from existing USGS BM Y-312 1956. NAVD 88

If you have any questions, please feel free to call me. Thank you for the opportunity to be

OSTER

SURVEY OR THE