KOLAR Document ID: 1747412

WATER WELL RECORD (WWC-5)

KOLAR DOC ID

Source: Distance

from well:

Source description:

Source:

Distance

Source

from well:

description:

Site Name:

within 100 feet.

DWR Application No.:_

Lease Name & Well #:

KDHE / EPA Project Code:

Correction

Original Record

ft.

gpm

WELL ID Change in Well Use

NEAREST SOURCE OF POTENTIAL CONTAMINATION

No potential source of contamination

KDHE UIC Class V Form Completed: Yes No

County Permit: Yes No Permit ID:

of boreholes: _____ # of dewatering wells: _

PERMIT & ID NUMBERS (AS REQUIRED)

Direction

from well:

Direction

from well:

LOCATION OF WATER WELL

Latitude	Longitude	Section	Township	Range	E W	Fraction	1⁄4	1⁄4	1⁄4
Datum	Elevation	County							

WATER WELL OWNER

Name	
Business	
Address	
Well location	
at owner's address	
CONCERNICE	

CONSTRUCTION

Borehole interval:	Borehole diameter:
fromtoft.	in.
fromtoft.	in.
Casing height above land su	
If casing height is less th has a variance been appr *variance not required fo or environmental reme	roved?* Yes No or monitoring
Casing type:	
Blank casing interval:	ft. toft.
Blank casing diameter:	in.
Casing joints:	
Weight:lbs	s/ft.
Wall thickness or gauge	no.:
Blank casing interval:	ft. toft.
Blank casing diameter:	in.
Casing joints:	
Weight:lbs	s/ft.
Wall thickness or gauge	no.:
Grout interval: ft. to	pft.
Grout material:	
Grout interval: ft. to	oft.
Grout material:	
Screen / perforation material	
Screen / perforation opening	
Screen / perforation intervals	
From ft. to	
Slot size unit	
From ft. to	
Slot size unit	
Gravel pack intervals:	
Gravel pack not used:	Gravel size in
From ft. to	
Gravel pack not used:	
From ft. to	

WELL WATER USE COMPLETION Depth of completed well: Depth(s) groundwater encountered: ft.; (2) ft.; (1)

(3) ft.; (4) dry well ft. Static water level in well: measured below land surface on (mm/dd/yy): measured above land surface on (mm/dd/yy): Estimated viald anm

Estimated yield:	gpm	
Water level was:	ft. after	hours

pumping _

Pump installed? Yes No

Water well disinfected? Yes No

Date disinfected (mm/dd/yy):

Aquifer, if known:

LIT


ITHOLOG	THOLOGIC LOG						
FROM	то	LITHOLOGY INTERVALS					


COMMENTS

CONTRACTOR'S OR LANDOWNERS CERTIFICATION

This water well was constructed	reconstructed	pursuant to the stated water well
contractor's license and was complete	ed on	I certify that this record is true to
the best of my knowledge and belief.	This water well rec	ord was completed on
under the business name of		,
Kansas Water Well Contractor's Licer	nse No	_ under the authority of the designated
person as defined in K.A.R. 28-30-2(j) and signed and c	ertified by the electronic signature of the
designated person at its submittal:		·
Send one copy to WATER WELL OWNER a	and retain one for you	r records. Fee of \$5.00 for each constructed well
KANSAS DEPAR	TMENT OF HEALTH	AND ENVIRONMENT


Bureau of Water, Geology Section, 1000 SW Jackson St., Suite 420, Topeka KS 66612-1367 (785) 296-3565 | K.S.A. 82a-1212 | v2022c

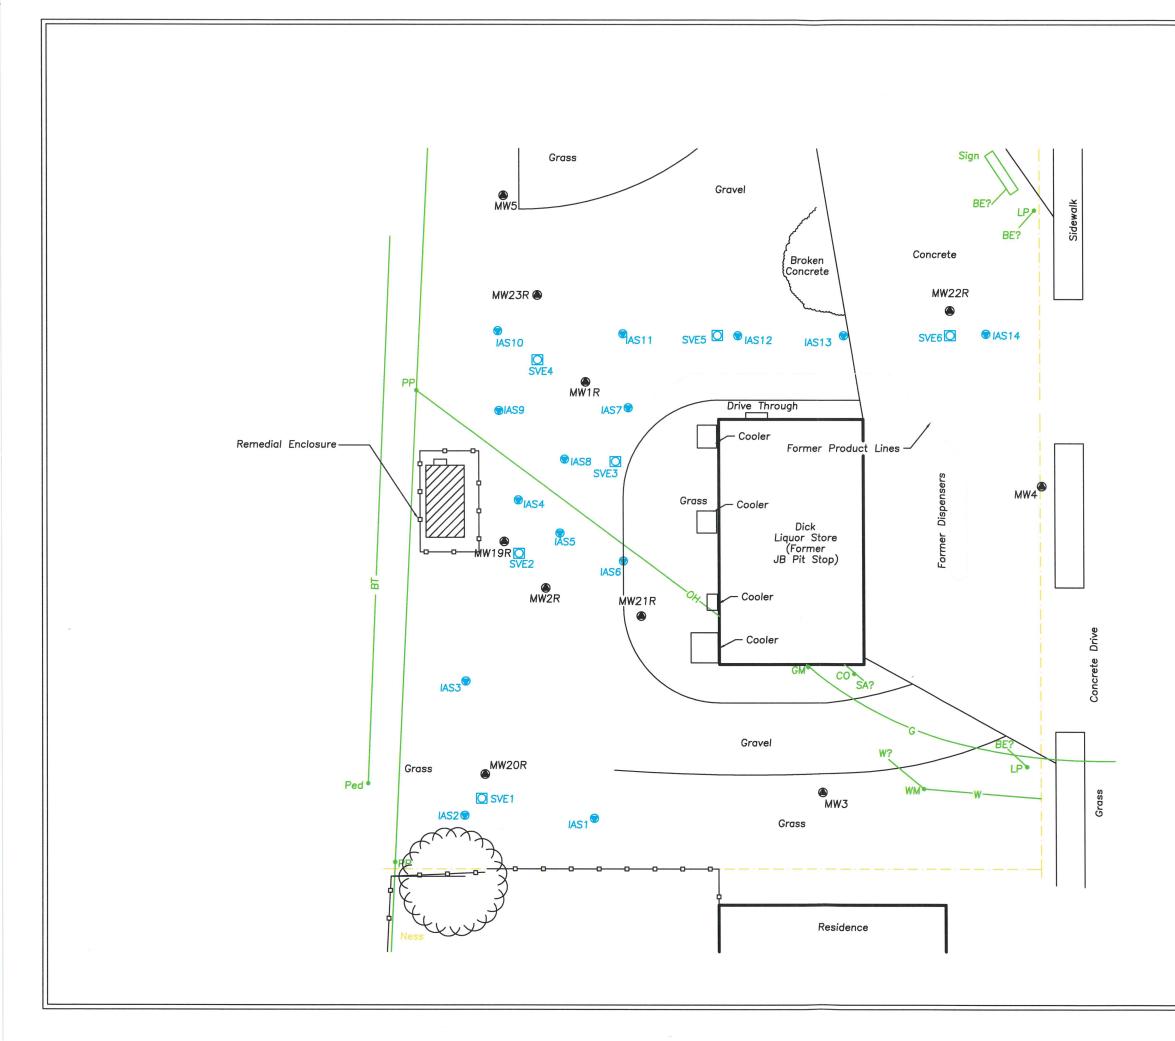

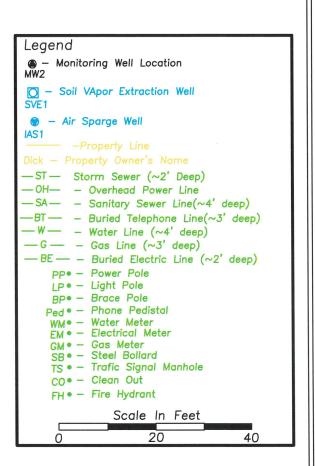

N

Site Base Map (Wells Only)					
JB Pit Stop					
Erie, Kansas KDHE Project Code: U3–067–14493					
Final Remedial Report					
CGP Project #22952					
Prepared By: MK Date: 01-06-2023					
Revised By: MK Date: 12-23-2023					
Figure 3.1.2					
CGP, Inc. PO Box 23, Wahoo, NE 68066					

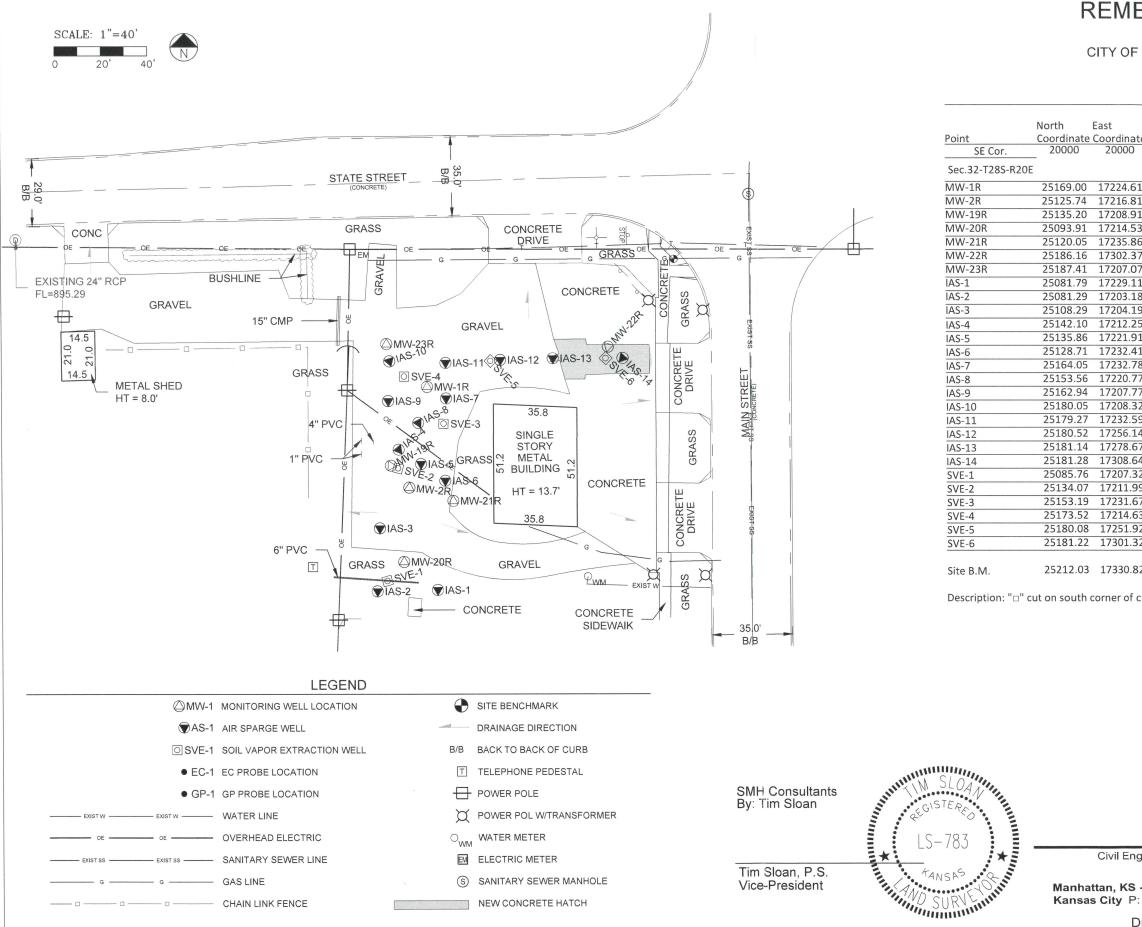

REMEDIAL SITE SURVEY

JB PIT STOP

CITY OF ERIE, NEOSHO COUNTY, KANSAS

	Distan	ce from	*Elev. Top	Elev. Top	Latitude	Longitude
	SE Cor. Sec. 32		of Rim or	of PVC Pipe	North	West
te	North	West	PK Nail			
1	F1C0 00	2775 20	897.24	896.69	37.57217	95.24393
51	5169.00	2775.39 2783.19	897.24	896.69	37.57205	95.24395
31					37.57205	95.24396
)1	5135.20	2791.09	897.55	896.89		
3	5093.91	2785.47	897.36	896.69	37.57196	95.24397
86	5120.05	2764.14	897.51	897.09	37.57203	95.24390
37	5186.16	2697.63	896.70	896.25	37.57221	95.24367
)7	5187.41	2792.93	897.56	896.73	37.57222	95.24399
.1	5081.79	2770.89	897.65	897.30	37.57193	95.24392
.8	5081.29	2796.82	897.20	896.40	37.57193	95.24401
9	5108.29	2795.81	897.30	896.60	37.57200	95.24400
25	5142.10	2787.75	897.50	897.34	37.57209	95.24398
91	5135.86	2778.09	897.42	896.70	37.57208	95.24394
11	5128.71	2767.59	897.41	897.38	37.57206	95.24391
78	5164.05	2767.22	897.14	896.26	37.57215	95.24391
77	5153.56	2779.23	897.30	896.56	37.57212	95.24395
77	5162.94	2792.23	897.50	896.67	37.57215	95.24399
32	5180.05	2791.68	897.52	896.61	37.57220	95.24399
59	5179.27	2767.41	897.25	896.21	37.57219	95.24391
L4	5180.52	2743.86	897.12	896.07	37.57220	95.24382
57	5181.14	2721.33	896.90	896.29	37.57220	95.24375
54	5181.28	2691.36	896.70	896.04	37.57220	95.24364
32	5085.76	2792.68	897.35	896.52	37.57194	95.24399
99	5134.07	2788.01	897.51	896.49	37.57207	95.24398
57	5153.19	2768.33	897.13	896.35	37.57212	95.24391
53	5173.52	2785.37	897.33	896.94	37.57218	95.24397
92	5180.08	2748.08	897.11	896.33	37.57220	95.24384
32	5181.22	2698.68	896.75	896.32	37.57220	95.24367

25212.03 17330.82 5212.03 2669.18 B.M. Elev. = 896.14

Description: "
□" cut on south corner of curb inlet at southwest quadrant of Main Street and State Street



Civil Engineering • Land Surveying • Landscape Architecture www.smhconsultants.com

 Manhattan, KS - HQ
 P: (785) 776-0541
 Dodge City, KS
 P: (620) 255-1952

 Kansas City
 P: (913) 444-9615
 Colorado Springs, CO
 P: (719) 428-8677

Drawn By:RJC Project #2309-0340 TDS #94