Change in Well Use

WELL ID

Correction

KOLAR DOC ID


(785) 296-3565 | K.S.A. 82a-1212 | v2022c


Original Record

WATER WELL RECORD (WWC-5)

LOCATION	OF V	/ATER WELL	L												
Latitude			Longitude			Section		Township		Range	E W	Fraction	1/4	1/4	1/4
Datum			Elevation			County									
WATER WI	ELL O	VNER			WELL	. WATER U	SE				NEAREST S	OURCE OF F	POTENTIAL (ONTAMI	NATION
Name											Source:				
Business					СОМІ	PLETION					Distance from well-		Direction we		
Address								ell:encountered:		ft.	Source description				
Well location				(3)	(1) ft.; (2) ft.; (3) ft.; (4) dry well					Dietance		Directio	on ell:		
at owner's address				n	Static water level in well: ft. measured below land surface on (mm/dd/yy):					Source description:					
CONSTRU	CTION	ı				neasured a		nd surface					e of contam	ination	
Borehole interval: Borehole diameter:				О	on (mm/dd/yy):					within 100 feet.					
fromto ftin.				Estir	nated yield	l:	gpm			PERMIT & ID NUMBERS (AS REQUIRED)					
fromto ft in.				Wate	er level wa	8:	ft. after	ho	urs	DWR Application No.:					
Casing he	eight al	ove land sur	rface:	in.				pumping	gp	m	KDHE / E	PA Project (Code:		
		ght is less tha			Pum	p installed	? Ye	s No			Site Name:				
		ce been appr		s No	Mate	w wall disi	nfactadi	Vac N			KDHE UIC Class V Form Completed: Yes No				
*variance not required for monitoring or environmental remediation wells				Water well disinfected? Yes No Date disinfected (mm/dd/yy):						County Permit: Yes No Permit ID:					
Casing type:					Date disinfected (mm/dd/yy).						Lease Name & Well #: # of boreholes: # of dewatering wells:				I
Blank cas	ing int	erval:	ft. to	ft.	Aqui	ifer, if kno	wn:				# Of boren	nes:	# of dewate	ring wells:	
Blank cas	ing dia	meter:	in.		LITHO	DLOGIC LO	OG								
Casin	g joint	s:			FRC	M T) L	ITHOLOGY I	NTERVA	LS					
		lbs													
			no.:												
	-		ft. to	ft.											
	-	meter:	in.												
Weigh		lbs													
		ess or gauge r													
		ft. to													
		rial:ft_to													
Grout interval: ft. to ft. Grout material:					СОМІ	MENTS									
Screen / p	erfora	tion material:	:												
Screen / p	erfora	tion opening	gs:		CONT	RACTOR	S OR LA	ANDOWNERS	CERTIF	ICATION					
Screen / perforation intervals:				This water well was constructed reconstructed pursuant to the stated water well											
From _		ft. to	_ft.		cont	tractor's l	icense a	and was com	pleted o	on	•	I certify tha	at this reco	d is true	to
Slot	size _	unit _			the	best of m	y know	ledge and be	- elief. Thi	is water v	well record v	vas comple	ted on		
_		ft. to	_												
		unit _									un				
Gravel pa											d and certifi		-	_	
			Gravel size _	in	1			t its submitta	•			,		0	
		_ ft. to								retain on	e for your reco	ords. Fee of \$	5.00 for each	construct	ed well
			Gravel size	in	o ciid (COP) to					EALTH AND				
rrom		_ ft. to	ft.			Bure	au of Wa				Jackson St., Sı			2-1367	



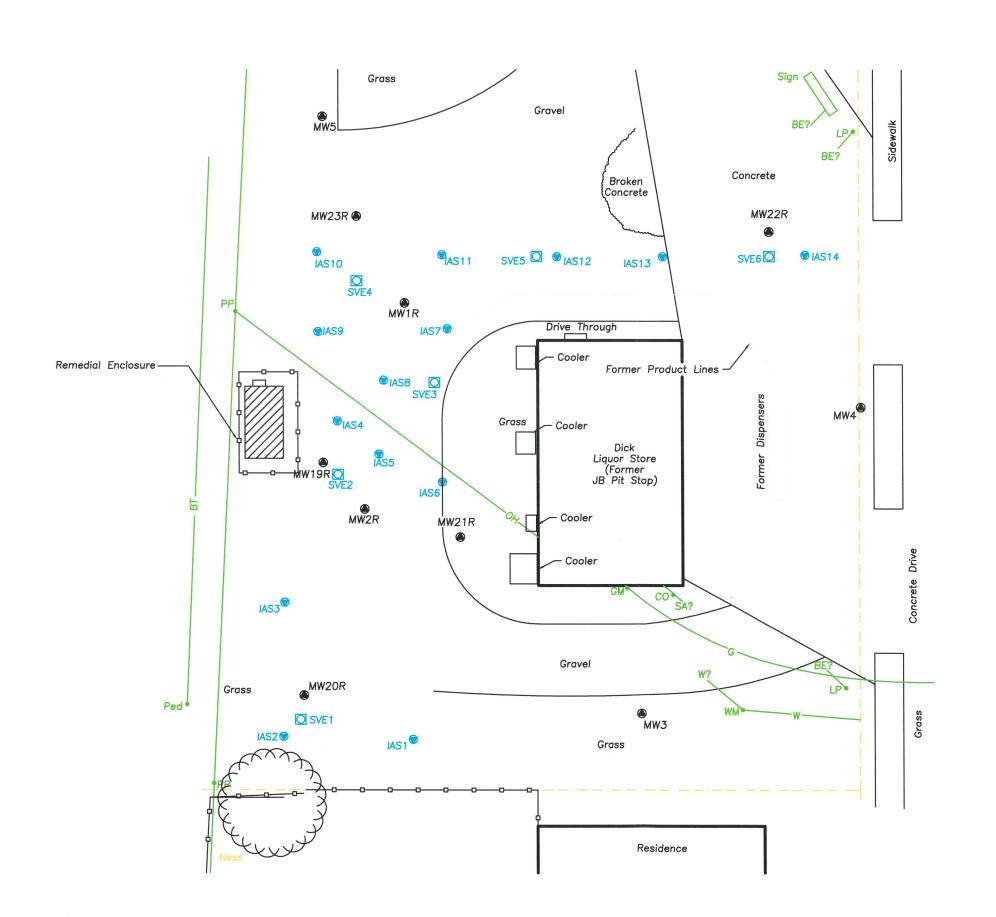

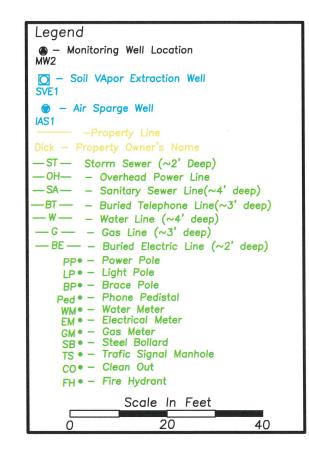

Site Base Map (Wells Only)

JB Pit Stop Erie, Kansas

KDHE Project Code: U3-067-14493


Final Remedial Report

CGP Project #22952

Prepared By: MK Date: 01-06-2023 Revised By: MK Date: 12-23-2023

Figure 3.1.2

CGP, Inc. PO Box 23, Wahoo, NE 68066

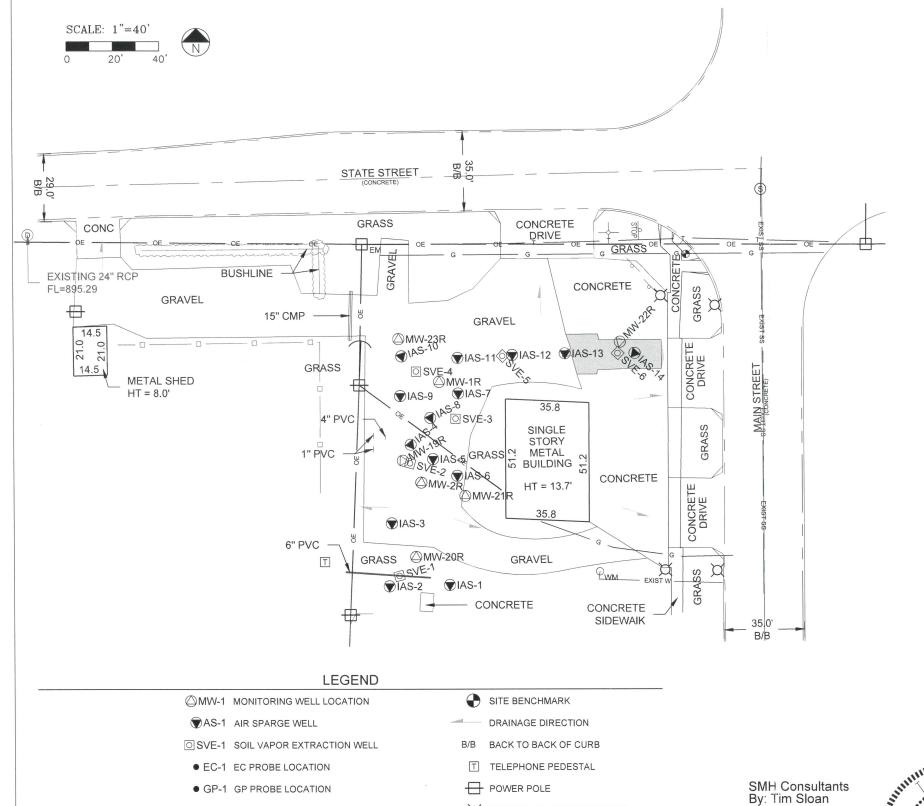

— WATER LINE

GAS LINE

OVERHEAD ELECTRIC

SANITARY SEWER LINE

CHAIN LINK FENCE

POWER POL W/TRANSFORMER

S SANITARY SEWER MANHOLE

NEW CONCRETE HATCH

○_{WM} WATER METER

EM ELECTRIC METER


REMEDIAL SITE SURVEY

JB PIT STOP CITY OF ERIE, NEOSHO COUNTY, KANSAS

	N	- ·	Distanc SE Cor.			Elev. Top of PVC Pipe	Latitude North	Longitude West
D		East	North	West	PK Nail	of PVC Pipe	NOILII	vvest
Point SE Cor.	Coordinate 20000	20000	NOLLII	West	PNIVall			
SE COL.		20000						
Sec.32-T28S-R2	:0E							
MW-1R	25169.00	17224.61	5169.00	2775.39	897.24	896.69	37.57217	95.24393
MW-2R	25125.74	17216.81	5125.74	2783.19	897.65	897.56	37.57205	95.24396
MW-19R	25135.20	17208.91	5135.20	2791.09	897.55	896.89	37.57207	95.24399
MW-20R	25093.91	17214.53	5093.91	2785.47	897.36	896.69	37.57196	95.24397
MW-21R	25120.05	17235.86	5120.05	2764.14	897.51	897.09	37.57203	95.24390
MW-22R	25186.16	17302.37	5186.16	2697.63	896.70	896.25	37.57221	95.24367
MW-23R	25187.41	17207.07	5187.41	2792.93	897.56	896.73	37.57222	95.24399
IAS-1	25081.79	17229.11	5081.79	2770.89	897.65	897.30	37.57193	95.24392
IAS-2	25081.29	17203.18	5081.29	2796.82	897.20	896.40	37.57193	95.24401
IAS-3	25108.29	17204.19	5108.29	2795.81	897.30	896.60	37.57200	95.24400
IAS-4	25142.10	17212.25	5142.10	2787.75	897.50	897.34	37.57209	95.24398
IAS-5	25135.86	17221.91	5135.86	2778.09	897.42	896.70	37.57208	95.24394
IAS-6	25128.71	17232.41	5128.71	2767.59	897.41	897.38	37.57206	95.24391
IAS-7	25164.05	17232.78	5164.05	2767.22	897.14	896.26	37.57215	95.24391
IAS-8	25153.56	17220.77	5153.56	2779.23	897.30	896.56	37.57212	95.24395
IAS-9	25162.94	17207.77	5162.94	2792.23	897.50	896.67	37.57215	95.24399
IAS-10	25180.05	17208.32	5180.05	2791.68	897.52	896.61	37.57220	95.24399
IAS-11	25179.27	17232.59	5179.27	2767.41	897.25	896.21	37.57219	95.24391
IAS-12	25180.52	17256.14	5180.52	2743.86	897.12	896.07	37.57220	95.24382
IAS-13	25181.14	17278.67	5181.14	2721.33	896.90	896.29	37.57220	95.24375
IAS-14	25181.28	17308.64	5181.28	2691.36	896.70	896.04	37.57220	95.24364
SVE-1	25085.76	17207.32	5085.76	2792.68	897.35	896.52	37.57194	95.24399
SVE-2	25134.07	17211.99	5134.07	2788.01	897.51	896.49	37.57207	95.24398
SVE-3	25153.19	17231.67	5153.19	2768.33	897.13	896.35	37.57212	95.24391
SVE-4	25173.52	17214.63	5173.52	2785.37	897.33	896.94	37.57218	95.24397
SVE-5	25180.08	17251.92	5180.08	2748.08	897.11	896.33	37.57220	95.24384
SVE-6	25181.22	17301.32	5181.22	2698.68	896.75	896.32	37.57220	95.24367
Site B.M.	25212.03	17330.82	5212.03	2669.18	B.M. Elev	v. = 896.14		

Description: "

" cut on south corner of curb inlet at southwest quadrant of Main Street and State Street

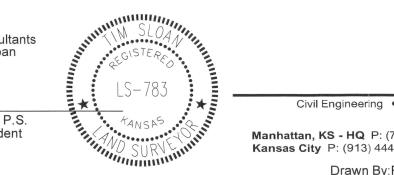

Tim Sloan, P.S.

Vice-President



Civil Engineering • Land Surveying • Landscape Architecture www.smhconsultants.com

Manhattan, KS - HQ P: (785) 776-0541 • **Dodge City, KS** P: (620) 255-1952 **Kansas City** P: (913) 444-9615 • **Colorado Springs, CO** P: (719) 428-8677

Drawn By:RJC Project #2309-0340 TDS #94