

WATER WELL RECORD (WWC-5)

KOLAR DOC ID _____ WELL ID _____
 Original Record Correction Change in Well Use

LOCATION OF WATER WELL

Latitude		Longitude		Section		Township		Range		E W	Fraction		¼		¼		¼
Datum		Elevation		County													

WATER WELL OWNER

Name	
Business	
Address	
Well location	
at owner's address	

WELL WATER USE

--

COMPLETION

Depth of completed well: _____ ft.
 Depth(s) groundwater encountered:
 (1) _____ ft.; (2) _____ ft.;
 (3) _____ ft.; (4) dry well

Static water level in well: _____ ft.
 measured below land surface on (mm/dd/yy): _____
 measured above land surface on (mm/dd/yy): _____

Estimated yield: _____ gpm
 Water level was: _____ ft. after _____ hours
 pumping _____ gpm

Pump installed? Yes No

Water well disinfected? Yes No
 Date disinfected (mm/dd/yy): _____

Aquifer, if known: _____

NEAREST SOURCE OF POTENTIAL CONTAMINATION

Source: _____
 Distance from well: _____ Direction from well: _____
 Source description: _____

Source: _____
 Distance from well: _____ Direction from well: _____
 Source description: _____

No potential source of contamination within 100 feet.

CONSTRUCTION

Borehole interval: from _____ to _____ ft.	Borehole diameter: _____ in.
from _____ to _____ ft.	_____ in.
Casing height above land surface: _____ in. If casing height is less than 12 in. has a variance been approved?* Yes No *variance not required for monitoring or environmental remediation wells	
Casing type: _____	
Blank casing interval: _____ ft. to _____ ft.	
Blank casing diameter: _____ in.	
Casing joints: _____	
Weight: _____ lbs/ft.	
Wall thickness or gauge no.: _____	
Blank casing interval: _____ ft. to _____ ft.	
Blank casing diameter: _____ in.	
Casing joints: _____	
Weight: _____ lbs/ft.	
Wall thickness or gauge no.: _____	
Grout interval: _____ ft. to _____ ft.	
Grout material: _____	
Grout interval: _____ ft. to _____ ft.	
Grout material: _____	
Screen / perforation material: _____	
Screen / perforation openings: _____	
Screen / perforation intervals: From _____ ft. to _____ ft.	
Slot size _____ unit _____	
From _____ ft. to _____ ft.	
Slot size _____ unit _____	
Gravel pack intervals: Gravel pack not used: Gravel size _____ in	
From _____ ft. to _____ ft.	
Gravel pack not used: Gravel size _____ in	
From _____ ft. to _____ ft.	

PERMIT & ID NUMBERS (AS REQUIRED)

DWR Application No.: _____
 KDHE / EPA Project Code: _____
 Site Name: _____
 KDHE UIC Class V Form Completed: Yes No
 County Permit: Yes No Permit ID: _____
 Lease Name & Well #: _____
 # of boreholes: _____ # of dewatering wells: _____

LITHOLOGIC LOG

FROM	TO	LITHOLOGY INTERVALS


COMMENTS

--

CONTRACTOR'S OR LANDOWNERS CERTIFICATION

This water well was constructed reconstructed pursuant to the stated water well contractor's license and was completed on _____. I certify that this record is true to the best of my knowledge and belief. This water well record was completed on _____ under the business name of _____, Kansas Water Well Contractor's License No. _____ under the authority of the designated person as defined in K.A.R. 28-30-2(j) and signed and certified by the electronic signature of the designated person at its submittal: _____.

Send one copy to WATER WELL OWNER and retain one for your records. Fee of \$5.00 for each constructed well.

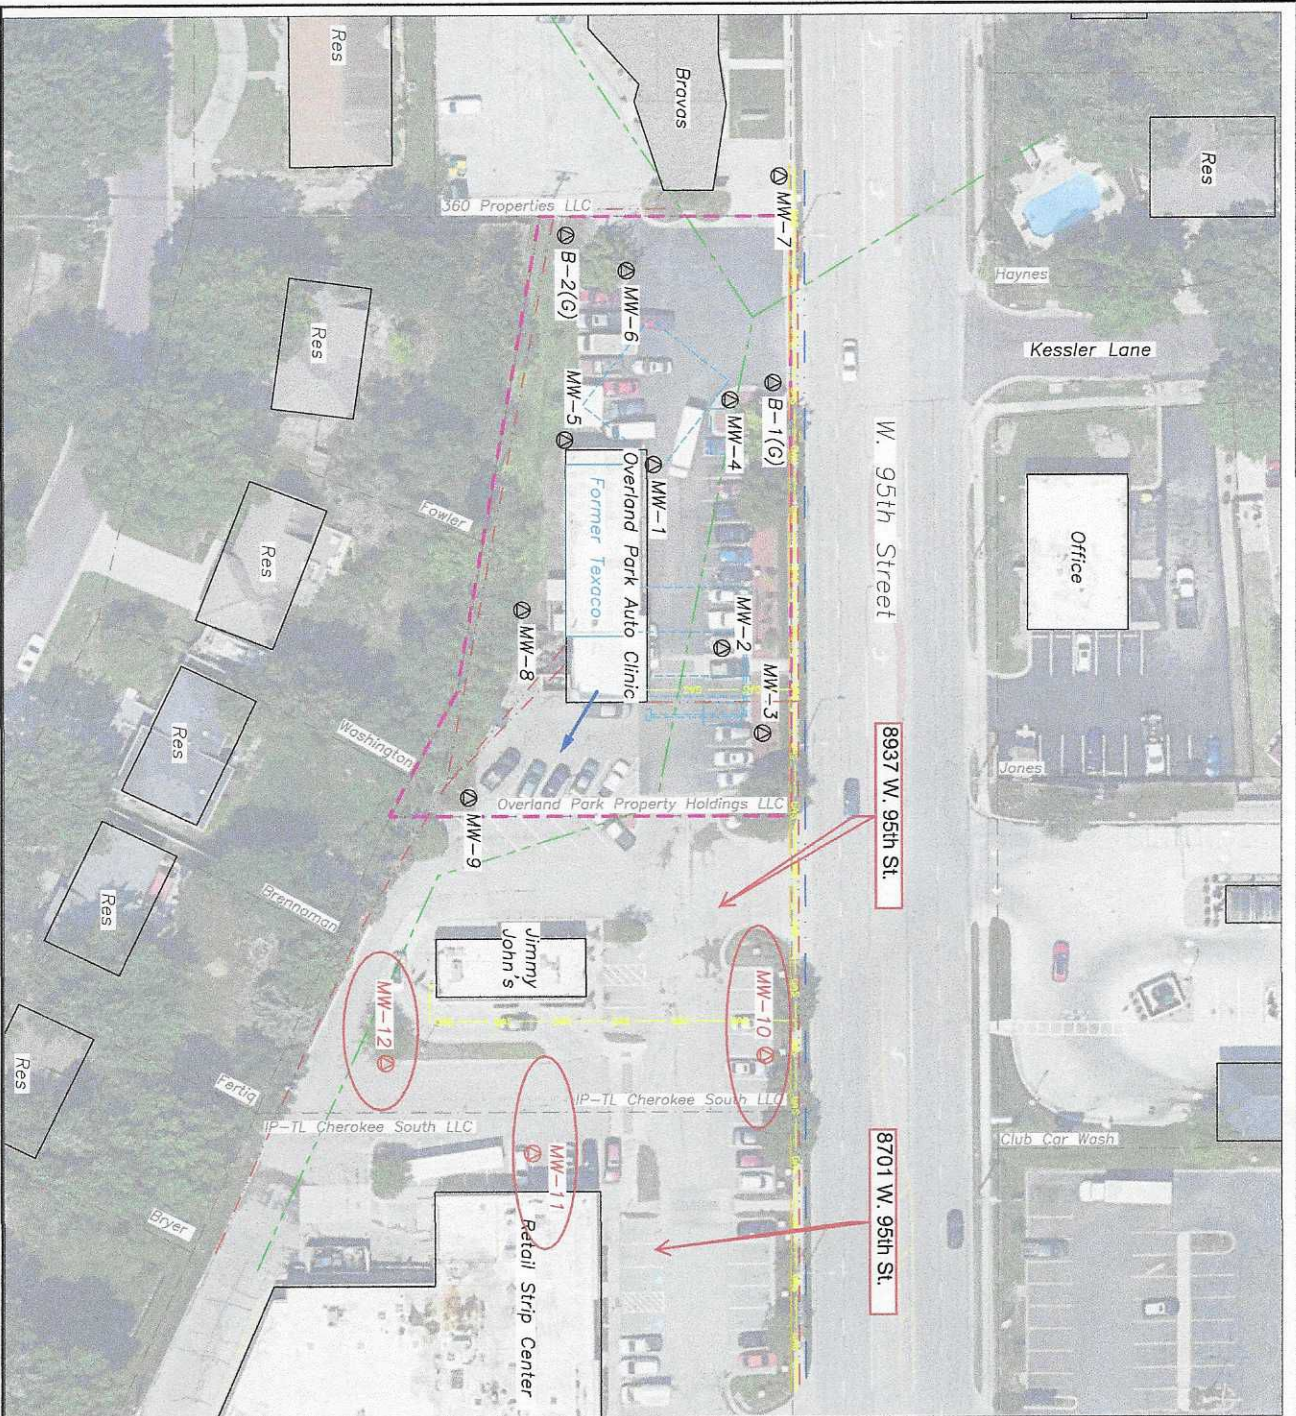

LEGEND:

- PROPOSED MONITORING WELL
- EXISTING MONITORING WELL
- FORMER UST BASIN/PUMP ISLAND/LINES
- ▭ APPROXIMATE PROJECT SITE BOUNDARY
- PROPERTY LINE/OWNERS
- FENCE LINE
- OVERHEAD ELECTRIC LINE
- GAS LINE (APPROX. 1.5-3')
- TELEPHONE LINE (APPROX. 1.5 TO 3')
- WATER LINE (APPROX. 2-6')
- STORM SEWER LINE (APPROX. 1.5 TO 3')
- GROUNDWATER FLOW DIRECTION

NOTES:

1. UTILITY LOCATIONS/DEPT'S, FORMER UST'S/PUMP ISLAND LINES, AND MONITORING WELL LOCATIONS ARE APPROXIMATE BASED ON LIMITED SITE OBSERVATIONS AND PLOTTED MAPS PROVIDED BY A/C/E.

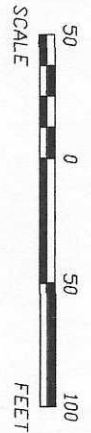


FIGURE 1 - SITE MAP

CLIENT: TEXACO, OVERLAND PARK (U4-046-01291) 9001 W. 95TH STREET OVERLAND PARK, KANSAS		SCS ENGINEERS 8575 West 110th Street, Suite 100 Overland Park, Kansas 66210	
DRAWN BY: LAM CHECKED BY: LAM ELECTRONIC FILE NAME: 27223560.00	DESIGNED BY: LAM DATE: 1/11/2024 PROJECT WBS: SLIM TEXACO OP. LSA. EQ. DRG.	R5 R4 R3 R2 R1 RD	5BY 4BY 3BY 2BY 1BY 0BY
REV: 0 DRAWING NUMBER: 1 PROJECT NUMBER: 27223560.00	REV. DATE BY DESCRIPTION		