

WATER WELL RECORD (WWC-5)

KOLAR DOC ID _____ WELL ID _____

Original Record Correction Change in Well Use

LOCATION OF WATER WELL

Latitude		Longitude		Section		Township		Range		E W	Fraction	¼	¼	¼
Datum		Elevation		County										

WATER WELL OWNER

Name	
Business	
Address	
Well location at owner's address	

WELL WATER USE

--

COMPLETION

Depth of completed well: _____ ft.
Depth(s) groundwater encountered:
(1) _____ ft.; (2) _____ ft.;
(3) _____ ft.; (4) dry well
Static water level in well: _____ ft.
measured below land surface
on (mm/dd/yy): _____
measured above land surface
on (mm/dd/yy): _____
Estimated yield: _____ gpm
Water level was: _____ ft. after _____ hours
pumping _____ gpm
Pump installed? Yes No
Water well disinfected? Yes No
Date disinfected (mm/dd/yy): _____
Aquifer, if known:

NEAREST SOURCE OF POTENTIAL CONTAMINATION

Source: _____
Distance from well: _____ Direction from well: _____
Source description: _____
Source: _____
Distance from well: _____ Direction from well: _____
Source description: _____
No potential source of contamination within 100 feet.

CONSTRUCTION

Borehole interval:	Borehole diameter:
from _____ to _____ ft.	_____ in.
from _____ to _____ ft.	_____ in.
Casing height above land surface: _____ in.	
If casing height is less than 12 in. has a variance been approved?*	Yes No
*variance not required for monitoring or environmental remediation wells	
Casing type: _____	
Blank casing interval: _____ ft. to _____ ft.	
Blank casing diameter: _____ in.	
Casing joints: _____	
Weight: _____ lbs/ft.	
Wall thickness or gauge no.: _____	
Blank casing interval: _____ ft. to _____ ft.	
Blank casing diameter: _____ in.	
Casing joints: _____	
Weight: _____ lbs/ft.	
Wall thickness or gauge no.: _____	
Grout interval: _____ ft. to _____ ft.	
Grout material: _____	
Grout interval: _____ ft. to _____ ft.	
Grout material: _____	
Screen / perforation material: _____	
Screen / perforation openings: _____	
Screen / perforation intervals:	
From _____ ft. to _____ ft.	
Slot size _____ unit _____	
From _____ ft. to _____ ft.	
Slot size _____ unit _____	
Gravel pack intervals:	
Gravel pack not used: Gravel size _____ in	
From _____ ft. to _____ ft.	
Gravel pack not used: Gravel size _____ in	
From _____ ft. to _____ ft.	

PERMIT & ID NUMBERS (AS REQUIRED)

DWR Application No.: _____
KDHE / EPA Project Code: _____
Site Name: _____
KDHE UIC Class V Form Completed: Yes No
County Permit: Yes No Permit ID: _____
Lease Name & Well #: _____
of boreholes: _____ # of dewatering wells: _____

LITHOLOGIC LOG

FROM	TO	LITHOLOGY INTERVALS

COMMENTS

--

CONTRACTOR'S OR LANDOWNERS CERTIFICATION


This water well was constructed reconstructed pursuant to the stated water well contractor's license and was completed on _____. I certify that this record is true to the best of my knowledge and belief. This water well record was completed on _____ under the business name of _____, Kansas Water Well Contractor's License No. _____ under the authority of the designated person as defined in K.A.R. 28-30-2(j) and signed and certified by the electronic signature of the designated person at its submittal: _____.

Send one copy to WATER WELL OWNER and retain one for your records. Fee of \$5.00 for each constructed well.

Form	WWC5.2 - Water Well Record
Doc ID	1768553
Well Owner	Kwik Shop, Inc.
Contractor	GSI Engineering, LLC

Lithology

From	To	Lithology Intervals
0	4	sand,fine,silty,brown,WELL GRADED SAND - 4" concrete, sand, fine to very fine, well sorted, slightly moist, no odor, brown, trace of silt and clay.
4	5	sand,fine,clayey,- Clayey
5	6	sand,fine,tan,- Tan
6	7	sand,very fine,dry,- Very fine sand, well sorted, dry, no odor.
7	9.5	sand,fine to medium,slightly moist,POORLY GRADED SAND - Medium to fine grained, moderately to poorly sorted, slightly moist, no odor.
9.5	12.5	sand,fine,tan,slightly moist,WELL GRADED SAND - Fine sand, tan, well sorted, slightly moist, no odor.
12.5	18	sand,fine to medium,wet,- Medium to fine grained, moderately sorted, wet, no odor.
18	18.5	sand,coarse,- Coarsens near the bottom.

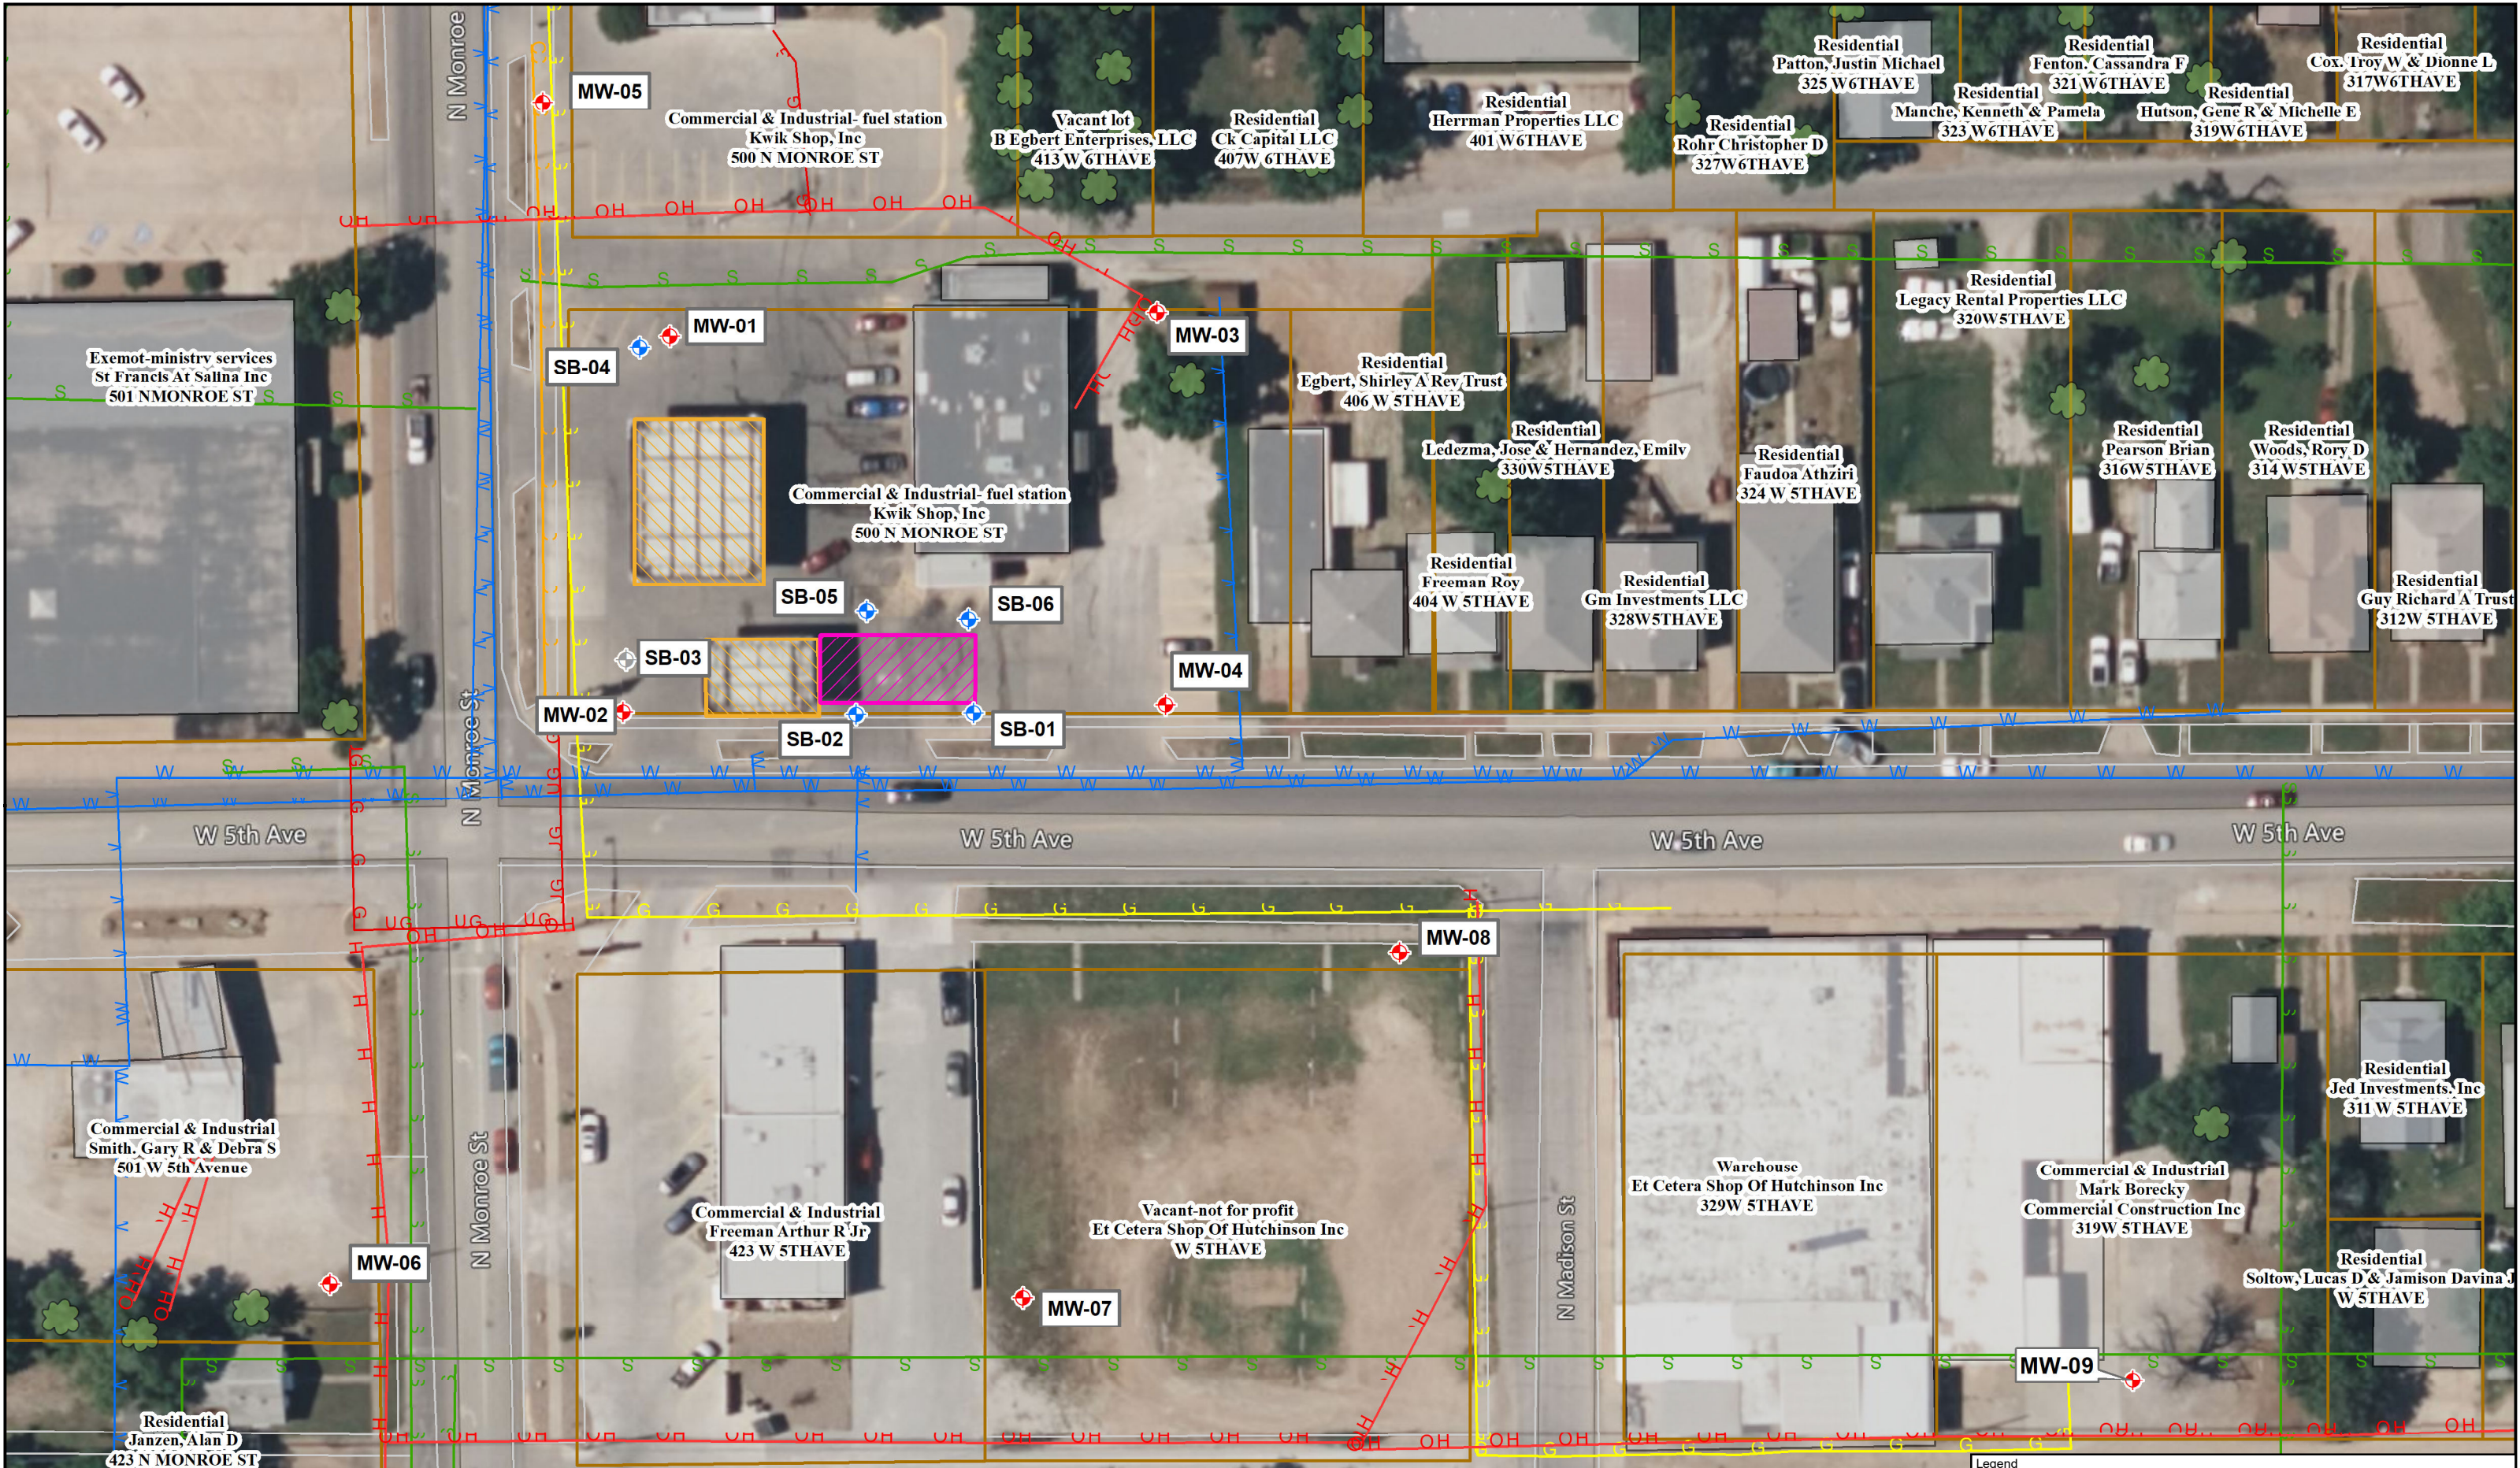

 A Universal Engineering Sciences Company	FIGURE: 2.2	FIGURE NAME: Site Base Map 1" = 50'	Kwik Shop 726R 500 North Monroe Hutchinson, KS KDHE Project Code: U2-078-15427	<div>0 25 50 Feet Scale: 1 in = 50 ft</div> <div></div>
	DATE: 01/15/2024	PROJECT NUMBER: 23W2161.01		
	DRAWN BY: PM	PROJECT MANAGER: ACHADD		

Legend

-  Tree
-  PROPOSED SOIL BORING
-  SOIL BORING/GREY
-  PROPOSED MONITORING WELL
-  Communication
-  Electric
-  Gas
-  Sewer
-  UG Elec
-  Water
-  Estimated Current Tank Basin
-  Pump Island
-  Property Owners
-  Easement
-  Building Footprint

ALL BOUNDARIES AND LOCATIONS ARE APPROXIMATE