KOLAR Document ID: 1774539

WATER WELL RECORD (WWC-5)

KOLAR DOC ID

Source: _ Distance

from well:

from well:

Site Name:

within 100 feet.

DWR Application No.:_____ KDHE / EPA Project Code: ____

Lease Name & Well #:

Source description:

Source description: Source: _____ Distance

Correction

Original Record

WELL ID_____ Change in Well Use

NEAREST SOURCE OF POTENTIAL CONTAMINATION

No potential source of contamination

KDHE UIC Class V Form Completed: Yes No

County Permit: Yes No Permit ID: ____

of boreholes: _____ # of dewatering wells: _

PERMIT & ID NUMBERS (AS REQUIRED)

Direction

from well:

Direction

from well:

LOCATION OF WATER WELL

Latitude	Longitude	Section	Township	Range	E W	Fraction	1⁄4	1⁄4	1⁄4
Datum	Elevation	County							

WATER WELL OWNER

Name					
Business					
Address					
Well location					
at owner's address					
CONCERNICEION					

CONSTRUCTION

Borehole interval:	Borehole diameter:
fromtoft.	in.
fromtoft.	in.
Casing height above land su	
If casing height is less th has a variance been app	roved?* Yes No
*variance not required for or environmental reme	
Casing type:	
Blank casing interval:	ft. toft.
Blank casing diameter:	in.
Casing joints:	
Weight:lb	s/ft.
Wall thickness or gauge	no.:
Blank casing interval:	ft. toft.
Blank casing diameter:	in.
Casing joints:	
Weight:lb	s/ft.
Wall thickness or gauge	
Grout interval: ft. to	oft.
Grout material:	
Grout interval: ft. to	oft.
Grout material:	
Screen / perforation material	l:
Screen / perforation opening	gs:
Screen / perforation interval	s:
Fromft. to	_ft.
Slot size unit	
Fromft. to	_ft.
Slot size unit	
Gravel pack intervals:	
Gravel pack not used:	Gravel size in
From ft. to	
Gravel pack not used:	
From ft. to	

	County						
WELL	WATER U	SE					
сомі	PLETION						
Dept	th of compl	eted w	ell:			ft.	
Dept	th(s) groun	dwater	en	countere	ed:		
(1)_	ft.;	(2)		ft.;			
(3) _	ft.;	(4)	dı	ry well			
Static water level in well: ft.							
measured below land surface on (mm/dd/yy):							
	neasured ab n (mm/dd/		nd	surface			
Estir	nated yield	:		gpm			
Wate	er level was:			ft. after _		hours	
			рı	umping _		gpm	
Pum	p installed	Ye	es	No			

Water well disinfected? Yes No

Date disinfected (mm/dd/yy):

Aquifer, if known:

LITHOLOGIC LOG


FROM	то	LITHOLOGY INTERVALS					

COMMENTS

CONTRACTOR'S OR LANDOWNERS CERTIFICATION

This water well was constructed	reconstructed	pursuant to the stated water well				
contractor's license and was complete	I certify that this record is true to					
the best of my knowledge and belief.	This water well rec	ord was completed on				
under the business name of		,				
Kansas Water Well Contractor's Lice	nse No	_ under the authority of the designated				
person as defined in K.A.R. 28-30-2(j) and signed and certified by the electronic signature of the						
designated person at its submittal:						
Send one copy to WATER WELL OWNER	and retain one for you	r records. Fee of \$5.00 for each constructed well.				
KANSAS DEPAR	TMENT OF HEALTH	AND ENVIRONMENT				

Bureau of Water, Geology Section, 1000 SW Jackson St., Suite 420, Topeka KS 66612-1367 (785) 296-3565 | K.S.A. 82a-1212 | v2022c

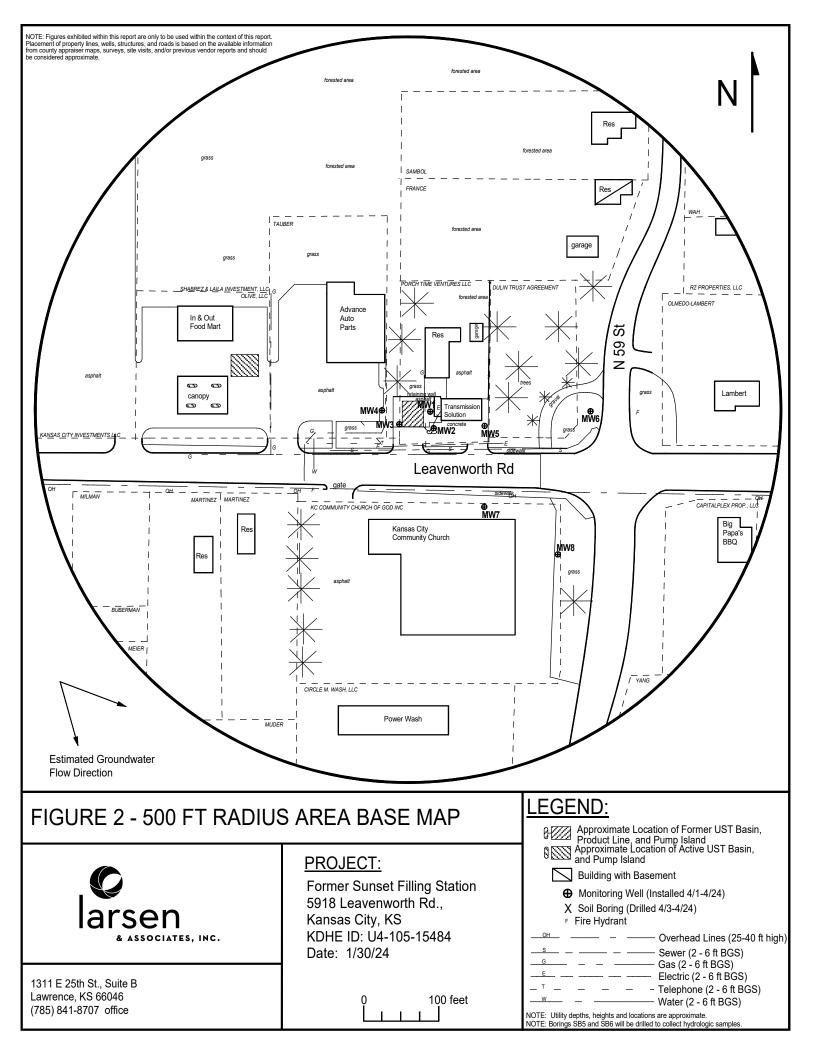

DENNIS L HANDKE 1820 NW 59th Terrace TOPEKA, KANSAS 66618 785-286-4047 Home

Jess Chapman Larsen & Assoc. 1311 E. 25th St., Suite B Topeka, Kansas 66046

RE: Monitor Well Elevation Survey 5918 Leavenworth Road, Kansas City, Kansas Proj. 24-00Q Former Sunset Filling Station KDHE ID U4-105-15484

Bench Mark: Chisled Sq. on West center of concrete pump island on South side of building.							
Elev.: 94	9.65 N	lorth 46.21	West	322.50	(from SE Cor. Sec. 27-10-24E)		
		0.40.50	NT (1	74.00			
MW-1	rim	949.52	North	74.00	SE1/4,SE1/4,SE1/4		
	top pipe	948.73	West	315.03	Lat $= 39.14329$ Long $= 94.71623$		
MAN O		949.02	North	52.32	SE1/4,SE1/4,SE1/4,SE1/4		
MW-2	rim	-					
	top pipe	948.59	West	316.12	Lat $= 39.14323$ Long $= 94.71623$		
NAME 2	mina	950.03	North	47.41	SW1/4,SE1/4,SE1/4,SE1/4		
MW-3	rim						
	top pipe	949.63	West	351.87	Lat $= 39.14322$ Long $= 94.71636$		
NAXY A		954.35	North	80.55	SW1/4,SE1/4,SE1/4,SE1/4		
MW-4	rim						
	top pipe	953.93	West	382.71	Lat $= 39.14331$ Long $= 94.71647$		
NAME		049.07	North	54.75	SE1/4,SE1/4,SE1/4,SE1/4		
MW-5	rim .	948.07					
	top pipe	947.71	West	239.71	Lat $= 39.14324$ Long $= 94.71596$		
NAME		042 47	North	77.74	SE1/4,SE1/4,SE1/4,SE1/4		
MW-6	rim	942.47					
	top pipe	942.07	West	115.51	Lat $= 39.14329$ Long $= 94.71552$		
NAME 7		944.33	South	46.25	NE1/4,NE1/4,NE1/4,NE1/4 (Sec. 34-10-24E)		
MW-7	rim						
	top pipe	943.65	West	236.77	Lat $= 39.14296$ Long $= 94.71596$		
NAME O		028 87	South	116.23	NE1/4,NE1/4,NE1/4,NE1/4 (Sec. 34-10-24E)		
MW-8	rim	938.87					
	top pipe	938.53	West	139.73	Lat = 39.14276 $Long = 94.71562$		

Lat & Long derived from Parkville 7.5' quad map. WGS84.

Elevation derived from WY 14 control point. NAVD 83.

If you have any fractions, please feel free to call me. Thank you for the opportunity to be of vervice to you. The Dennis L Handke RLS With 17, 200 Hole Manna ANSAST

April 17, 2024