### KOLAR Document ID: 1774388

## WATER WELL RECORD (WWC-5)

KOLAR DOC ID

Source:

Correction

Original Record

WELL ID\_\_\_\_\_ Change in Well Use

#### LOCATION OF WATER WELL

Latitude	Longitude	Section	Т	Township	F	Range	E W	Fraction	1⁄4	1⁄4	1⁄4
Datum	Elevation	County									

#### WATER WELL OWNER

Name				
Business				
Address				
Well location				
at owner's address				
CONCERNICE				

#### CONSTRUCTION

Borehole interval:	Borehole diameter:
fromtoft.	in.
fromtoft.	in.
Casing height above land su	
If casing height is less the has a variance been appr *variance not required fo	roved?* Yes No
or environmental remed	U U
Casing type:	
Blank casing interval:	ft. toft.
Blank casing diameter:	in.
Casing joints:	
Weight:lbs	s/ft.
Wall thickness or gauge	no.:
Blank casing interval:	ft. toft.
Blank casing diameter:	in.
Casing joints:	
Weight:lbs	s/ft.
Wall thickness or gauge	no.:
Grout interval: ft. to	ft.
Grout material:	
Grout interval: ft. to	oft.
Grout material:	
Screen / perforation material	:
Screen / perforation opening	gs:
Screen / perforation intervals	S:
Fromft. to	_ft.
Slot size unit _	
Fromft. to	_ft.
Slot size unit _	
Gravel pack intervals:	
Gravel pack not used:	Gravel size in
From ft. to	ft.
Gravel pack not used:	
From ft. to	

	County						
WELL WATER USE							
COMPLETION							
Dep	th of comp	leted w	rell:		ft.		
			encounter				
(1)_	ft.;	(2)	ft.;				
(3) _	ft.;	(4)	dry well				
Static water level in well: ft.							
measured below land surface on (mm/dd/yy):							
measured above land surface on (mm/dd/yy):							
Estir	nated yield	l:	gpm				
Wate	er level was	6:	ft. after		hours		
			pumping		gpm		
Pum	ıp installed	? Ye	es No				
Wate	er well disi	nfected	? Yes	No			

Distance from well:	Direction from well:				
Source description:					
Source:					
Distance from well:	Direction from well:				
Source description:					
No potential source within 100 feet.	e of contamination				
PERMIT & ID NUMBERS (AS REQUIRED)					
DWR Application No.:					
KDHE / EPA Project C	ode:				
Site Name:					
KDHE UIC Class V Fo	rm Completed: Yes No				
County Permit: Yes	No Permit ID:				
Lease Name & Well #:					

# of boreholes: \_\_\_\_\_ # of dewatering wells: \_

NEAREST SOURCE OF POTENTIAL CONTAMINATION

# Aquifer, if known:

Date disinfected (mm/dd/yy):


FROM	то	LITHOLOGY INTERVALS				
		•				

#### COMMENTS

#### CONTRACTOR'S OR LANDOWNERS CERTIFICATION

This water well was constructed	reconstructed	pursuant to the stated water well
contractor's license and was complet	I certify that this record is true to	
the best of my knowledge and belief.	This water well rec	ord was completed on
under the business name of		,
Kansas Water Well Contractor's Lice	nse No	_ under the authority of the designated
person as defined in K.A.R. 28-30-20	(j) and signed and c	ertified by the electronic signature of the
designated person at its submittal:		
Send one copy to WATER WELL OWNER	and retain one for you	r records. Fee of \$5.00 for each constructed well
KANSAS DEPAR	TMENT OF HEALTH	AND ENVIRONMENT

Bureau of Water, Geology Section, 1000 SW Jackson St., Suite 420, Topeka KS 66612-1367 (785) 296-3565 | K.S.A. 82a-1212 | v2022c

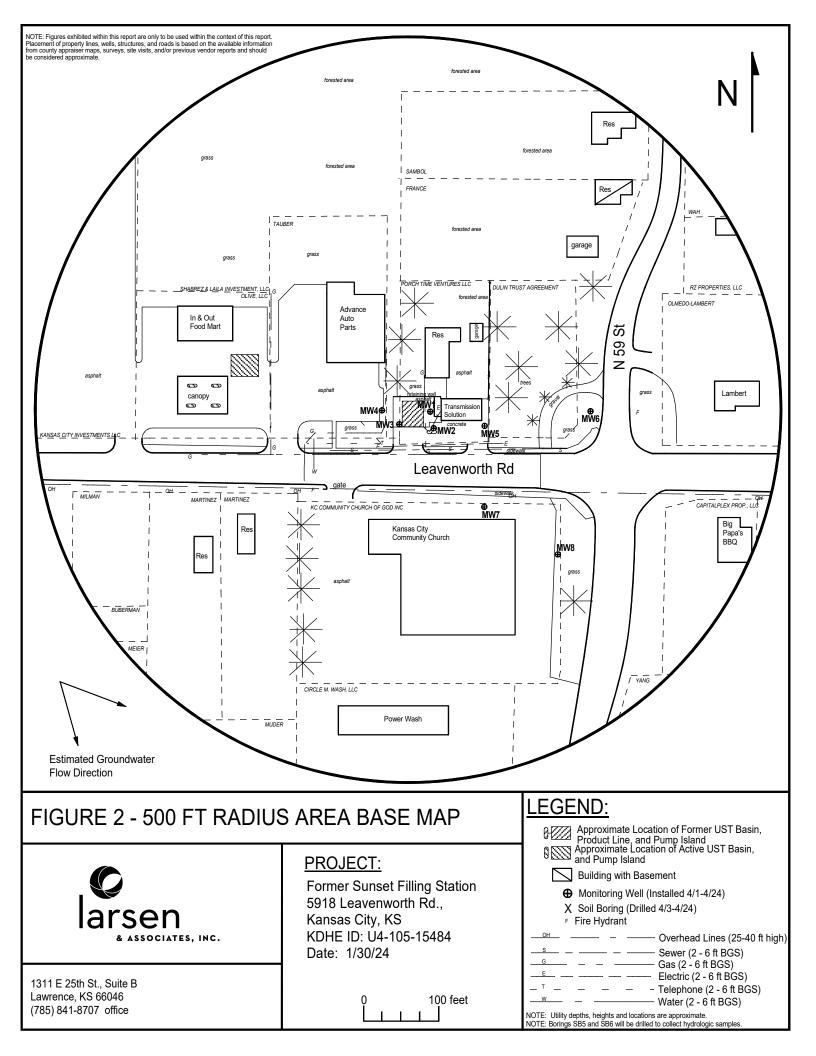

## DENNIS L HANDKE 1820 NW 59th Terrace TOPEKA, KANSAS 66618 785-286-4047 Home

Jess Chapman Larsen & Assoc. 1311 E. 25<sup>th</sup> St., Suite B Topeka, Kansas 66046

RE: Monitor Well Elevation Survey 5918 Leavenworth Road, Kansas City, Kansas Proj. 24-00Q Former Sunset Filling Station KDHE ID U4-105-15484

Bench Mark: Chisled Sq. on West center of concrete pump island on South side of building.						
Elev.: 94	9.65 N	lorth 46.21	West	322.50	(from SE Cor. Sec. 27-10-24E)	
		0.40.50	NT (1	74.00		
<b>MW-1</b>	rim	949.52	North	74.00	SE1/4,SE1/4,SE1/4	
	top pipe	948.73	West	315.03	Lat $= 39.14329$ Long $= 94.71623$	
MAN 2	rim	949.02	North	52.32	SE1/4,SE1/4,SE1/4,SE1/4	
MW-2		-				
	top pipe	948.59	West	316.12	Lat $= 39.14323$ Long $= 94.71623$	
NAME 2		950.03	North	47.41	SW1/4,SE1/4,SE1/4,SE1/4	
MW-3	rim					
	top pipe	949.63	West	351.87	Lat $= 39.14322$ Long $= 94.71636$	
NAXY A		954.35	North	80.55	SW1/4,SE1/4,SE1/4,SE1/4	
MW-4	rim					
	top pipe	953.93	West	382.71	Lat $= 39.14331$ Long $= 94.71647$	
NAME C		049.07	North	54.75	SE1/4,SE1/4,SE1/4,SE1/4	
MW-5	rim .	948.07				
	top pipe	947.71	West	239.71	Lat $= 39.14324$ Long $= 94.71596$	
NAME		042 47	North	77.74	SE1/4,SE1/4,SE1/4,SE1/4	
MW-6	rim	942.47				
	top pipe	942.07	West	115.51	Lat $= 39.14329$ Long $= 94.71552$	
N (111 7		044.22	South	46.25	NE1/4,NE1/4,NE1/4,NE1/4 (Sec. 34-10-24E)	
MW-7	rim	944.33				
	top pipe	943.65	West	236.77	Lat $= 39.14296$ Long $= 94.71596$	
NAME O		028 97	South	116.23	NE1/4,NE1/4,NE1/4,NE1/4 (Sec. 34-10-24E)	
MW-8	rim .	938.87				
	top pipe	938.53	West	139.73	Lat = 39.14276 $Long = 94.71562$	

Lat & Long derived from Parkville 7.5' quad map. WGS84.

Elevation derived from WY 14 control point. NAVD 83.

If you have any fractions, please feel free to call me. Thank you for the opportunity to be of vervice to you. The Dennis L Handke RLS With 17, 200 Hole Manna ANSAST

April 17, 2024