KOLAR Document ID: 1777460

WATER WELL RECORD (WWC-5)

KOLAR DOC ID

Correction

Original Record

WELL ID_____ Change in Well Use

LOCATION OF WATER WELL

Latitude	Longitude	Section	Т	Township	F	Range	E W	Fraction	1⁄4	1⁄4	1⁄4
Datum	Elevation	County									

WATER WELL OWNER

Name				
Business				
Address				
Well location				
at owner's address				
CONCERNICE				

CONSTRUCTION

Borehole interval:	Borehole diameter:
fromtoft.	in.
fromtoft.	in.
Casing height above land su	
If casing height is less th has a variance been app	roved?* Yes No
*variance not required for or environmental reme	
Casing type:	
Blank casing interval:	ft. toft.
Blank casing diameter:	in.
Casing joints:	
Weight:lb	s/ft.
Wall thickness or gauge	
Blank casing interval:	ft. toft.
Blank casing diameter:	in.
Casing joints:	
Weight:lb	
Wall thickness or gauge	
Grout interval: ft. to	oft.
Grout material:	
Grout interval: ft. to	oft.
Grout material:	
Screen / perforation material	l:
Screen / perforation opening	gs:
Screen / perforation interval	s:
Fromft. to	_ft.
Slot size unit	
Fromft. to	_ft.
Slot size unit	
Gravel pack intervals:	
Gravel pack not used:	Gravel size in
From ft. to	ft.
Gravel pack not used:	
From ft. to	

	County						
WELL WATER USE							
сом	PLETION						
Dept	th of comp	leted wel	l:		ft.		
Dept	th(s) grou	ndwater e	encounter	red:			
(1)_	ft.;	(2)	ft.;				
(3) _	ft.;	(4)	dry well				
Static water level in well: ft.							
measured below land surface on (mm/dd/yy):							
measured above land surface on (mm/dd/yy):							
Estir	Estimated yield: gpm						
Wate	er level wa	s:	_ ft. after		hours		
			pumping		gpm		
Pum	p installed	l? Yes	No				
Wate	Water well disinfected? Yes No						
Date disinfected (mm/dd/yy):							

NEAREST SOURCE OF PC	DTENTIAL CONTAMINATION
Source:	
Distance from well:	Direction from well:
Source description:	
Source:	
Distance from well:	Direction from well:
Source description:	
No potential source within 100 feet.	of contamination
PERMIT & ID NUMBERS	(AS REQUIRED)
DWR Application No.:_	
	ode:
Site Name:	
	m Completed: Yes No
County Permit: Yes	No Permit ID:
Lease Name & Well #:	

of boreholes: _____ # of dewatering wells: _

Aquifer, if known:

LITHOLOGIC LOG


FROM	то	LITHOLOGY INTERVALS
		·

COMMENTS

CONTRACTOR'S OR LANDOWNERS CERTIFICATION

This water well was constructed re	econstructed	pursuant to the stated water well
contractor's license and was completed o	n	I certify that this record is true to
the best of my knowledge and belief. This	s water well recor	rd was completed on
under the business name of		,
Kansas Water Well Contractor's License	No	under the authority of the designated
person as defined in K.A.R. 28-30-2(j) ar	nd signed and cer	tified by the electronic signature of the
designated person at its submittal:		
Send one copy to WATER WELL OWNER and	retain one for your	records. Fee of \$5.00 for each constructed well.
KANSAS DEPARTME	ENT OF HEALTH A	ND ENVIRONMENT

Bureau of Water, Geology Section, 1000 SW Jackson St., Suite 420, Topeka KS 66612-1367 (785) 296-3565 | K.S.A. 82a-1212 | v2022c

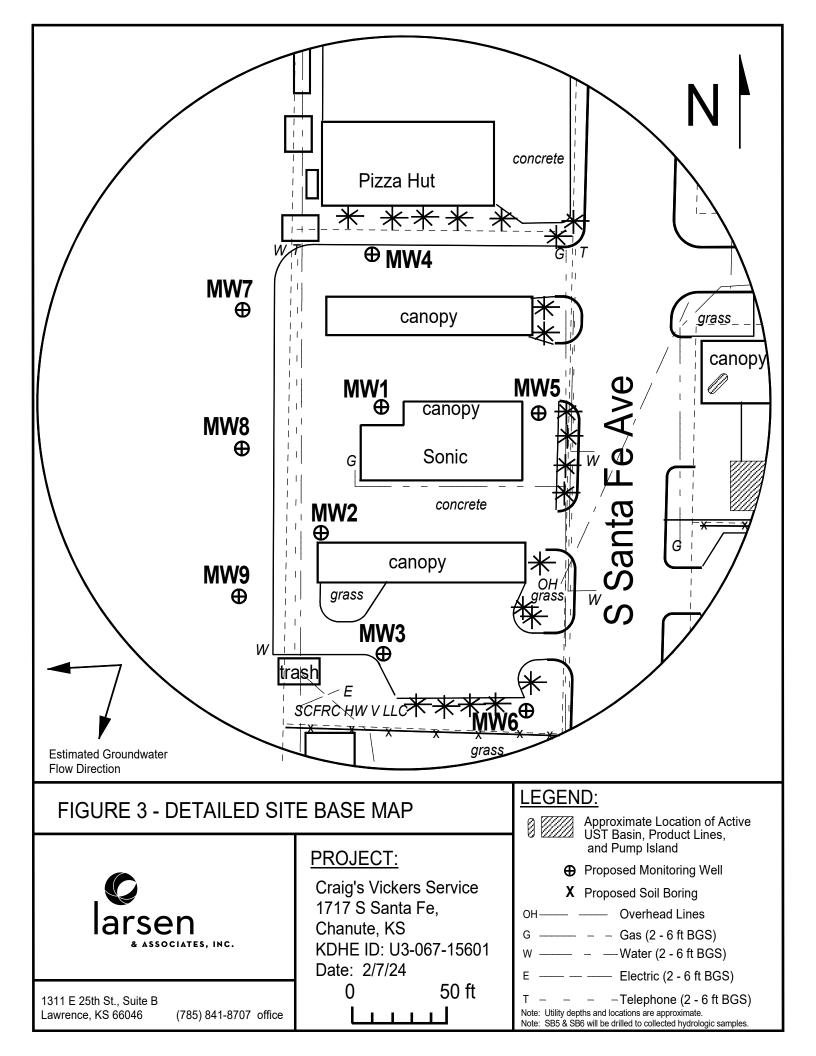

DENNIS L HANDKE 1820 NW 59th Terrace TOPEKA, KANSAS 66618 785-286-4047 Home

April 22, 2024

Jess Chapman Larson & Assoc. 1311 E. 25th St., Suite B Lawrence, Kansas, 66046

RE: Monitor Well Elevation Survey 1717 South Santa Fe, Chanute, Kansas Proj. 24-00R Craig's Vickers Service U3-067-15601

Bench Mark: Chisled X on top NE bolt of concrete light base East of the trash dumpster enclosure near the SW corner of property.

Elev: 960.19		North 1126	6.69	West 133.68	(from SE Cor. Sec. 29-27-18E)
MW-1	rim	958.46	North	1269.91	NE1/4,NE1/4,SE1/SE1/4
	top pipe	958.14	West	119.93	Lat= 37.66354 Long = 95.45298
MW-2	rim	958.76	North	1195.96	NE1/4,NE1/4,SE1/4,SE1/4
	top pipe	958.47	West	151.54	Lat= 37.66334 Long = 95.45310
MW-3	rim	957.82	North	1132.46	NE1/4,NE1/4,SE1/4,SE1/4
	top pipe	957.50	West	129.53	Lat= 37.66317 Long = 95.45303
MW-4	rim	959.21	North	1345.68	SE1/4,SE1/4,NE1/4,SE1/4
	top pipe	958.64	West	128.73	Lat= 37.66375 Long = 95.45301
MW-5	rim	958.37	North	1259.51	NE1/4,NE1/4,SE1/4,SE1/4
	top pipe	958.04	West	38.53	Lat= 37.66351 Long = 95.45270
MW-6	rim	957.71	North	1115.14	NE1/4,NE1/4,SE1/4,SE1/4
	top pipe	957.19	West	47.10	Lat= 37.66311 Long = 95.45274
MW-7	rim	956.00	North	1307.46	NE1/4,NE1/4,SE1/4,SE1/4
	top pipe	955.73	West	204.06	Lat= 37.66365 Long = 95.45327
MW-8	rim	954.76	North	1238.74	NE1/4,NE1/4,SE1/4,SE1/4
	top pipe	954.47	West	207.23	Lat= 37.66346 Long = 95.45329
MW-9	rim top pipe	954.10 953.61	North West		NE1/4,NE1/4,SE1/4,SE1/4 Lat= 37.66327 Long = 95.45328

Lat & Long derived from Chanute 7.5' quad map. WGS 84.

Elevation established from NGS BM H 246, NAVD 88.

If you have any questions, please feel free to call me. Thank you for the opportunity to be

