KOLAR Document ID: 1777457

WATER WELL RECORD (WWC-5)

KOLAR DOC ID

Source: Distance

from well:

Source description:

Source:

Distance

Source

from well:

description:

Site Name:

within 100 feet.

DWR Application No.:___

Lease Name & Well #:

Correction

Original Record

ft.

gpm

WELL ID Change in Well Use

NEAREST SOURCE OF POTENTIAL CONTAMINATION

No potential source of contamination

PERMIT & ID NUMBERS (AS REQUIRED)

KDHE / EPA Project Code: _____

County Permit: Yes No Permit ID:

of boreholes: _____ # of dewatering wells: _

KDHE UIC Class V Form Completed: Yes No

Direction

from well:

Direction

from well:

LOCATION OF WATER WELL

Latitude	Longitude	Section	Township	Range	E W	Fraction	1⁄4	1⁄4	1⁄4
Datum	Elevation	County							

WATER WELL OWNER

Name				
Business				
Address				
Well location				
at owner's address				
CONCERNICE				

CONSTRUCTION

Borehole interval:	Borehole diameter:			
fromtoft.	in.			
fromtoft.	in.			
Casing height above land su				
If casing height is less th has a variance been app *variance not required fo	roved?* Yes No			
or environmental reme	U U			
Casing type:				
Blank casing interval:	ft. toft.			
Blank casing diameter:	in.			
Casing joints:				
Weight:lbs	s/ft.			
Wall thickness or gauge	no.:			
Blank casing interval:	ft. toft.			
Blank casing diameter:	in.			
Casing joints:				
Weight:lbs	s/ft.			
Wall thickness or gauge	no.:			
Grout interval: ft. to	oft.			
Grout material:				
Grout interval: ft. to	oft.			
Grout material:				
Screen / perforation material	:			
Screen / perforation opening	gs:			
Screen / perforation intervals	8:			
Fromft. to	_ft.			
Slot size unit				
Fromft. to	_ft.			
Slot size unit				
Gravel pack intervals:				
Gravel pack not used:	Gravel size in			
From ft. to	ft.			
Gravel pack not used:				
From ft. to				

WELL WATER USE COMPLETION Depth of completed well: Depth(s) groundwater encountered: ft.; (2) ft.; (1)

ft.; (4) dry well (3) ft. Static water level in well: measured below land surface on (mm/dd/yy): measured above land surface on (mm/dd/yy): Ectim atad viald.

Estimated yield:	gpm	
Water level was:	ft. after	hours

pumping _

Pump installed? Yes No

Water well disinfected? Yes No

Date disinfected (mm/dd/yy):

Aquifer, if known:

LIT


ITHOLOG	GIC LOG	
FROM	то	LITHOLOGY INTERVALS

COMMENTS

CONTRACTOR'S OR LANDOWNERS CERTIFICATION

This water well was constructed	reconstructed	pursuant to the stated water well
contractor's license and was complete	I certify that this record is true to	
the best of my knowledge and belief.	This water well reco	ord was completed on
under the business name of		,
Kansas Water Well Contractor's Licer	1se No	_ under the authority of the designated
person as defined in K.A.R. 28-30-2(j	i) and signed and c	ertified by the electronic signature of the
designated person at its submittal:		
Send one copy to WATER WELL OWNER a	and retain one for you	r records. Fee of \$5.00 for each constructed well.
KANSAS DEPAR	FMENT OF HEALTH	AND ENVIRONMENT

Bureau of Water, Geology Section, 1000 SW Jackson St., Suite 420, Topeka KS 66612-1367 (785) 296-3565 | K.S.A. 82a-1212 | v2022c

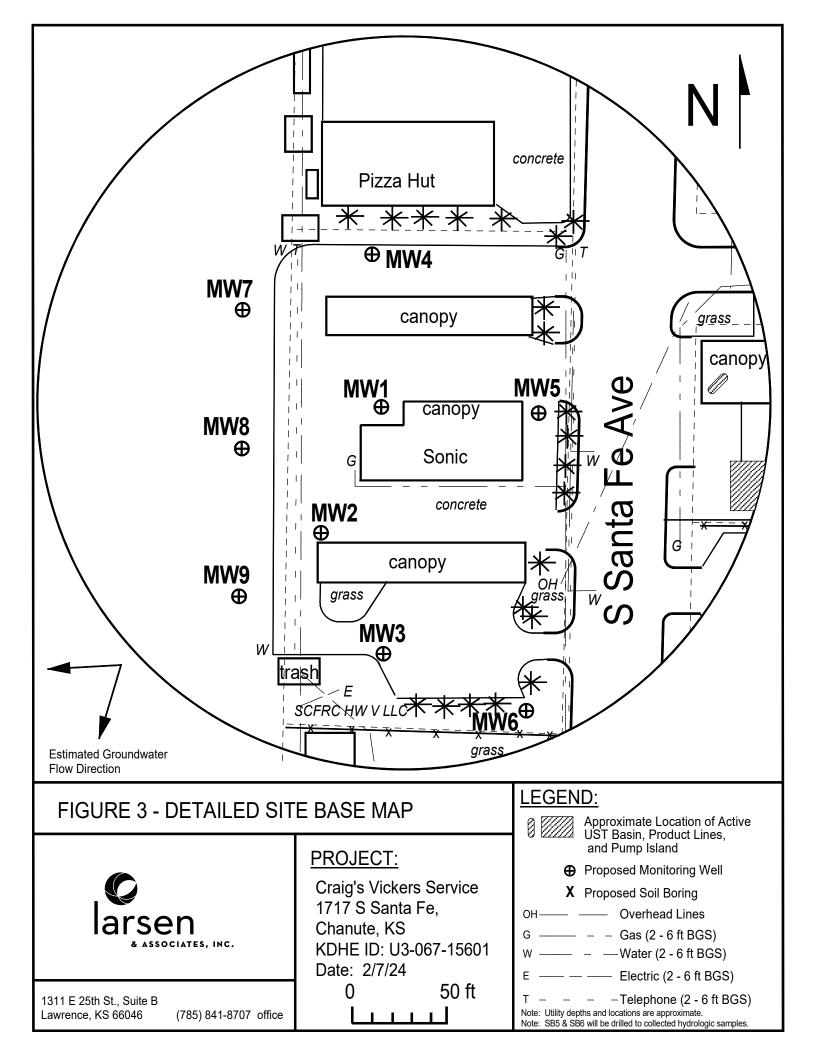

DENNIS L HANDKE 1820 NW 59th Terrace TOPEKA, KANSAS 66618 785-286-4047 Home

April 22, 2024

Jess Chapman Larson & Assoc. 1311 E. 25th St., Suite B Lawrence, Kansas, 66046

RE: Monitor Well Elevation Survey 1717 South Santa Fe, Chanute, Kansas Proj. 24-00R Craig's Vickers Service U3-067-15601

Bench Mark: Chisled X on top NE bolt of concrete light base East of the trash dumpster enclosure near the SW corner of property.

Elev: 960.19		North 1126.69		West 133.68	(from SE Cor. Sec. 29-27-18E)	
MW-1	rim	958.46	North	1269.91	NE1/4,NE1/4,SE1/SE1/4	
	top pipe	958.14	West	119.93	Lat= 37.66354 Long = 95.45298	
MW-2	rim	958.76	North	1195.96	NE1/4,NE1/4,SE1/4,SE1/4	
	top pipe	958.47	West	151.54	Lat= 37.66334 Long = 95.45310	
MW-3	rim	957.82	North	1132.46	NE1/4,NE1/4,SE1/4,SE1/4	
	top pipe	957.50	West	129.53	Lat= 37.66317 Long = 95.45303	
MW-4	rim	959.21	North	1345.68	SE1/4,SE1/4,NE1/4,SE1/4	
	top pipe	958.64	West	128.73	Lat= 37.66375 Long = 95.45301	
MW-5	rim	958.37	North	1259.51	NE1/4,NE1/4,SE1/4,SE1/4	
	top pipe	958.04	West	38.53	Lat= 37.66351 Long = 95.45270	
MW-6	rim	957.71	North	1115.14	NE1/4,NE1/4,SE1/4,SE1/4	
	top pipe	957.19	West	47.10	Lat= 37.66311 Long = 95.45274	
MW-7	rim	956.00	North	1307.46	NE1/4,NE1/4,SE1/4,SE1/4	
	top pipe	955.73	West	204.06	Lat= 37.66365 Long = 95.45327	
MW-8	rim	954.76	North	1238.74	NE1/4,NE1/4,SE1/4,SE1/4	
	top pipe	954.47	West	207.23	Lat= 37.66346 Long = 95.45329	
MW-9	rim top pipe	954.10 953.61	North West		NE1/4,NE1/4,SE1/4,SE1/4 Lat= 37.66327 Long = 95.45328	

Lat & Long derived from Chanute 7.5' quad map. WGS 84.

Elevation established from NGS BM H 246, NAVD 88.

If you have any questions, please feel free to call me. Thank you for the opportunity to be

