# KOLAR Document ID: 1786664

# WATER WELL RECORD (WWC-5)

KOLAR DOC ID

Source: Distance

from well:

from well:

Site Name:

within 100 feet.

DWR Application No.:\_

Lease Name & Well #:

KDHE / EPA Project Code:

Source description:

Source description: Source: Distance

Correction

Original Record

ft.

WELL ID Change in Well Use

NEAREST SOURCE OF POTENTIAL CONTAMINATION

No potential source of contamination

KDHE UIC Class V Form Completed: Yes No

County Permit: Yes No Permit ID:

# of boreholes: \_\_\_\_\_ # of dewatering wells: \_

PERMIT & ID NUMBERS (AS REQUIRED)

Direction

from well:

Direction

from well:

### LOCATION OF WATER WELL

Latitude	Longitude	Section	Township	Range	E W	Fraction	1⁄4	1⁄4	1⁄4
Datum	Elevation	County							

### WATER WELL OWNER

Name				
Business				
Address				
Well location				
at owner's address				
CONCEPTION				

#### CONSTRUCTION

Borehole interval:	Borehole diameter:				
fromtoft.	in.				
fromtoft.	in.				
Casing height above land su					
If casing height is less the has a variance been appr *variance not required fo or environmental remed	coved?* Yes No or monitoring				
Casing type:					
Blank casing interval:	ft. toft.				
Blank casing diameter:	in.				
Casing joints:					
Weight:lbs	s/ft.				
Wall thickness or gauge	no.:				
Blank casing interval:	ft. toft.				
Blank casing diameter: in.					
Casing joints:					
Weight:lbs/ft.					
Wall thickness or gauge	no.:				
Grout interval: ft. to	pft.				
Grout material:					
Grout interval: ft. to	oft.				
Grout material:					
Screen / perforation material	:				
Screen / perforation opening	gs:				
Screen / perforation intervals	S:				
Fromft. to	_ft.				
Slot size unit _					
Fromft. to	_ft.				
Slot size unit _					
Gravel pack intervals:					
Gravel pack not used:	Gravel size in				
From ft. to	ft.				
Gravel pack not used:	Gravel size in				
From ft. to	ft.				

	County						
WELL WATER USE							
COMPLETION							
Dep	th of comp	leted v	vell:				
Dep	Depth(s) groundwater encountered:						
(1)_	ft.;	(2) _	ft.;				
(3)_	ft.;	(4)	dry well				
Stati	c water lev	rel in w	ell:	ft.			
measured below land surface							
measured above land surface on (mm/dd/yy):							
Estir	nated yield	l:	gpm				

	01	
Water level was:	ft. after	hours
	pumping	gpm

Pump installed? Yes No

Water well disinfected? Yes No

Date disinfected (mm/dd/yy):

# Aquifer, if known:

## LIT


ITHOLOG	GIC LOG	
FROM	то	LITHOLOGY INTERVALS

#### COMMENTS

### CONTRACTOR'S OR LANDOWNERS CERTIFICATION

This water well was constructed	reconstructed	pursuant to the stated water well
contractor's license and was complete	I certify that this record is true to	
the best of my knowledge and belief.	This water well rec	ord was completed on
under the business name of		,
Kansas Water Well Contractor's Lice	nse No	_ under the authority of the designated
person as defined in K.A.R. 28-30-2(	j) and signed and c	ertified by the electronic signature of the
designated person at its submittal:		
Send one copy to WATER WELL OWNER	and retain one for you	r records. Fee of \$5.00 for each constructed well.
KANSAS DEPAR	TMENT OF HEALTH	AND ENVIRONMENT

Bureau of Water, Geology Section, 1000 SW Jackson St., Suite 420, Topeka KS 66612-1367 (785) 296-3565 | K.S.A. 82a-1212 | v2022c

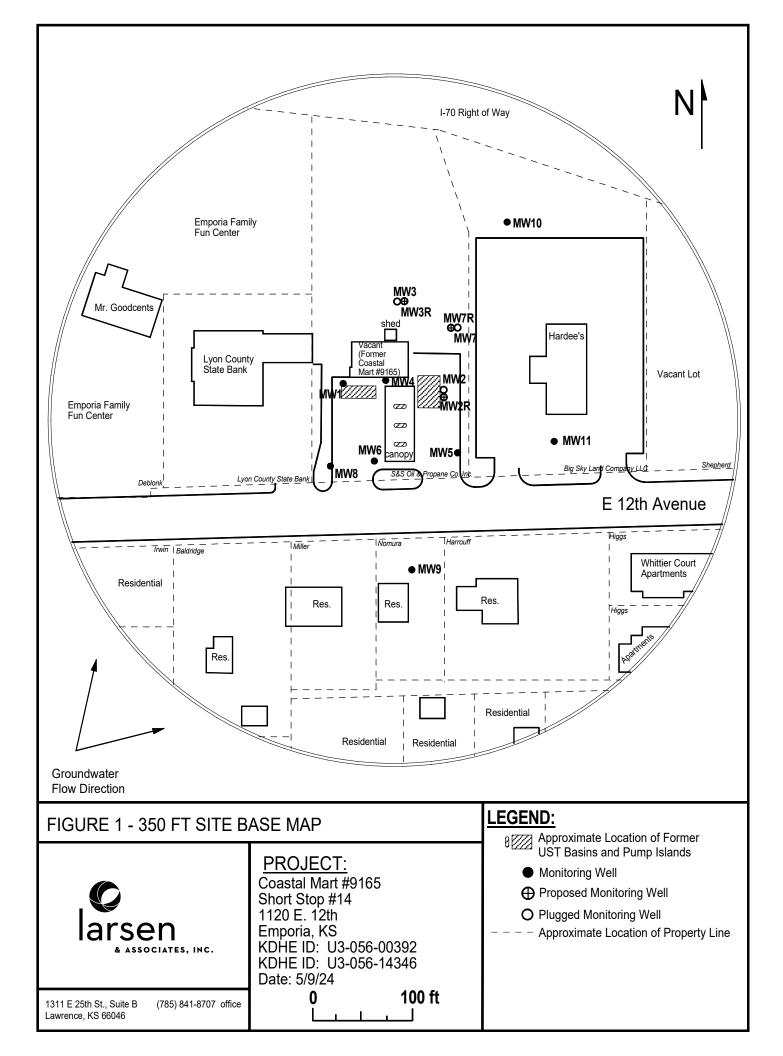

# **DENNIS L HANDKE**

1820 NW 59th Terrace TOPEKA, KANSAS 66618 785-286-4047 Home 785-217-5864 Cell

July 10, 2024

Jess Chapman Larsen & Assoc. 1311 E. 25th Street Lawrene, Kansas, 66046

MW-2R

MW-3R

Proj. 24-00Y **RE: Monitor Well Elevation Survey** Coastal Mart #9165 1120 E. 6th Street, Emporia, Kansas Short Stop #14 U3-056-00392 U3-056-14346 Bnch Mark: Square cut on East center of Center concrete pump island South of the building. (from SE Cor. Sec. 11-19-11E) Elev: 1134.57 North 2692.39 West 3683.55 SW1/4,SW1/4,SE1/4,NW1/4 North 2726.89 1133.16 rim Lat= 38.41258 Long = 96.16521 3640.84 West 1132.65 top pipe SW1/4,SW1/4,SE1/4,NW1/4 2819.55 1134.26 North rim Lat= 38.41284 Long = 96.16540 top pipe 1133.60 3695.20 West

SW1/4,SW1/4,SE1/4,NW1/4 2789.17 1134.47 North MW-7R rim Lat= 38.41275 Long = 96.16522 top pipe 1134.09 West 3642.72

Elevation derived from U3-056-00537. NAVD 88

Lat & Long derived from Emporia 7.5 Quad Map. WGS 84

If you have any, questions, please feel free to call me. Thank you for the opportunity to be of service to SURV SURV