KOLAR Document ID: 1791190

WATER WELL RECORD (WWC-5)

KOLAR DOC ID

Correction

Original Record

WELL ID_____ Change in Well Use

LOCATION OF WATER WELL

Latitude	Longitude	Section	Township	Range	E W	Fraction	1⁄4	1⁄4	1⁄4
Datum	Elevation	County							

WATER WELL OWNER

Name				
Business				
Address				
Well location				
at owner's address				

CONSTRUCTION

Borehole interval:	Borehole diameter:			
fromtoft.	in.			
fromtoft.	in.			
Casing height above land su				
If casing height is less th has a variance been app *variance not required fo	roved?* Yes No			
or environmental reme	U U			
Casing type:				
Blank casing interval:	ft. toft.			
Blank casing diameter:	in.			
Casing joints:				
Weight:lbs	s/ft.			
Wall thickness or gauge	no.:			
Blank casing interval:	ft. toft.			
Blank casing diameter:	in.			
Casing joints:				
Weight:lbs	s/ft.			
Wall thickness or gauge	no.:			
Grout interval: ft. to	oft.			
Grout material:				
Grout interval: ft. to	oft.			
Grout material:				
Screen / perforation material	:			
Screen / perforation opening	gs:			
Screen / perforation intervals	8:			
Fromft. to	_ft.			
Slot size unit				
Fromft. to	_ft.			
Slot size unit				
Gravel pack intervals:				
Gravel pack not used:	Gravel size in			
From ft. to	ft.			
Gravel pack not used:				
From ft. to				

	County				
WELL	WATER U				
сом	PLETION				
Dept	th of compl	eted we	11:		ft.
	th(s) groun				
(1)_	ft.;	(2)	ft.;		
(3) _	ft.;	(4)	dry well		
Stati	c water leve	el in wel	l:	ft.	
	neasured be n (mm/dd/		d surface		
	neasured at n (mm/dd/		d surface		
Estir	nated yield	:	gpm		
Wate	er level was	:	ft. after		hours
			pumping		gpm
Pum	p installed	Yes	s No		
Wate	er well disir	fected?	Yes	No	

NEAREST SOURCE O	OF POTENTIAL CONTAMINATION
Source:	
Distance from well:	Direction from well:
Source description:	
Source:	
Distance from well:	Direction from well:
Source description:	
No potential so within 100 feet	urce of contamination
PERMIT & ID NUM	BERS (AS REQUIRED)
DWR Application	No.:
KDHE / EPA Proje	ct Code:
Site Name:	
KDHE UIC Class V	/ Form Completed: Yes No

County Permit: Yes No Permit ID:

of boreholes: _____ # of dewatering wells: _

Lease Name & Well #:

Aquifer, if known:

Date disinfected (mm/dd/yy):

LITHOLOGIC LOG


FROM	то	LITHOLOGY INTERVALS

COMMENTS

CONTRACTOR'S OR LANDOWNERS CERTIFICATION

This water well was constructed	reconstructed	pursuant to the stated water well
contractor's license and was complete	ed on	. I certify that this record is true to
the best of my knowledge and belief.	This water well rec	ord was completed on
under the business name of		
Kansas Water Well Contractor's Lice	nse No	under the authority of the designated
person as defined in K.A.R. 28-30-20	j) and signed and c	ertified by the electronic signature of the
designated person at its submittal:		·
Send one copy to WATER WELL OWNER	and retain one for you	r records. Fee of \$5.00 for each constructed well
KANSAS DEPAR	TMENT OF HEALTH	AND ENVIRONMENT

Bureau of Water, Geology Section, 1000 SW Jackson St., Suite 420, Topeka KS 66612-1367 (785) 296-3565 | K.S.A. 82a-1212 | v2022c

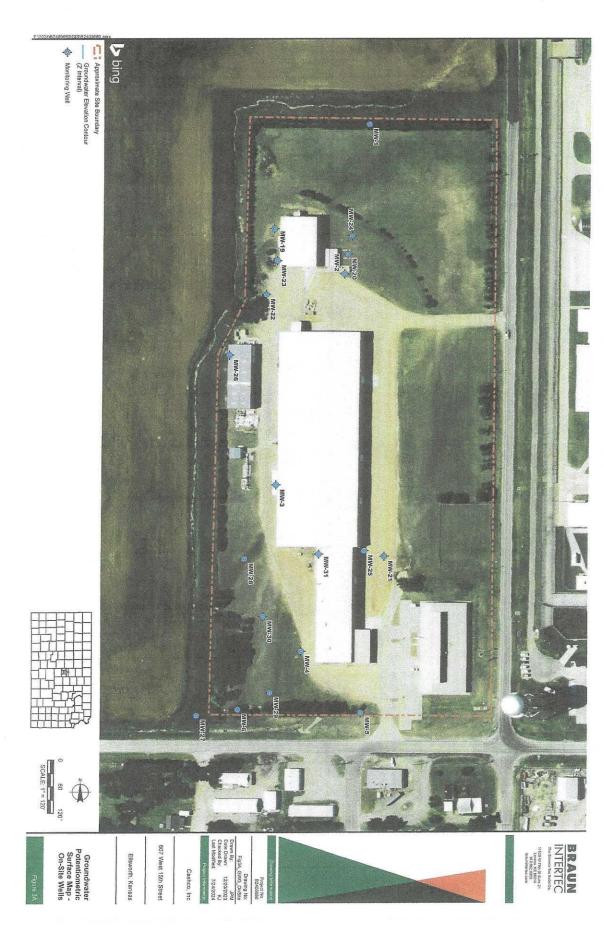

8/13/2024, 11:10 AN