Change in Well Use

WELL ID

Correction

KOLAR DOC ID

(785) 296-3565 | K.S.A. 82a-1212 | v2022c

Original Record

WATER WELL RECORD (WWC-5)

LOCATION	OF V	VATER WEL	L													
Latitude			Longitude			Section		Township		Range	E W	Fraction	1/4	1/4	1/4	
Datum			Elevation			County										
WATER WE	ELL O	WNER			WELL	. WATER U	SE				NEAREST S	OURCE OF I	POTENTIAL	CONTAMII	NATION	
Name											Source:					
Business					COM	PLETION					Distance		Directi			
Address					Depth of completed well:ft. Depth(s) groundwater encountered:					ft.	from well: Source description:					
Well location				(1)ft.; (2)ft.; (3)ft.; (4) dry well Static water level in well: ft.						Source: Distance Direction from well: from well:						
at owner's address					measured below land surface on (mm/dd/yy):						Source description:					
CONSTRU	ı		measured above land surface						No potential source of contamination within 100 feet.							
Borehole interval: Borehole diameter:					on (mm/dd/yy):											
fromtoftininin.					Estimated yield: gpm Water level was: ft. afterhours					urs	DWR Application No.:					
Casing he	ight a	ove land su	rface:	in.				pumping	gp	m	KDHE / EPA Project Code:					
If casing height is less than 12 in. has a variance been approved?* Yes No					Pump installed? Yes No						Site Name: KDHE UIC Class V Form Completed: Yes No					
		or monitoring		Water well disinfected? Yes No						County Permit: Yes No Permit ID:						
	nentai remed	diation wells		Date disinfected (mm/dd/yy):						Lease Name & Well #:						
Casing type: ft. to ft.					Aquifer, if known:						# of boreh	oles:	# of dewat	ering wells:		
		meter:			LITHO	DLOGIC LO	OG .									
Casing joints:					FRC			ITHOLOGY II	NTERVA	LS						
Weight: lbs/ft.																
			no.:													
			ft. to													
Blank casing diameter:in.																
Casing joints:																
Weight: lbs/ft.																
Wall thickness or gauge no.:																
		ft. to														
		rial:														
Grout interval:ft. toft. Grout material:					COMMENTS											
_			:		CONT	DACTOR	CODI	ANDOWNER	CERTIF	ICATION						
Screen / perforation intervals:					CONTRACTOR'S OR LANDOWNERS CERTIFICATION											
Screen / perforation intervals:					This water well was constructed reconstructed pursuant to the stated water well											
Fromft. toft.						contractor's license and was completed on I certify that this record is true to										
Slot size unit						the best of my knowledge and belief. This water well record was completed on										
Fromft. toft.						under the business name of										
Slot size unit						Kansas Water Well Contractor's License No under the authority of the designated										
Gravel pack intervals: Gravel pack not used: Gravel size in						person as defined in K.A.R. 28-30-2(j) and signed and certified by the electronic signature of the										
			designated person at its submittal:													
		_ ft. to			Send one copy to WATER WELL OWNER and retain one for your records. Fee of \$5.00 for each constructed well.											
			Gravel size _	in	KANSAS DEPARTMENT OF HEALTH AND ENVIRONMENT											
From		_ ft. to	ft.		Bureau of Water, Geology Section, 1000 SW Jackson St., Suite 420, Topeka KS 66612-1367											

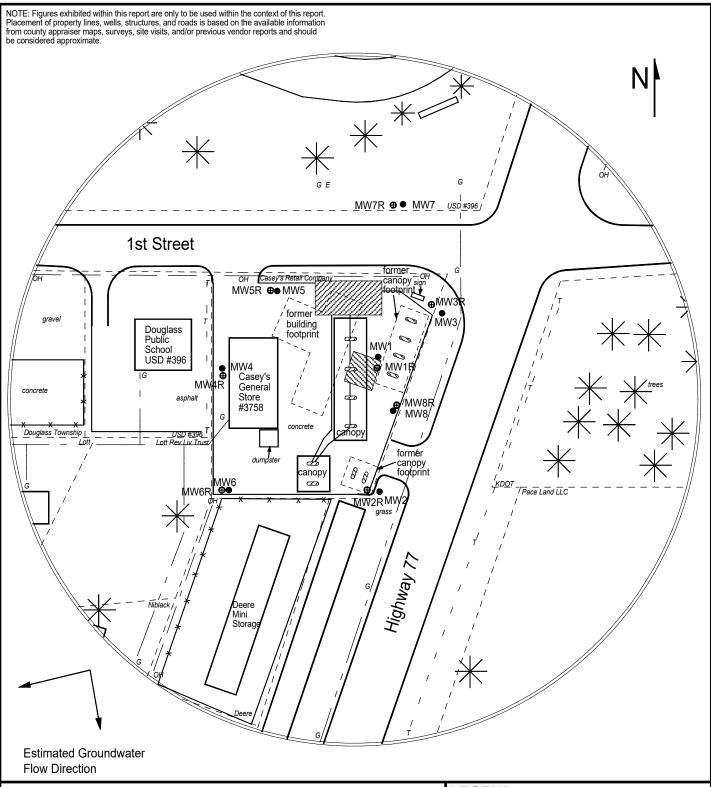


FIGURE 2.1 - 350 FT RADIUS AREA BASE MAP



1311 E 25th St. Suite B, Lawrence, KS 66046 785-841-8707 office

PROJECT:

Casey's General Store #3758 103 S Hwy. 77 Douglass, KS KDHE ID: U2-008-15145

Date: 6/17/24

0 100 ft

LEGEND:

Approximate Location of Active UST Basin, Product Lines & Pump Islands

Approximate Location of Former UST Basin & Pump Islands

- - Approximate Location of Property Line
- Existing Monitoring Well
 Proposed Monitoring Well
- Proposed Monitoring Well

 Floating Material
- Electric Meter
 ■

[⊥] – – - Telephone Lines (2 - 6 ft bgs)

NOTE: Utility depths, heights and locations are approximate.

DENNIS L HANDKE

1820 NW 59th Terrace TOPEKA, KANSAS 66618 785-286-4047 Home

Jess Chapman Larsen & Associates 1311 E. 25th Street, Suite B Lawrence, Kansas, 66046 July 13, 2024

RE: Monitor Well Elevation Survey 103 S. Hwy 77, Douglas, Kansas

Proj. 24-00Z Casey's General Store #3758 U2-008-15145

Bench Mark: Chisled X on top of SW bolt of West leg of concrete sign base at the NE Corner of property. (from SE Cor. Sec. 21-29-4E) Elev: 1213.88 North 5307.41 West 4016.69 North 5239.38 NE1/4,NE1/4,NW1/4,NW1/4 MW-1R rim 1213.07 Lat= 37.51924 Long = 97.004231212.76 West 4060.24 top pipe NE1/4,NE1/4,NW1/4,NW1/4 MW-2R 1213.11 North 5114.60 rim Lat= 37.51889 Long = 97.004301212.87 West 4082.21 top pipe NE1/4,NE1/4,NW1/4,NW1/4 5301.79 MW-3R rim 1212.94 North 4006.19 Lat= 37.51941 Long = 97.004041212.61 West top pipe NE1/4,NE1/4,NW1/4,NW1/4 North 5237.47 MW-4R rim 1213.10 Lat= 37.51923 Long = 97.004771212.83 West 4217.99 top pipe NE1/4,NE1/4,NW1/4,NW1/4 1212.94 North 5311.21 MW-5R rim 4165.18 Lat= 37.51943 Long = 97.00459 top pipe 1212.63 West NE1/4,NE1/4,NW1/4,NW1/4 5116.95 MW-6R rim 1211.01 North Lat= 37.51890 Long = 97.004761210.63 West 4218.11 top pipe SE1/4,SE1/4,SW1/4,SW1/4 (Sec. 16-29-4E) 5405.82 MW-7R rim 1211.56 North Lat= 37.51969 Long = 97.004171211.29 West 4040.92 top pipe NE1/4,NE1/4,NW1/4,NW1/4 5185.58 MW-8R rim 1212.46 North Lat= 37.51909 Long = 97.004181212.04 West 4046.53 top pipe

Lat & Long derived from Douglas 7.5 quad map. WGS84.

Elevation established from existing project. NAVD 88

If you have any questions, please feel free to call me. Thank you for the opportunity to be of service to you.

Bennis L Handke RLS

Jely LS 786

TANSAS

SURVEY

TO SU