

WATER WELL RECORD (WWC-5)

KOLAR DOC ID _____ WELL ID _____
 Original Record Correction Change in Well Use

LOCATION OF WATER WELL

Latitude		Longitude		Section		Township		Range		E W	Fraction	¼	¼	¼
Datum		Elevation		County										

WATER WELL OWNER

Name	
Business	
Address	
Well location at owner's address	

WELL WATER USE

COMPLETION

Depth of completed well: _____ ft.
 Depth(s) groundwater encountered:
 (1) _____ ft.; (2) _____ ft.;
 (3) _____ ft.; (4) dry well

Static water level in well: _____ ft.
 measured below land surface on (mm/dd/yy): _____
 measured above land surface on (mm/dd/yy): _____

Estimated yield: _____ gpm
 Water level was: _____ ft. after _____ hours
 pumping _____ gpm
 Pump installed? Yes No

Water well disinfected? Yes No
 Date disinfected (mm/dd/yy): _____

Aquifer, if known: _____

NEAREST SOURCE OF POTENTIAL CONTAMINATION

Source: _____
 Distance from well: _____ Direction from well: _____
 Source description: _____

Source: _____
 Distance from well: _____ Direction from well: _____
 Source description: _____

No potential source of contamination within 100 feet.

CONSTRUCTION

Borehole interval: from _____ to _____ ft.	Borehole diameter: _____ in.
from _____ to _____ ft.	_____ in.
Casing height above land surface: _____ in. If casing height is less than 12 in. has a variance been approved? * Yes No *variance not required for monitoring or environmental remediation wells	
Casing type: _____	
Blank casing interval: _____ ft. to _____ ft.	
Blank casing diameter: _____ in.	
Casing joints: _____	
Weight: _____ lbs/ft.	
Wall thickness or gauge no.: _____	
Blank casing interval: _____ ft. to _____ ft.	
Blank casing diameter: _____ in.	
Casing joints: _____	
Weight: _____ lbs/ft.	
Wall thickness or gauge no.: _____	
Grout interval: _____ ft. to _____ ft.	
Grout material: _____	
Grout interval: _____ ft. to _____ ft.	
Grout material: _____	
Screen / perforation material: _____	
Screen / perforation openings: _____	
Screen / perforation intervals: From _____ ft. to _____ ft. Slot size _____ unit _____	
From _____ ft. to _____ ft. Slot size _____ unit _____	
Gravel pack intervals: Gravel pack not used: Gravel size _____ in From _____ ft. to _____ ft.	
Gravel pack not used: Gravel size _____ in From _____ ft. to _____ ft.	

PERMIT & ID NUMBERS (AS REQUIRED)

DWR Application No.: _____
 KDHE / EPA Project Code: _____
 Site Name: _____
 KDHE UIC Class V Form Completed: Yes No
 County Permit: Yes No Permit ID: _____
 Lease Name & Well #: _____
 # of boreholes: _____ # of dewatering wells: _____

LITHOLOGIC LOG

FROM	TO	LITHOLOGY INTERVALS


COMMENTS

CONTRACTOR'S OR LANDOWNERS CERTIFICATION

This water well was constructed reconstructed pursuant to the stated water well contractor's license and was completed on _____. I certify that this record is true to the best of my knowledge and belief. This water well record was completed on _____ under the business name of _____, Kansas Water Well Contractor's License No. _____ under the authority of the designated person as defined in K.A.R. 28-30-2(j) and signed and certified by the electronic signature of the designated person at its submittal: _____.

Send one copy to WATER WELL OWNER and retain one for your records. Fee of \$5.00 for each constructed well.

NOTE: Figures exhibited within this report are only to be used within the context of this report. Placement of property lines, wells, structures, and roads is based on the available information from county appraiser maps, surveys, site visits, and/or previous vendor reports and should be considered approximate.

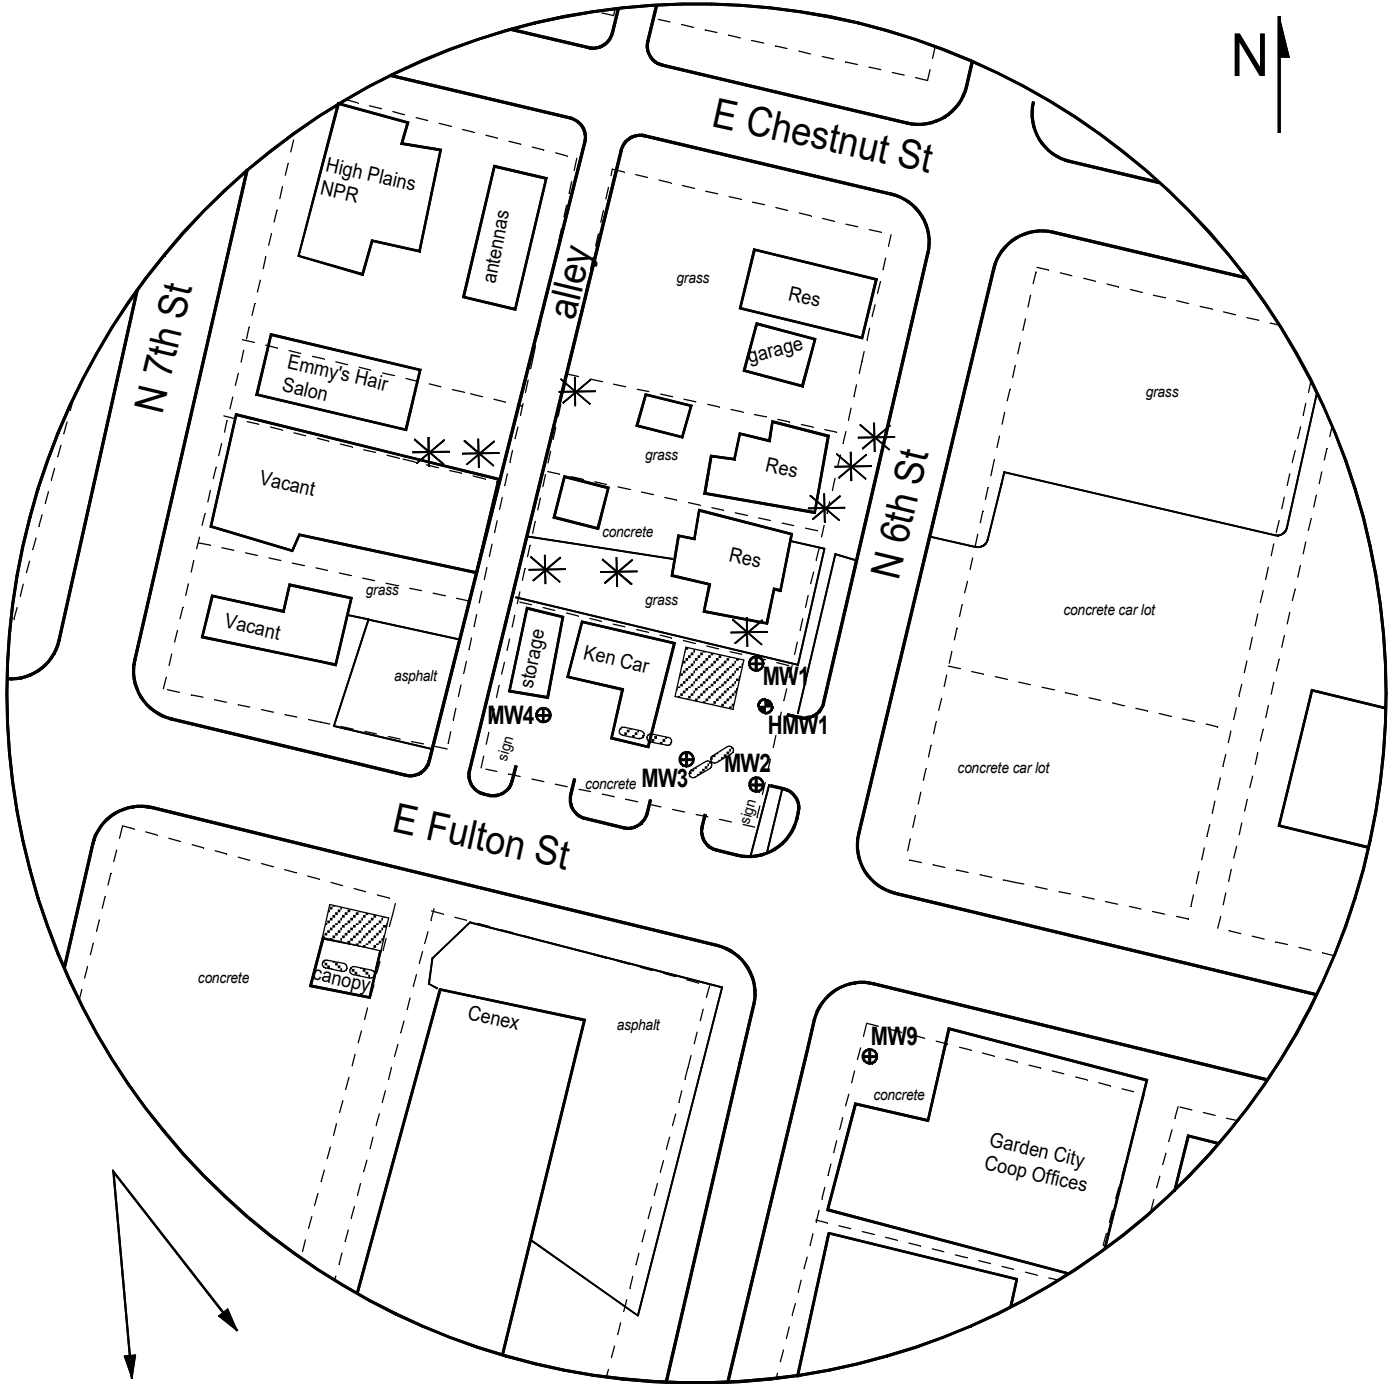

Estimated Groundwater Flow Direction

FIGURE 3 - 350 FT RADIUS AREA BASE MAP

LEGEND:

- Approximate Location of Inactive UST Basin and Pump Island
- Approximate Location of Former Pump Island
- Building with Basement
- Existing Monitoring Well (Hort's Tire & Service U1-028-00264)
- New Monitoring Well (Installed 8/5-7/24)
- Sanitary Sewer (2 - 6 ft BGS)



PROJECT:
 Ken Car, Inc. - Western Tire
 207 E Fulton,
 Garden City, KS
 KDHE ID: U1-028-15393
 Date: 8/7-8/24



1311 E 25th St., Suite B, Lawrence, KS 66046
 Office: (785) 841-8707

NOTE: Utility depths and locations are approximate.

SMH CONSULTANTS

August 26, 2024

Jessica Chapman
Larsen & Associates
1311 E 25th Street, Suite B
Lawrence, KS 66046

RE: Project No. 2408-0290

Jessica,

The following is the information requested on a Monitoring Well Site, Ken Car, Inc. – Western Tire, Garden City, Finney County, Kansas.

Point	North Coord.	East Coord.	Distance SE Cor. North	From Sec. West	Elev. Top Of Rim or PK Nail	Elev. Top of PVC Pipe	Latitude North	Longitude West
SE cor: S18-T24S-R32W	40000	40000						
MW1	41821.35	38175.67	1821.35	1824.33	2837.18	2837.00	37.96547	100.87177
MW2	41767.87	38177.02	1767.87	1822.98	2836.65	2836.69	37.96532	100.87176
MW3	41785.48	38149.54	1785.48	1850.46	2837.02	2836.66	37.96537	100.87186
MW4	41800.57	38072.74	1800.57	1927.26	2837.10	2836.69	37.96541	100.87213
MW9	41628.85	38233.90	1628.85	1766.10	2836.13	2835.89	37.96494	100.87156
Site BM	41782.41	38164.58	1782.41	1835.42		SBM Elevation = 2837.42		

Description: square cut on center of Northeast side of East Pump Island

MW1,MW2,MW3,MW4 are in the:
MW9, is in the:

NW¼ SE¼ NW¼ SE¼ S18-T24S-R32W
SW¼ SE¼ NW¼ SE¼ S18-T24S-R32W

If you have any questions, please do not hesitate in giving us a call.

Sincerely,



Tim Sloan, L.S.
SMH CONSULTANTS

COLORADO SPRINGS
411 South Tejon Street, Suite i
Colorado Springs, CO 80903
P: 719-465-2145

DODGE CITY
707 3rd Avenue, Suite A
Dodge City, KS 67801
P: 620-255-1952

MANHATTAN - HQ
2017 Vanesta Place, Suite 110
Manhattan, KS 66503
P: 785-776-0541

KANSAS CITY
5201 Johnson Drive, Suite 405
Mission, KS 66205
P: 913-444-9615