

WATER WELL RECORD (WWC-5)

KOLAR DOC ID _____ WELL ID _____
 Original Record Correction Change in Well Use

LOCATION OF WATER WELL

Latitude		Longitude		Section		Township		Range		E W	Fraction	¼	¼	¼
Datum		Elevation		County										

WATER WELL OWNER

Name	
Business	
Address	
Well location at owner's address	

WELL WATER USE

--

COMPLETION

Depth of completed well: _____ ft.
Depth(s) groundwater encountered: (1) _____ ft.; (2) _____ ft.; (3) _____ ft.; (4) dry well
Static water level in well: _____ ft. measured below land surface on (mm/dd/yy): _____ measured above land surface on (mm/dd/yy): _____
Estimated yield: _____ gpm
Water level was: _____ ft. after _____ hours pumping _____ gpm
Pump installed? Yes No
Water well disinfected? Yes No
Date disinfected (mm/dd/yy): _____
Aquifer, if known:

NEAREST SOURCE OF POTENTIAL CONTAMINATION

Source: _____
Distance from well: _____ Direction from well: _____
Source description: _____
Source: _____
Distance from well: _____ Direction from well: _____
Source description: _____
No potential source of contamination within 100 feet.

CONSTRUCTION

Borehole interval: from _____ to _____ ft.	Borehole diameter: _____ in.
from _____ to _____ ft.	_____ in.
Casing height above land surface: _____ in.	
If casing height is less than 12 in. has a variance been approved?* Yes No	
*variance not required for monitoring or environmental remediation wells	
Casing type: _____	
Blank casing interval: _____ ft. to _____ ft.	
Blank casing diameter: _____ in.	
Casing joints: _____	
Weight: _____ lbs/ft.	
Wall thickness or gauge no.: _____	
Blank casing interval: _____ ft. to _____ ft.	
Blank casing diameter: _____ in.	
Casing joints: _____	
Weight: _____ lbs/ft.	
Wall thickness or gauge no.: _____	
Grout interval: _____ ft. to _____ ft.	
Grout material: _____	
Grout interval: _____ ft. to _____ ft.	
Grout material: _____	
Screen / perforation material: _____	
Screen / perforation openings: _____	
Screen / perforation intervals: From _____ ft. to _____ ft.	
Slot size _____ unit _____	
From _____ ft. to _____ ft.	
Slot size _____ unit _____	
Gravel pack intervals: Gravel pack not used: Gravel size _____ in	
From _____ ft. to _____ ft.	
Gravel pack not used: Gravel size _____ in	
From _____ ft. to _____ ft.	

PERMIT & ID NUMBERS (AS REQUIRED)

DWR Application No.: _____
KDHE / EPA Project Code: _____
Site Name: _____
KDHE UIC Class V Form Completed: Yes No
County Permit: Yes No Permit ID: _____
Lease Name & Well #: _____
of boreholes: _____ # of dewatering wells: _____

LITHOLOGIC LOG

FROM	TO	LITHOLOGY INTERVALS

COMMENTS

--

CONTRACTOR'S OR LANDOWNERS CERTIFICATION

This water well was constructed reconstructed pursuant to the stated water well contractor's license and was completed on _____. I certify that this record is true to the best of my knowledge and belief. This water well record was completed on _____ under the business name of _____, Kansas Water Well Contractor's License No. _____ under the authority of the designated person as defined in K.A.R. 28-30-2(j) and signed and certified by the electronic signature of the designated person at its submittal: _____.

Send one copy to WATER WELL OWNER and retain one for your records. Fee of \$5.00 for each constructed well.

DENNIS L HANDKE

1820 NW 59th Terrace
TOPEKA, KANSAS 66618
785-286-4047 Home

Jessica Chapman
Larsen & Associates
1607 SW 41st Street
Lawrence, Kansas, 66609

August 3, 2024

RE: Monitor Well Elevation Survey
2334 N. Main, Great Bend, Kansas

Proj. 24-00HH
Kwik Shop #747
U6-005-13702

Bench Mark: "O" on top of fire hydrant near the Northwest corner of property.

Elev: 1848.07 North 5241.63 West 2676.67 (from SE Cor. Sec. 28-19-13W)

MW-1RR	rim	1846.63	North	5205 78	NW1/4,NW1/4,NW1/4,NE1/4
	top pipe	1846.22	West	2639.82	Lat= 38.37615 Long = 98.76496
MW-9R	rim	1845.88	North	5140 77	NW1/4,NW1/4,NW1/4,NE1/4
	top pipe	1845.62	West	2648.63	Lat= 38.37597 Long = 98.76499

Elevation derived from existing project.

Lat & Long derived from Great Bend 7.5' Quad Map. WGS84

If you have any questions, please feel free to call me. Thank you for the opportunity to be of service to you.



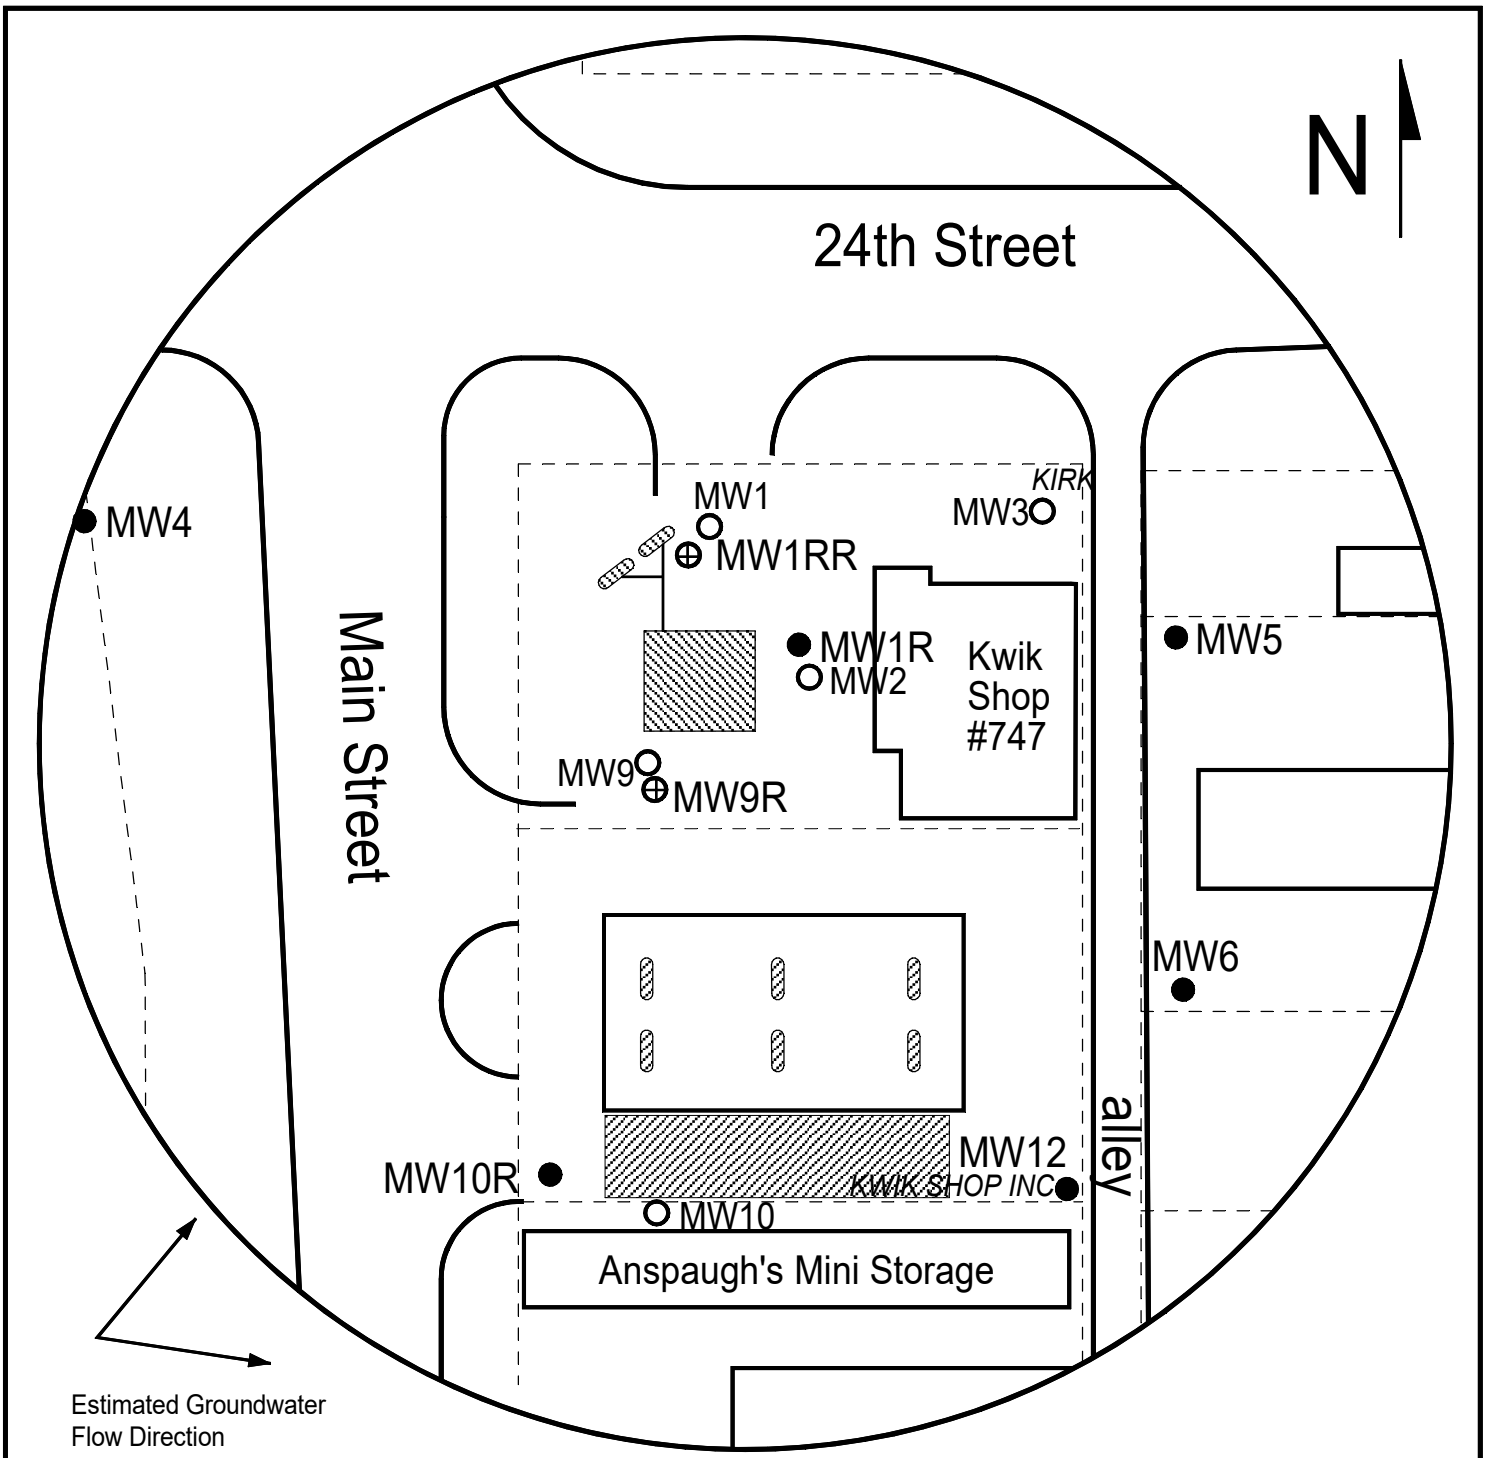


FIGURE 2 - DETAILED SITE BASE MAP

LEGEND

- Approximate Location of Active UST Basin & Pump Island
 - Approximate Location of Former UST Basin, Product Lines, & Pump Island
 - Existing Monitoring Well
 - Proposed Monitoring Well
 - Plugged Monitoring Well
 - Proposed Soil Boring
 - Property Lines
 - Fire Hydrant
 - Electric Lines (2-6 ft bgs)
 - Gas Lines (2-6 ft bgs)
 - Sewer Lines (2-6 ft bgs)
 - Overhead Lines
 - Water Lines (2-6 ft bgs)
- NOTE: Utility depths and locations are approximate.
NOTE: SB9 & SB10 will be used to collect hydrologic samples.



PROJECT:

Kwik Shop #747
2334 N. Main
Great Bend, KS
KDHE ID: U6-005-13702
Date: 8/29/23



1311 E 25th St., Suite B (785) 841-8707 office
Lawrence, KS 66046 (785) 865-4282 fax