KOLAR Document ID: 1795862

WATER WELL RECORD (WWC-5)

KOLAR DOC ID

Correction

Lease Name & Well #: _

of boreholes: _____ # of dewatering wells: _

Original Record

WELL ID_____ Change in Well Use

LOCATION OF WATER WELL

Latitude	Longitude	Section	Т	Township	F	Range	E W	Fraction	1⁄4	1⁄4	1⁄4
Datum	Elevation	County									

WATER WELL OWNER

Name	
Business	
Address	
Well location	
at owner's address	
CONCERNICE	

CONSTRUCTION

Borehole interval:	Borehole diameter:
fromtoft.	in.
fromtoft.	in.
Casing height above land su	
If casing height is less the has a variance been appr *variance not required fo	roved?* Yes No
or environmental remed	U U
Casing type:	
Blank casing interval:	ft. toft.
Blank casing diameter:	in.
Casing joints:	
Weight:lbs	s/ft.
Wall thickness or gauge	no.:
Blank casing interval:	ft. toft.
Blank casing diameter:	in.
Casing joints:	
Weight:lbs	s/ft.
Wall thickness or gauge	no.:
Grout interval: ft. to	ft.
Grout material:	
Grout interval: ft. to	oft.
Grout material:	
Screen / perforation material	:
Screen / perforation opening	gs:
Screen / perforation intervals	S:
Fromft. to	_ft.
Slot size unit _	
Fromft. to	_ft.
Slot size unit _	
Gravel pack intervals:	
Gravel pack not used:	Gravel size in
From ft. to	ft.
Gravel pack not used:	
From ft. to	

	County							
WELL WATER USE								
сом	PLETION							
Dept	th of compl	eted we	11:		ft.			
	th(s) groun							
(1)_	ft.;	(2)	ft.;					
(3) _	ft.;	(4)	dry well					
Stati	c water leve	el in wel	l:	ft.				
	neasured be on (mm/dd/		d surface					
	neasured at on (mm/dd/		d surface					
Estir	nated yield	:	_gpm					
Wate	er level was	:	ft. after		hours			
			pumping		gpm			
Pum	p installed	Yes	No					
Wate	er well disir	fected?	Yes	No				

NEAREST SOURCE OF	POTENTIAL CONTAMINATION
Source:	
Distance from well:	Direction from well:
Source description:	
Source:	
Distance from well:	Direction from well:
Source description:	
No potential sour within 100 feet.	ce of contamination
PERMIT & ID NUMBE	RS (AS REQUIRED)
DWR Application No	D.:
KDHE / EPA Project	Code:
Site Name:	
KDHE UIC Class V I	Form Completed: Yes No
County Permit: Ye	s No Permit ID:

Aquifer, if known:

Date disinfected (mm/dd/yy):


FROM	то	LITHOLOGY INTERVALS	

COMMENTS

CONTRACTOR'S OR LANDOWNERS CERTIFICATION

This water well was constructed	reconstructed	pursuant to the stated water well
contractor's license and was complete	ed on	I certify that this record is true to
the best of my knowledge and belief.	This water well rec	ord was completed on
under the business name of		,
Kansas Water Well Contractor's Licer	nse No	_ under the authority of the designated
person as defined in K.A.R. 28-30-2(j) and signed and c	ertified by the electronic signature of the
designated person at its submittal:		·
Send one copy to WATER WELL OWNER a	and retain one for you	r records. Fee of \$5.00 for each constructed well.
KANSAS DEPAR	TMENT OF HEALTH	AND ENVIRONMENT

Bureau of Water, Geology Section, 1000 SW Jackson St., Suite 420, Topeka KS 66612-1367 (785) 296-3565 | K.S.A. 82a-1212 | v2022c

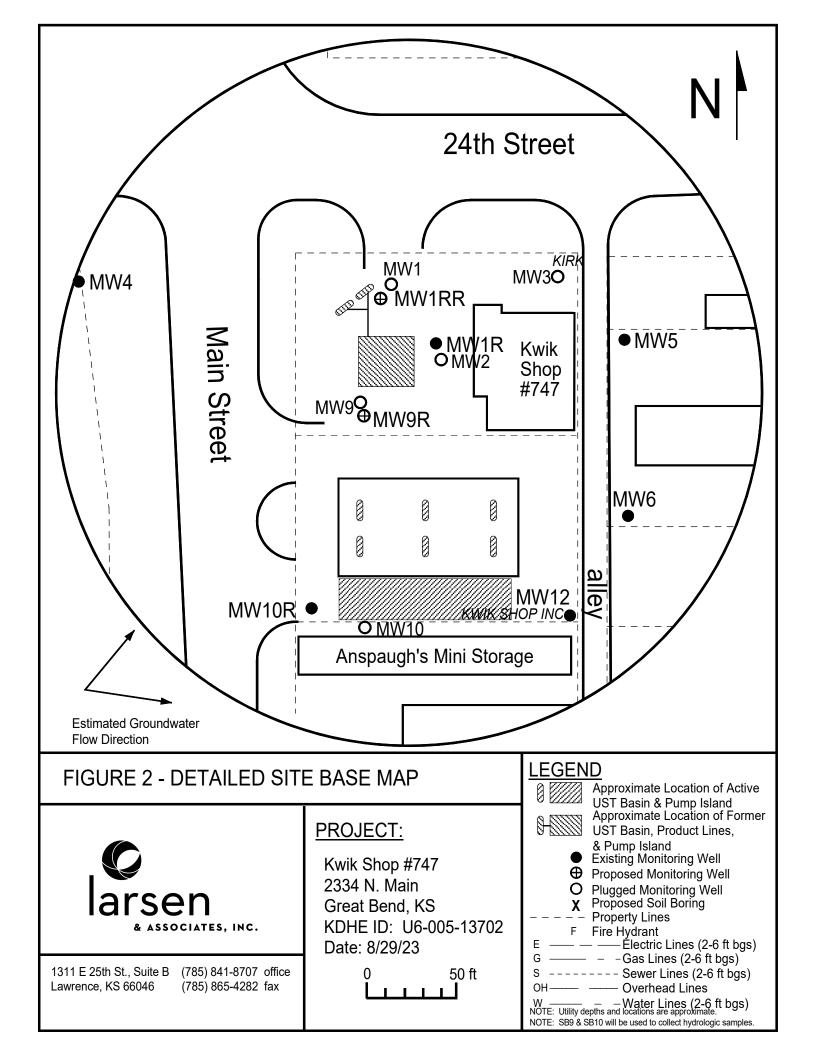

DENNIS L HANDKE 1820 NW 59th Terrace TOPEKA, KANSAS 66618 785-286-4047 Home

Jessica Chapman Larsen & Associates 1607 SW 41st Street Lawrence, Kansas, 66609

RE: Monitor Well Elevation Survey 2334 N. Main, Great Bend, Kansas

August 3, 2024

Proj. 24-00HH Kwik Shop #747 U6-005-13702

(from SE Cor. Sec. 28-19-13W)

Bnch Mark: "O" on top of fire hydrant near the Northwest corner of property. Elev: 1848.07 North 5241.63 West 2676.67

MW-1RR	rim	1846.63	North	5205 78	NW1/4,NW1/4,NW1/4,NE1/4
	top pipe	1846.22	West	2639.82	Lat= 38.37615 Long = 98.76496
MW-9R	rim	1845.88	North	5140 77	NW1/4,NW1/4,NW1/4,NE1/4
	top pipe	1845.62	West	2648.63	Lat= 38.37597 Long = 98.76499

Elevation derived from existing project.

Lat & Long derived from Great Bend 7.5' Quad Map. WGS84

If you have any nuestions, please feel free to call me. Thank you for the opportunity to be

