KOLAR Document ID: 1802230

WATER WELL RECORD (WWC-5)

KOLAR DOC ID

Correction

Lease Name & Well #: ____

of boreholes: _____ # of dewatering wells: _

Original Record

WELL ID_____ Change in Well Use

LOCATION OF WATER WELL

Latitude	Longitude	Section	Т	Township	F	Range	E W	Fraction	1⁄4	1⁄4	1⁄4
Datum	Elevation	County									

WATER WELL OWNER

Name				
Business				
Address				
Well location				
at owner's address				
CONSTRUCTION				

CONSTRUCTION

Borehole interval:	Borehole diameter:
fromtoft.	in.
fromtoft.	in.
Casing height above land su	
If casing height is less the has a variance been appr *variance not required fo	roved?* Yes No
or environmental remed	U U
Casing type:	
Blank casing interval:	ft. toft.
Blank casing diameter:	in.
Casing joints:	
Weight:lbs	s/ft.
Wall thickness or gauge	no.:
Blank casing interval:	ft. toft.
Blank casing diameter:	in.
Casing joints:	
Weight:lbs	s/ft.
Wall thickness or gauge	no.:
Grout interval: ft. to	ft.
Grout material:	
Grout interval: ft. to	oft.
Grout material:	
Screen / perforation material	:
Screen / perforation opening	gs:
Screen / perforation intervals	S:
Fromft. to	_ft.
Slot size unit _	
Fromft. to	_ft.
Slot size unit _	
Gravel pack intervals:	
Gravel pack not used:	Gravel size in
From ft. to	ft.
Gravel pack not used:	
From ft. to	

	County					
WELL WATER USE						
сом	PLETION					
Dep	th of compl	eted we	11:		ft.	
	th(s) groun					
(1)_	ft.;	(2)	ft.;			
(3) _	ft.;	(4)	dry well			
Stati	Static water level in well: ft.					
	neasured be on (mm/dd/		d surface			
measured above land surface on (mm/dd/yy):						
Estir	nated yield	:	_gpm			
Wate	er level was	:	ft. after		hours	
			pumping		gpm	
Pum	p installed	Yes	No			
Wate	er well disir	fected?	Yes	No		

NEAREST SOURCE OF F	POTENTIAL CONTAMINATION
Source:	
Distance from well:	Direction from well:
Source description:	
Source:	
Distance from well:	Direction from well:
Source description:	
No potential sourc within 100 feet.	e of contamination
PERMIT & ID NUMBER	(AS REQUIRED)
DWR Application No.	:
KDHE / EPA Project C	Code:
	orm Completed: Yes No
County Permit: Yes	No Permit ID:

Aquifer, if known:

Date disinfected (mm/dd/yy):


FROM	то	LITHOLOGY INTERVALS			

COMMENTS

CONTRACTOR'S OR LANDOWNERS CERTIFICATION

This water well was constructed	reconstructed	pursuant to the stated water well				
contractor's license and was complete	I certify that this record is true to					
the best of my knowledge and belief. This water well record was completed on						
under the business name of		······,				
Kansas Water Well Contractor's Licer	nse No	_ under the authority of the designated				
person as defined in K.A.R. 28-30-2(j) and signed and certified by the electronic signature of the						
designated person at its submittal:		·				
Send one copy to WATER WELL OWNER	and retain one for you	r records. Fee of \$5.00 for each constructed well				
KANSAS DEPARTMENT OF HEALTH AND ENVIRONMENT						

Bureau of Water, Geology Section, 1000 SW Jackson St., Suite 420, Topeka KS 66612-1367 (785) 296-3565 | K.S.A. 82a-1212 | v2022c

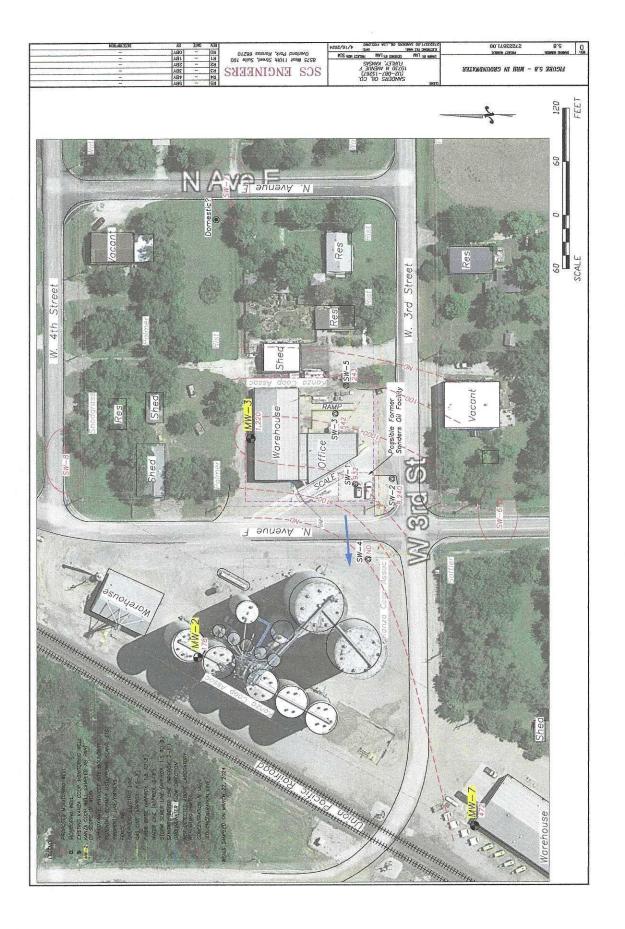

of 1