WELL ID


KOLAR DOC ID

(785) 296-3565 | K.S.A. 82a-1212 | v2022c

WATER WELL RECORD (WWC-5)

LOCATION OF WATER WELL						Original Reco	ord (Correction	Chang	e in Wel	l Use
Latitude	Longitude		S	ection	Township	Range		E W Fraction	1/4	1/4	1/4
Datum	Elevation			ounty	1	8		W			
WATER WELL OWNER	Lievation			ATER USE			NEADE	ST SOURCE OF	DOTENTIAL C	ONITA MAIN	IATION
			VV LLL VV	AI LK OJL	-						IATION
Name							Distan	::	Direction		
Business			COMPL	ETION			from v	vell:	from wel	l:	
Address			Depth of completed well:ft.				Source				
Address			Depth(s) groundv	water encountered:		descrip				
			(1)	ft.;	(2) ft.;		Source	::			
Well location			(3)	ft.; ((4) dry well		D		D: .:	n	
			Static v	ater level	in well:f	t.			from we	l:	
at owner's address			mea		w land surface		Source descrip				
CONSTRUCTION			mea	sured abo	ve land surface			potential source	e of contami	nation	
Borehole interval:	Borehole dia	meter:	on (on (mm/dd/yy):					OS (AS DEQUI	DED)	
fromto ft.		in.	Estima	ed yield:	gpm		PERIVII	& ID NUMBER	IJ (MO REQUI	NEU)	
fromto ft.		in.	Water l	evel was:	ft. after	hours	DWR	Application No.	.:		
Casing height above land sur					pumping	gpm	KDHE	E / EPA Project (Code:		
If casing height is less tha			Pump i	nstalled?	Yes No		Site Name:				
has a variance been appro					KDHE UIC Class V Form Completed: Yes No						
*variance not required for monitoring					ected? Yes No		Count	y Permit: Yes	No Permi	t ID:	
or environmental remediation wells			Date disinfected (mm/dd/yy):				Lease Name & Well #:				
Casing type:Blank casing interval:	ft to		Aquife	; if known	:		# of bo	oreholes:	# of dewater	ing wells:	
Blank casing diameter:				OGIC LOG							
Casing joints:			FROM		LITHOLOGY I	NTERVALS					
Weight: lbs/			TROM	10	Emilozodii	NILIVALS					
Wall thickness or gauge n											
Blank casing interval:											
Blank casing diameter:											
Casing joints:											
Weight: lbs/											
Wall thickness or gauge n											
Grout interval: ft. to											
Grout material:											
Grout interval: ft. to			СОММЕ	NTS							
Grout material:											
Screen / perforation material:											
Screen / perforation opening					OR LANDOWNERS						
Screen / perforation intervals:			This w	ater well	was constructed	d reconsti	ructed	pursuant to	the stated w	ater well	
Fromft. to			contra	ctor's lice	ense and was com	pleted on		I certify th	at this recor	d is true 1	to
Slot size unit _			the be	st of my k	nowledge and be	elief. This water	well reco	rd was comple	eted on		
Fromft. to			under	the busin	ess name of						,
Slot size unit _			Kansa	s Water V	Vell Contractor's	License No.		under the au	thority of th	e designa	ited
Gravel pack intervals:									•	_	
Gravel pack not used: Gravel sizein			person as defined in K.A.R. 28-30-2(j) and signed and certified by the electronic signature of the designated person at its submittal:								
From ft. to							no for	racorda ECA	E 00 for1	conctu	d r.r.11
Gravel pack not used:		in	sena one	copy to V	VATER WELL OW: KANSAS DI	NER and retain o E PARTMENT OF				constructe	a well.
From ft. to	_ ft.			Bureau	of Water, Geology					2-1367	

727 N WACO STE 265 • WICHITA, KS 67203 • 316.262.5698

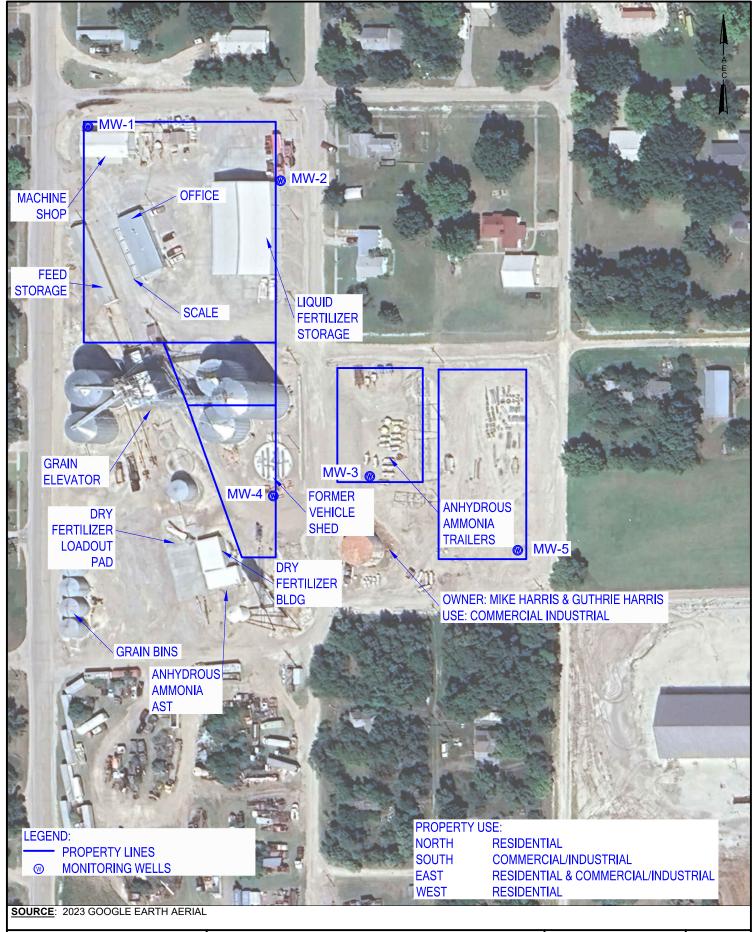

MONITORING WELL LOCATIONS BURR OAK, KANSAS PROJECT: 24070:0288 FIGURE

SCALE: 1"=80'
DATE: 11/11/2024

DWN BY: SMB CHKD BY: DAB SHT:1.0F.1

JEO Consulting Group, Inc. Job No. 242466 For: ALLIED ENVIROMENTAL 12/27/2024

MIDWAY COOP MONITORING WELLS BURR OAK, KANSAS FIELD WORK COMPLETED ON 12/5/2024 FIELD CREW: BRANDON SCHROEDER

HORIZONTAL DATUM (US SURVEY FEET)= KANSAS NORTH (NAD 83) 1995 ADJUSTMENT VERTICAL DATUM (US SURVEY FEET)= NAVD 88

			PVC	TOP OF	GROUND		
DESCRIPTION	NORTHING	EASTING	ELEVATION	CONCRETE	ELEVATION	LAT	Long
MW-1	559079.00	1226485.96	1657.89	1658.13	1658.1	39.8679137	-98.3058270
MW-2	559007.75	1226732.10	1658.14	1658.39	1658.3	39.8677204	-98.3049493
MW-3	558613.09	1226853.09	1655.17	1655.63	1655.6	39.8666381	-98.3045135
MW-4	558602.16	1226728.88	1658.44	1658.77	1658.7	39.8666069	-98.3049559
MW-5	558509.02	1227057.22	1654.96	1655.35	1655.3	39.8663543	-98.3037851