Change in Well Use

WELL ID

Correction

KOLAR DOC ID

(785) 296-3565 | K.S.A. 82a-1212 | v2022c

Original Record

WATER WELL RECORD (WWC-5)

LOCATION	OF V	ATER WELL	L												
Latitude			Longitude			Section		Township		Range	E W	Fraction	1/4	1/4	1/4
Datum			Elevation			County									
WATER WI	ELL O	VNER			WELL	. WATER U	SE				NEAREST S	OURCE OF F	POTENTIAL (ONTAMI	NATION
Name											Source:				
Business					СОМІ	PLETION					Distance from well-		Direction		
Address					Depth of completed well:ft. Depth(s) groundwater encountered:						ı:				
Well location				(3)	(1) ft.; (2) ft.; (3) ft.; (4) dry well					Dietance		Directio	on ell:		
at owner's address			Static water level in well: ft. measured below land surface on (mm/dd/yy):						Source description:						
CONSTRU	CTION	ı			measured above land surface						No potential source of contamination within 100 feet.				
Borehole	interv	al:	Borehole dia	meter:	on (mm/dd/yy):										
from	to _	ft.		in.	Estir	nated yield	l:	gpm			PERMIT & ID NUMBERS (AS REQUIRED)				
from	to_	ft.		in.	Wate	er level wa	8:	ft. after	ho	urs	DWR Application No.:				
Casing he	eight al	ove land sur	rface:	in.				pumping	gp	m	KDHE / EPA Project Code:				
		ght is less tha			Pum	p installed	? Ye	s No			Site Name:				
		ce been appr		s No	Mate	w wall disi	nfactadi	Vac N			KDHE UIC Class V Form Completed: Yes No				
		ot required to nental remed	or monitoring diation wells		Water well disinfected? Yes No						County Permit: Yes No Permit ID:				
Casing ty	pe:				Date disinfected (mm/dd/yy):						Lease Name & Well #: # of boreholes: # of dewatering wells:				I
Blank cas	ing int	erval:	ft. to	ft.	Aquifer, if known:						# Of boren	nes:	# of dewate	ring wells:	
Blank cas	ing dia	meter:	in.		LITHO	DLOGIC LO	OG								
Casing joints:					FRC	M T) L	ITHOLOGY I	NTERVA	LS					
Weight:lbs/ft.															
Wall thickness or gauge no.:															
Blank casing interval:ft. toft.															
Blank casing diameter:in.															
Casing joints: lbs/ft.															
Wall thickness or gauge no.:															
		ft. to													
		rial:ft_to													
Grout interval:ft. toft. Grout material:						MENTS									
Screen / p	erfora	tion material:	:												
Screen / perforation openings:					CONTRACTOR'S OR LANDOWNERS CERTIFICATION										
Screen / perforation intervals:					This water well was constructed reconstructed pursuant to the stated water well										
Fromft. toft.					cont	contractor's license and was completed on I certify that this record is true to									
Slot size unit the					the best of my knowledge and belief. This water well record was completed on										
Fromft. toft.						under the business name of,									
Slot size unit					Kansas Water Well Contractor's License No under the authority of the designated										
Gravel pack intervals:						person as defined in K.A.R. 28-30-2(j) and signed and certified by the electronic signature of the									
Gravel pack not used: Gravel sizein					1	designated person at its submittal:									
From 1. to 1.								ed well							
WANGAG DEDADTMENT OF HEATTH AND ENVIDONMENT															
From ft. to ft.							au of Wa				Jackson St., Sı			2-1367	

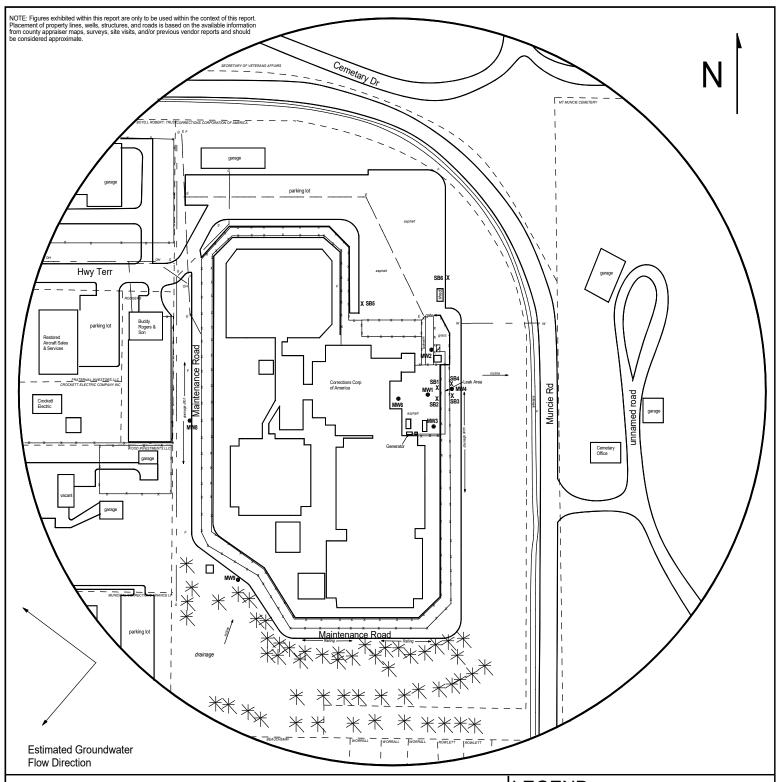


FIGURE 2 - 800 FT RADIUS AREA BASE MAP



Office: (785) 841-8707 1311 E 25th St., Suite B, Lawrence, KS 66046

PROJECT:

Corrections Corp. of America 100 Highway Terrace, Leavenworth, KS KDHE ID: A4-052-40533 Date: 11/1/24

200 feet

LEGEND:

- Approximate Location of Active ATS Basin and Product Lines
 - ◆ Monitoring Well (Installed 11/25-27/24 & 12/2/24)
 - X Proposed Soil Boring
 - * Tree/Shrub
 - Fire Hydrant
 - s Sewer
- Overhead Lines (25-40 ft high) Gas (2 - 6 ft BGS) Water (2 - 6 ft BGS)

Electric (2 - 6 ft BGS)

NOTE: Utility depths, heights and locations are approximate. NOTE: SB5 & SB6 will be drilled to collect hydrological sample

DENNIS L HANDKE

1820 NW 59th Terrace TOPEKA, KANSAS 66618 785-286-4047 Home

Jess Chapman Larsen & Assoc. 1311 E. 25th St., Suite B Topeka, Kansas 66046

December 17, 2024

RE: Monitor Well Elevation Survey 100 Highway Terrace, Leavenworth, Kansas

Proj. 24-00XX Corrections Corp. of America KDHE ID A4-052-40533

Bench Mark: Chisled square on SW corner of 16" x 24" concrete electric motor pad at the SE corner of the concrete fuel tank pad at the North gate to the East fenced compound.

Elev.:	867.56	North 4785.54	We	est 2858.57	(from SE Cor. Sec. 18-9-23E)
MW-1	rim	864.08	North	4693.58	SE1/4,NE1/4,NE1/4,NW1/4
	top pipe	863.74	West	2880.15	Lat $= 39.27252$ Long $= 94.89134$
MW-2	rim	865.96	North	4792.03	SE1/4,NE1/4,NE1/4,NW1/4
	top pipe			2875.07	Lat = 39.27279 Long = 94.89132
MANA					_
MW-3	rim	863.17	North	4619.95	NE1/4,SE1/4,NE1/4,NW1/4
	top pipe	862.91	West	2864.56	Lat $= 39.27231$ Long $= 94.89129$
MW-4	rim	864.23	North	4986.72	SE1/4,NE1/4,NE1/4,NW1/4
	top pipe	863.88		2815.82	Lat = 39.27249 Long = 94.89111
MANA	•	065.06		1 (00 00	
MW-6	rim	865.96		4692.29	SE1/4,NE1/4,NE1/4,NW1/4
	top pipe	865.65	West	2941.30	Lat $= 39.27252$ Long $= 94.89156$
MW-8	rim	855.25	North	4665.86	SE1/4,NW1/4,NE1/4,NW1/4
	top pipe	854.96		3377.17	Lat = 39.27246 Long = 94.89310
MW-9		955.16	N T 41	1201.06	N 14 6 7 4 4 5 7 7 4 4 5 7 7 4 4 5 7 7 7 4 4 5 7 7 7 7
W W -9	rim			4301.26	NW1/4,SE1/4,NE1/4,NW1/4
	top pipe	854.97	West	3257.20	Lat $= 39.27146$ Long $= 94.89269$

Lat & Long derived from Leavenworth 7.5' quad map. WGS84.

Elevation derived from Leavenworth County BM #0512. NAVD 88.

If you have land regions, please feel free to call me. Thank you for the opportunity to be

ennis L Handke RLS

SURVE