## KOLAR Document ID: 1827986

# WATER WELL RECORD (WWC-5)

KOLAR DOC ID

Correction

Original Record

WELL ID\_\_\_\_\_ Change in Well Use

### LOCATION OF WATER WELL

Latitude	Longitude	Section	Township	Range	E W	Fraction	1⁄4	1⁄4	1⁄4
Datum	Elevation	County							

#### WATER WELL OWNER

Name				
Business				
Address				
Well location				
at owner's address				

#### CONSTRUCTION

Borehole interval:	Borehole diameter:
fromtoft.	in.
fromtoft.	in.
Casing height above land su	
If casing height is less the has a variance been appr *variance not required fo	roved?* Yes No
or environmental remed	U U
Casing type:	
Blank casing interval:	ft. toft.
Blank casing diameter:	in.
Casing joints:	
Weight:lbs	s/ft.
Wall thickness or gauge	no.:
Blank casing interval:	ft. toft.
Blank casing diameter:	in.
Casing joints:	
Weight:lbs	s/ft.
Wall thickness or gauge	no.:
Grout interval: ft. to	ft.
Grout material:	
Grout interval: ft. to	oft.
Grout material:	
Screen / perforation material	:
Screen / perforation opening	gs:
Screen / perforation intervals	S:
Fromft. to	_ft.
Slot size unit _	
Fromft. to	_ft.
Slot size unit _	
Gravel pack intervals:	
Gravel pack not used:	Gravel size in
From ft. to	ft.
Gravel pack not used:	
From ft. to	

	County							
WELL	WELL WATER USE							
сом	PLETION							
Dept	th of comp	leted w	vell:		ft.			
Dept	th(s) groui	ndwater	r encounter	ed:				
(1)_	ft.;	(2)	ft.;					
(3)	ft.;	(4)	dry well					
Stati	Static water level in well: ft.							
	measured below land surface on (mm/dd/yy):							
	measured above land surface on (mm/dd/yy):							
Estir	nated yield	l:	gpm					
Wate	er level wa	s:	ft. after		hours			
			pumping		gpm			
Pum	p installed	? Ye	es No					
Wate	er well disi	nfected	? Yes	No				

NEAREST SOURCE	OF POTENTIAL CONTAMINATION
Source:	
Distance from well:	Direction from well:
Source description:	
Source:	
Distance from well:	Direction from well:
Source description:	
No potential so within 100 feet	ource of contamination
PERMIT & ID NUM	BERS (AS REQUIRED)
DWR Application	No.:
KDHE / EPA Proje	ect Code:
	V Form Completed: Yes No

County Permit: Yes No Permit ID: \_

# of boreholes: \_\_\_\_\_ # of dewatering wells: \_

Lease Name & Well #:

# Aquifer, if known:

Date disinfected (mm/dd/yy):

### LITHOLOGIC LOG


FROM	то	LITHOLOGY INTERVALS

#### COMMENTS

#### CONTRACTOR'S OR LANDOWNERS CERTIFICATION

This water well was constructed	reconstructed	pursuant to the stated water well					
contractor's license and was complete	I certify that this record is true to						
the best of my knowledge and belief. This water well record was completed on							
under the business name of		,					
Kansas Water Well Contractor's Licer	nse No	_ under the authority of the designated					
person as defined in K.A.R. 28-30-2(j) and signed and certified by the electronic signature of the							
designated person at its submittal:							
Send one copy to WATER WELL OWNER	and retain one for you	r records. Fee of \$5.00 for each constructed well.					
KANSAS DEPAR	TMENT OF HEALTH	AND ENVIRONMENT					

Bureau of Water, Geology Section, 1000 SW Jackson St., Suite 420, Topeka KS 66612-1367 (785) 296-3565 | K.S.A. 82a-1212 | v2022c

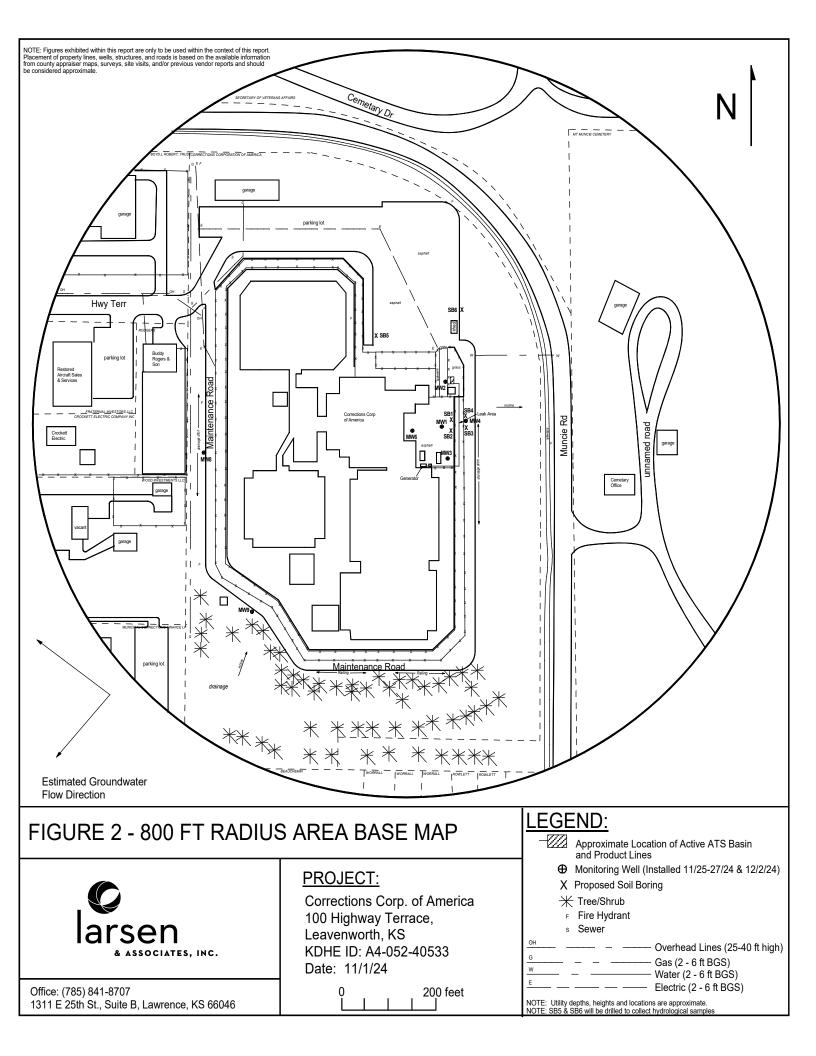

DENNIS L HANDKE 1820 NW 59th Terrace TOPEKA, KANSAS 66618 785-286-4047 Home

Jess Chapman Larsen & Assoc. 1311 E. 25<sup>th</sup> St., Suite B Topeka, Kansas 66046

RE: Monitor Well Elevation Survey 100 Highway Terrace, Leavenworth, Kansas December 17, 2024

Proj. 24-00XX Corrections Corp. of America KDHE ID A4-052-40533

Bench Mark: Chisled square on SW corner of 16" x 24" concrete electric motor pad at the SE corner of the concrete fuel tank pad at the North gate to the East fenced compound.

Elev.:	867.56	North 4785.54	We	st 2858.57	(from SE Cor. Sec. 18-9-23E)
MW-1	rim top pipe	864.08 863.74		4693.58 2880.15	SE1/4,NE1/4,NE1/4,NW1/4 Lat = 39.27252 Long = 94.89134
MW-2	rim top pipe	865.96 865.60		4792.03 2875.07	SE1/4,NE1/4,NE1/4,NW1/4 Lat = 39.27279 Long = 94.89132
MW-3	rim top pipe	863.17 862.91		4619.95 2864.56	NE1/4,SE1/4,NE1/4,NW1/4 Lat = 39.27231 Long = 94.89129
MW-4	rim top pipe	864.23 863.88		4986.72 2815.82	SE1/4,NE1/4,NE1/4,NW1/4 Lat = 39.27249 Long = 94.89111
MW-6	rim top pipe	865.96 865.65		4692.29 2941.30	SE1/4,NE1/4,NE1/4,NW1/4 Lat = 39.27252 Long = 94.89156
MW-8	rim top pipe	855.25 854.96		4665.86 3377.17	SE1/4,NW1/4,NE1/4,NW1/4 Lat = 39.27246 Long = 94.89310
MW-9	rim top pipe	855.16 854.97		4301.26 3257.20	NW1/4,SE1/4,NE1/4,NW1/4 Lat = 39.27146 Long = 94.89269

Lat & Long derived from Leavenworth 7.5' quad map. WGS84.

Elevation derived from Leavenworth County BM #0512. NAVD 88.

If you havelany onestions, please feel free to call me. Thank you for the opportunity to be of samice to you. Dennis L Handke RLS Jecember 17, 2020 A ANSA SURVEY ON THE OPPORTUNE SURVEY OF THE OPPORTUNE THE OPPORTUNE SURVEY OF THE OPPORTUNE T