KOLAR Document ID: 1830374

WATER WELL RECORD (WWC-5)

KOLAR DOC ID

Source: Distance

Correction

Original Record

WELL ID Change in Well Use

LOCATION OF WATER WELL

Latitude	Longitude	Section	Township	Range	E W	Fraction	1⁄4	1⁄4	1⁄4
Datum	Elevation	County							

WATER WELL OWNER

Name	
Business	
Address	
Well location	
at owner's address	
CONCERNICE	

CONSTRUCTION

Borehole interval:	Borehole diameter:
fromtoft.	in.
fromtoft.	in.
Casing height above land su	
If casing height is less th has a variance been app	roved?* Yes No
*variance not required for or environmental reme	
Casing type:	
Blank casing interval:	ft. toft.
Blank casing diameter:	in.
Casing joints:	
Weight:lbs	s/ft.
Wall thickness or gauge	no.:
Blank casing interval:	ft. toft.
Blank casing diameter:	
Casing joints:	
Weight:lbs	s/ft.
Wall thickness or gauge	
Grout interval: ft. to	oft.
Grout material:	
Grout interval: ft. to	oft.
Grout material:	
Screen / perforation material	:
Screen / perforation opening	gs:
Screen / perforation intervals	S:
Fromft. to	_ft.
Slot size unit	
Fromft. to	_ft.
Slot size unit	
Gravel pack intervals:	
Gravel pack not used:	Gravel size in
From ft. to	
Gravel pack not used:	
From ft. to	

	County				
WELL	WATER U	SE			
сомі	PLETION				
Dept	th of compl	eted w	ell:		ft.
	th(s) groun				
(1)_	ft.;	(2)	ft.;		
(3) _	ft.;	(4)	dry wel	1	
Stati	c water leve	el in we	ell:	ft.	
	neasured be on (mm/dd/		nd surfac		
	neasured at on (mm/dd/		nd surfac	e	
Estir	nated yield	:	gpm		
Wate	er level was	:	ft. aft	er	hours
			pumpin	ıg	gpm
Pum	p installed	?Ye	es No		
Wate	er well disir	nfected	? Yes	No	

Date disinfected (mm/dd/yy):

LITHOLOGIC LOG

from well:	from well:	
Source description:		
Source:		
Distance from well:	Direction from well:	
Source description:		
No potential sour within 100 feet.	ce of contamination	
PERMIT & ID NUMBE	RS (AS REQUIRED)	
DWR Application No	o.:	
	Code:	
Site Name:		
	Form Completed: Yes	No
County Permit: Ye	s No Permit ID:	
Lease Name & Well #	t:	

of boreholes: _____ # of dewatering wells: _

NEAREST SOURCE OF POTENTIAL CONTAMINATION

Direction

Aquifer, if known:


FROM	то	LITHOLOGY INTERVALS

COMMENTS

CONTRACTOR'S OR LANDOWNERS CERTIFICATION

This water well was constructed	reconstructed	pursuant to the stated water well
contractor's license and was complete	ed on	I certify that this record is true to
the best of my knowledge and belief.	This water well rec	ord was completed on
under the business name of		,
Kansas Water Well Contractor's Licer	nse No	_ under the authority of the designated
person as defined in K.A.R. 28-30-2(j) and signed and c	ertified by the electronic signature of the
designated person at its submittal:		
Send one copy to WATER WELL OWNER	and retain one for you	r records. Fee of \$5.00 for each constructed well
KANSAS DEPAR	TMENT OF HEALTH	AND ENVIRONMENT

Bureau of Water, Geology Section, 1000 SW Jackson St., Suite 420, Topeka KS 66612-1367 (785) 296-3565 | K.S.A. 82a-1212 | v2022c

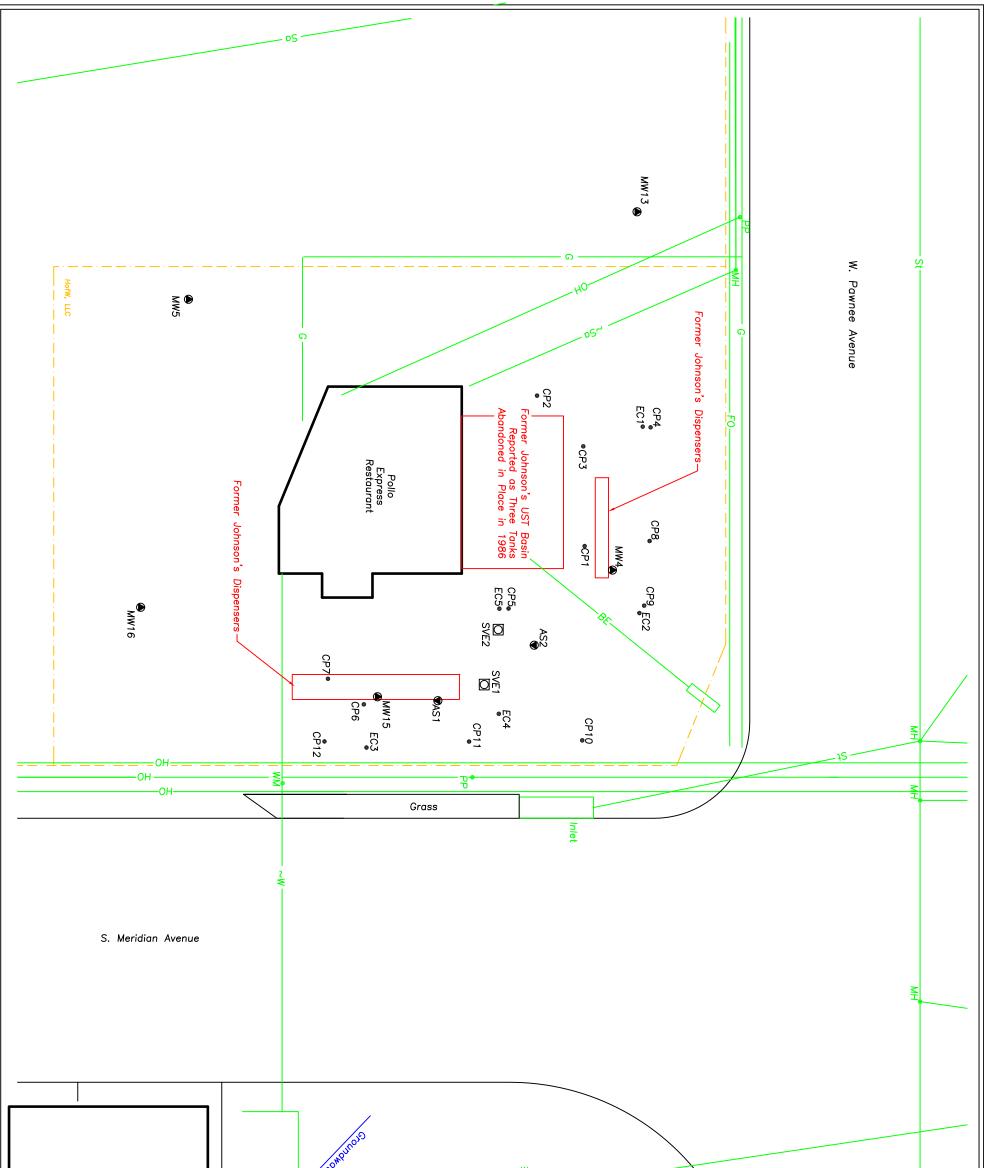

	UDI ²⁰¹⁰ Part Note:	w	
Site Detail Map Johnson's General Store #10 Wichita, Kansas KDHE Project Code: U2-087-14556 Remedial Design Report CGP Project #24988K Prepared By: MK Date: 02-19-2025 Revised By: MK Date: 02-19-2025 Figure 1.4 CGP, Inc. P0 Box 23, Wahoo, NE 68066	Note: All utilities are approximate, plotted from "811" locates and estimates of private lines (i.e. water mwg not be relied upon as exact locations. Locations should responsible for locating all utilities in vicinity of work.	Legend MW4 - Monitoring Well Location •CP1 - Continuous Probe •EC1 - Electric Conductivity Probe OSVE1 - Soil Vapor Extraction Well MAS1 - Air Sparge Well Property Line Hoff, LIC- Property Owner Name 	