KOLAR Document ID: 1817012

WATER WELL RECORD (WWC-5)

KOLAR DOC ID

Source: Distance

from well:

from well:

Site Name:

within 100 feet.

DWR Application No.:__ KDHE / EPA Project Code: _____

Lease Name & Well #:

Source description:

Source description: Source: Distance

Correction

Original Record

WELL ID Change in Well Use

NEAREST SOURCE OF POTENTIAL CONTAMINATION

No potential source of contamination

KDHE UIC Class V Form Completed: Yes No

County Permit: Yes No Permit ID:

of boreholes: _____ # of dewatering wells: _

PERMIT & ID NUMBERS (AS REQUIRED)

Direction

from well:

Direction

from well:

LOCATION OF WATER WELL

Latitude	Longitude	Section	Township	Range	E W	Fraction	1⁄4	1⁄4	1⁄4
Datum	Elevation	County							

WATER WELL OWNER

Name				
Business				
Address				
Well location				
at owner's address				

CONSTRUCTION

Borehole interval:	Borehole diameter:
fromtoft.	in.
fromtoft.	in.
Casing height above land su	
If casing height is less th has a variance been app *variance not required fo or environmental remen	roved?* Yes No or monitoring
Casing type:	
Blank casing interval:	ft. toft.
Blank casing diameter:	
Casing joints:	
Weight:lbs	s/ft.
Wall thickness or gauge	
Blank casing interval:	ft. toft.
Blank casing diameter:	
Casing joints:	
Weight:lbs	
Wall thickness or gauge	
Grout interval: ft. to	pft.
Grout material:	
Grout interval: ft. to	oft.
Grout material:	
Screen / perforation material	:
Screen / perforation opening	gs:
Screen / perforation intervals	S:
Fromft. to	_ft.
Slot size unit	
Fromft. to	_ft.
Slot size unit	
Gravel pack intervals:	
Gravel pack not used:	Gravel size in
From ft. to	ft.
Gravel pack not used:	Gravel size in
From ft. to	ft.

WELL	WATER	USE

COMPLETION						
Depth of completed well:						
Depth(s) groundwater encountere	ed:					
(1) ft.; (2) ft.;						
(3) ft.; (4) dry well						
Static water level in well: ft.						
measured below land surface on (mm/dd/yy):						
measured above land surface on (mm/dd/yy):						
Estimated yield: gpm						
Water level was: ft. afterhours						
pumping	gpm					
Pump installed? Yes No						
Water well disinfected? Yes No						

Date disinfected (mm/dd/yy):

Aquifer, if known:

LITHOLOGIC	LOG


ITHOLOGIC LOG						
FROM	то	LITHOLOGY INTERVALS				

COMMENTS

CONTRACTOR'S OR LANDOWNERS CERTIFICATION

This water well was constructed	reconstructed	pursuant to the stated water well			
contractor's license and was complet	I certify that this record is true to				
the best of my knowledge and belief.	This water well rec	ord was completed on			
under the business name of		,			
Kansas Water Well Contractor's Lice	nse No	under the authority of the designated			
person as defined in K.A.R. 28-30-2(j) and signed and certified by the electronic signature of the					
designated person at its submittal:					
Send one copy to WATER WELL OWNER	and retain one for you	r records. Fee of \$5.00 for each constructed well			
KANSAS DEPAR	TMENT OF HEALTH	AND ENVIRONMENT			

Bureau of Water, Geology Section, 1000 SW Jackson St., Suite 420, Topeka KS 66612-1367 (785) 296-3565 | K.S.A. 82a-1212 | v2022c

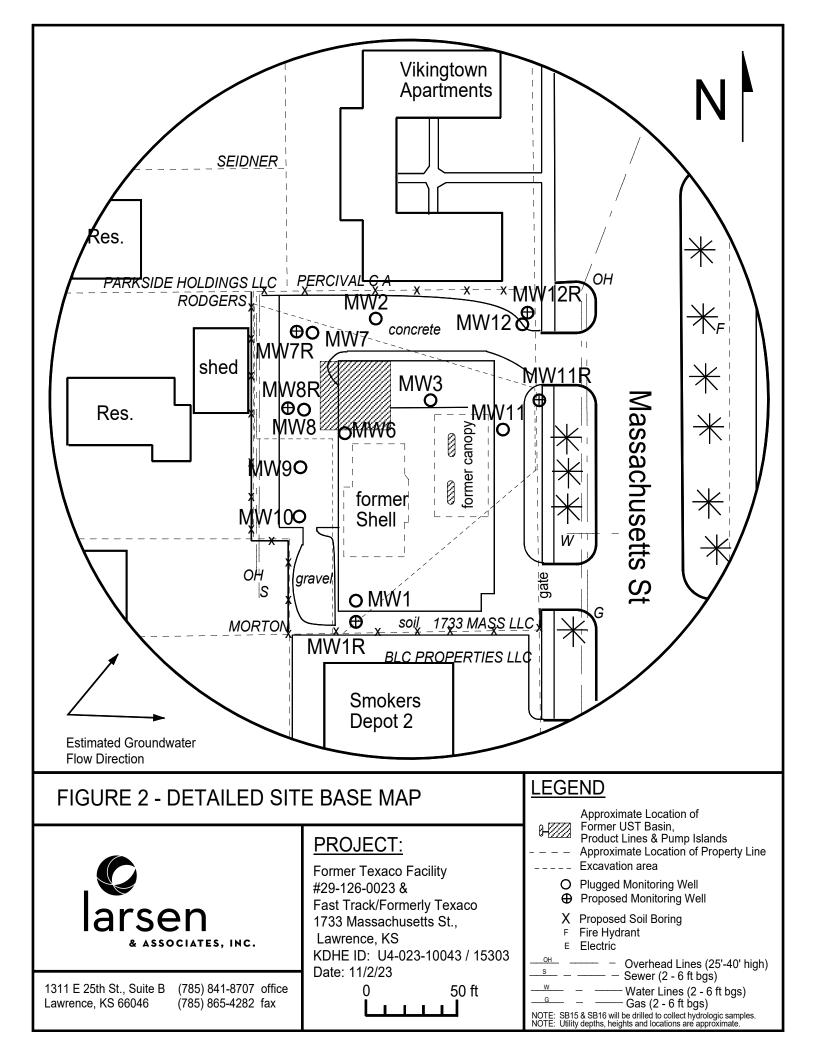

DENNIS L HANDKE

1820 NW 59th Terrace TOPEKA, KANSAS 66618 785-286-4047 Home

January 18, 2025

Jess Chapman Larsen & Associates 1311 E. 25th Street, Suite B Lawrence, Kansas, 66046

RE: Monitor Well Elevation Survey 1733 Massachusetts, Lawrence, Kansas Proj. 25-00A Former Texaco Facility U4-023-10043 / 15303

Bench Mark: Square cut on top of East end of concrete retaining wall at NE corner of property.					
Elev: 871.8		th 3461.32	West 3589.64	(from SE Cor. Sec. 6-13-20E)	
				CONSTRUCTION ADDRESS PROFESSION OF ACTA DOMESSION (STATISTICS)	
MW-1R	rim	873.04	North 3467.42	SW1/4,NW1/4,SE1/4,NW1/4	
	top pipe	872.52	West 3698.04	Lat = 38.95215 Long = 95.23647	
MW-7R	rim	873.00	North 3619.96	SW1/4,NW1/4,SE1/4,NW1/4	
	top pipe	872.71	West 3709.89	Lat = 38.95257 Long = 95.23651	
MW-8R	rim	873.01	North 3583.86	SW1/4,NW1/4,SE1/4,NW1/4	
	top pipe	872.63	West 3709.30	Lat = 38.95247 Long = 95.23651	
MW-11R	rim	871.56	North 3604.21	SE1/4,NW1/4,SE1/4,NW1/4	
	top pipe	871.00	West 3591.62	Lat $= 38.95252$ Long $= 95.23609$	
MW-12R	rim	871.33	North 3631.26	SE1/4,NW1/4,SE1/4,NW1/4	
	top pipe	870.98	West 3590.47	Lat = 38.95260 Long = 95.23609	

Lat & Long derived from Lawrence East 7.5'Quad Map NAD 29

Elevation derived from project NGS BM V 368. NAVD 1988.

If you have any questions, please feel free to call me. Thank you for the opportunity to be of sense to you.

