WATER WELL RECORD (WWC-5)

Datum Blevation County	า Well U	
Datum Elevation County	1/4	
WELL WATER USE	/1	
Source: Distance from well: Source: Distance from well		
COMPLETION Depth of completed well:	IAMINAII	
Depth of completed well:ft. Depth(s) groundwater encountered:		
Depth(s) groundwater encountered: (1)ft.; (2)ft.; (3)ft.; (4) dry well Static water level in well:ft. measured below land surface on (mm/dd/yy): measured above land surface on (mm/dd/yy): measured above land surface on (mm/dd/yy): measured above land surface on (mm/dd/yy): Estimated yield:gpm Water level was:ft. afterhours pumpinggpm DWR Application No.: KDHE / EPA Project Code:Site Name: KDHE / EPA Project Code:Site Name: KDHE / Class V Form Completed: County Permit: Yes No Permit IT Lease Name & Well #: Aquifer, if known: LITHOLOGIC LOG FROM TO LITHOLOGY INTERVALS		
Depth(s) groundwater encountered: (1)ft.; (2)ft.; (3)ft.; (4) dry well Static water level in well:ft.		
Static water level in well:ft.		
Static water level in well:ft. measured below land surface on (mm/dd/yy):		
Static water level in well:ft. measured below land surface on (mm/dd/yy): measured above land surface on (mm/dd/yy): Estimated yield:gpm Water level was:ft. afterhours pumpinggpm Pump installed? Yes No *variance not required for monitoring or environmental remediation wells Casing type:Blank casing diameter:in. Casing joints:tft. afterhours Date disinfected? Yes No Water well disinfected? Yes No Date disinfected (mm/dd/yy): Aquifer, if known: LITHOLOGIC LOG FROM TO LITHOLOGY INTERVALS		
measured below land surface on (mm/dd/yy): measured above land surface on (mm/dd/yy): Estimated yield:gpm Water level was:ft. afterhours pumpinggpm Pump installed? Yes No *variance not required for monitoring or environmental remediation wells Casing type: Blank casing diameter:in. Casing joints: Weight:lbs/ft. measured below land surface on (mm/dd/yy): measured above land surface on (mm/dd/yy): pump installed? Yes No Water well disinfected? Yes No Date disinfected (mm/dd/yy): Aquifer, if known:# of boreholes:# of dewatering LITHOLOGIC LOG FROM TO LITHOLOGY INTERVALS		
measured above land surface on (mm/dd/yy): Estimated yield:gpm Water level was:ft. afterhours pumpinggpm DWR Application No.: KDHE / EPA Project Code:Site Name: KDHE UIC Class V Form Completed: Water well disinfected (mm/dd/yy): Date disinfected (mm/dd/yy): Aquifer, if known: LITHOLOGIC LOG FROM TO LITHOLOGY INTERVALS		
Borehole interval: Borehole diameter: fromtoft.	ion	
Fromtoftin. Fromtoftin. Casing height above land surface:in. If casing height is less than 12 in. has a variance been approved?* Yes No *variance not required for monitoring or environmental remediation wells Casing type:		
from	D)	
Casing height above land surface:in. If casing height is less than 12 in. has a variance been approved?* Yes No *variance not required for monitoring or environmental remediation wells Casing type: Blank casing interval:in. Casing joints:in. Casing joints:in. Pump installed? Yes No Pump installed? Yes No Date disinfected? Yes No Date disinfected (mm/dd/yy): Aquifer, if known: LITHOLOGIC LOG FROM TO LITHOLOGY INTERVALS KDHE / EPA Project Code: Site Name: KDHE UIC Class V Form Completed: County Permit: Yes No Permit ID Lease Name & Well #: # of boreholes: # of dewatering LITHOLOGIC LOG		
If casing height is less than 12 in. has a variance been approved?* Yes No *variance not required for monitoring or environmental remediation wells Casing type: Blank casing diameter: in. Casing joints:		
has a variance been approved?* Yes No *variance not required for monitoring or environmental remediation wells Casing type: Blank casing diameter:in. Casing joints: Weight:lbs/ft. Casing libs/ft. Water well disinfected? Yes No Date disinfected (mm/dd/yy): Aquifer, if known: LITHOLOGIC LOG FROM TO LITHOLOGY INTERVALS KDHE UIC Class V Form Completed: County Permit: Yes No Permit III Lease Name & Well #: # of boreholes: # of dewatering LITHOLOGIC LOG		
*variance not required for monitoring or environmental remediation wells Casing type:		
or environmental remediation wells Casing type: Blank casing diameter: Casing joints: Weight: Date disinfected (mm/dd/yy): Lease Name & Well #: # of boreholes: # of dewatering Lithologic Log FROM TO LITHOLOGY INTERVALS		
Casing type: Blank casing interval: ft. to ft. Casing joints: Weight: lbs/ft. Aquifer, if known: Aquifer, if known: LITHOLOGIC LOG FROM TO LITHOLOGY INTERVALS # of boreholes: # of dewatering # of boreholes: # of dewatering		
Blank casing diameter:in. LITHOLOGIC LOG Casing joints:lbs/ft. FROM TO LITHOLOGY INTERVALS		
Casing joints: FROM TO LITHOLOGY INTERVALS Weight: lbs/ft.		
Weight:lbs/ft.		
Wall thickness or gauge no.: Blank casing interval: ft. to ft.		
Blank casing diameter: in.		
Casing joints:		
Weight: lbs/ft.		
Wall thickness or gauge no.:		
Grout interval:ft. toft.		
Grout material: ft. to ft.		
Grout material: Grout material: COMMENTS		
Grout material:		
Screen / perforation material:		
Screen / perforation openings: CONTRACTOR'S OR LANDOWNERS CERTIFICATION		
Screen / perforation intervals: This water well was constructed reconstructed pursuant to the stated water	r well	
Fromft. toft. contractor's license and was completed on I certify that this record is		
Classical and the control of the con		
From the to the first of my knowledge and benefit. This water well record was completed on		
Slot circa unit under the business name of		
Gravel pack intervals: Kansas Water Well Contractor's License No under the authority of the do	_	
Gravel pack not used: Gravel size in person as defined in K.A.R. 28-30-2(j) and signed and certified by the electronic signal	ture of th	
From ft. to ft. designated person at its submittal:		
Gravel pack not used: Gravel size in Send one copy to WATER WELL OWNER and retain one for your records. Fee of \$5.00 for each con	structed v	
Fromft. toft. KANSAS DEPARTMENT OF HEALTH AND ENVIRONMENT Bureau of Water, Geology Section, 1000 SW Jackson St., Suite 420, Topeka KS 66612-13	67	

KANSAS DEPARTMENT OF HEALTH AND ENVIRONMENT Bureau of Water, Geology Section, 1000 SW Jackson St., Suite 420, Topeka KS 66612-1367 (785) 296-3565 | K.S.A. 82a-1212 | v2022c

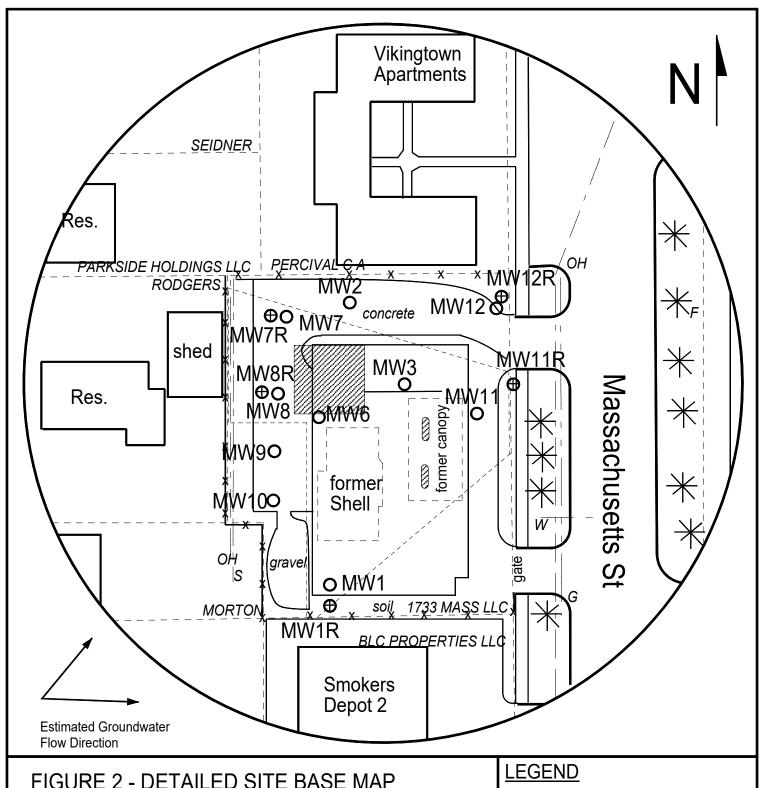


FIGURE 2 - DETAILED SITE BASE MAP



1311 E 25th St., Suite B (785) 841-8707 office Lawrence, KS 66046 (785) 865-4282 fax

PROJECT:

Former Texaco Facility #29-126-0023 & Fast Track/Formerly Texaco 1733 Massachusetts St., Lawrence, KS KDHE ID: U4-023-10043 / 15303

Date: 11/2/23

0 50 ft

Approximate Location of Former UST Basin,

Product Lines & Pump Islands Approximate Location of Property Line

Excavation area

O Plugged Monitoring Well

Proposed Monitoring Well

X Proposed Soil Boring

Fire Hydrant

E Electric

Overhead Lines (25'-40' high) Sewer (2 - 6 ft bgs)

Water Lines (2 - 6 ft bgs) Gas (2 - 6 ft bgs)

NOTE: SB15 & SB16 will be drilled to collect hydrologic samples. NOTE: Utility depths, heights and locations are approximate.

DENNIS L HANDKE

1820 NW 59th Terrace TOPEKA, KANSAS 66618 785-286-4047 Home

Jess Chapman Larsen & Associates 1311 E. 25th Street, Suite B Lawrence, Kansas, 66046

Elev: 871.83

January 18, 2025

RE: Monitor Well Elevation Survey 1733 Massachusetts, Lawrence, Kansas Proj. 25-00A Former Texaco Facility U4-023-10043 / 15303

Bench Mark: Square cut on top of East end of concrete retaining wall at NE corner of property. (from SE Cor. Sec. 6-13-20E) North 3461.32 West 3589.64

rim top pipe	873.04 872.52	North 3467.42 West 3698.04	SW1/4,NW1/4,SE1 Lat = 38.95215	
rim top pipe	873.00 872.71	North 3619.96 West 3709.89	SW1/4,NW1/4,SE1 Lat = 38.95257	f .
rim	873.01	North 3583.86	SW1/4,NW1/4,SE1	/4,NW1/4
top pipe	872.63	West 3709.30	Lat = 38.95247	Long = 95.23651
rim	871.56	North 3604.21	SE1/4,NW1/4,SE1/	/4,NW1/4
top pipe	871.00	West 3591.62	Lat = 38.95252	Long = 95.23609
rim	871.33	North 3631.26	SE1/4,NW1/4,SE1/	/4,NW1/4
top pipe	870.98	West 3590.47	Lat = 38.95260	Long = 95.23609

Lat & Long derived from Lawrence East 7.5'Quad Map NAD 29

Elevation derived from project NGS BM V 368. NAVD 1988.

If you have, any questions, please feel free to call me. Thank you for the opportunity to be