KOLAR Document ID: 1835769

WATER WELL RECORD (WWC-5)

KOLAR DOC ID

Original Record

Correction

WELL ID_____ Change in Well Use

LOCATION OF WATER WELL

Latitude	Longitude	Section	Township	Range	E W	Fraction	1⁄4	1⁄4	1⁄4
Datum	Elevation	County							

WATER WELL OWNER

Name				
Business				
Address				
Well location				
at owner's address				

CONSTRUCTION

Borehole interval:	Borehole diameter:			
fromtoft.	in.			
fromtoft.	in.			
Casing height above land su				
If casing height is less th has a variance been app *variance not required fo	roved?* Yes No			
or environmental reme	U U			
Casing type:				
Blank casing interval:	ft. toft.			
Blank casing diameter:	in.			
Casing joints:				
Weight:lbs	s/ft.			
Wall thickness or gauge	no.:			
Blank casing interval:	ft. toft.			
Blank casing diameter:	in.			
Casing joints:				
Weight:lbs	s/ft.			
Wall thickness or gauge	no.:			
Grout interval: ft. to	oft.			
Grout material:				
Grout interval: ft. to	oft.			
Grout material:				
Screen / perforation material	:			
Screen / perforation opening	gs:			
Screen / perforation interval	s:			
Fromft. to	_ft.			
Slot size unit				
Fromft. to	_ft.			
Slot size unit				
Gravel pack intervals:				
Gravel pack not used:	Gravel size in			
From ft. to	ft.			
Gravel pack not used:				
From ft. to				

	County								
WELL	WELL WATER USE								
сомі	PLETION								
Dept	th of comp	leted w	rell:		ft.				
Dept	th(s) groui	ndwate	r encounter	ed:					
(1)_	ft.;	(2) _	ft.;						
(3)_	ft.;	(4)	dry well						
Stati	Static water level in well: ft.								
	measured below land surface on (mm/dd/yy):								
	measured above land surface on (mm/dd/yy):								
Estir	nated yield	l:	gpm						
Wate	er level wa	s:	ft. after		hours				
			pumping		gpm				
Pum	p installed	l? Y	es No						
Wate	er well disi	nfected	? Yes	No					

NEAREST SOURCE C	OF POTENTIAL CONTAMINATION
Source:	
Distance from well:	Direction from well:
Source description:	
Source:	
Distance from well:	Direction from well:
Source description:	
No potential so within 100 feet.	urce of contamination
PERMIT & ID NUME	BERS (AS REQUIRED)
DWR Application	No.:
KDHE / EPA Proje	ct Code:
Site Name:	
	/ Form Completed: Yes No

County Permit: Yes No Permit ID: _

of boreholes: _____ # of dewatering wells: _

Lease Name & Well #:

Aquifer, if known:

Date disinfected (mm/dd/yy):

LITHOLOGIC LOG


то	LITHOLOGY INTERVALS
	то

COMMENTS

CONTRACTOR'S OR LANDOWNERS CERTIFICATION

This water well was constructed	reconstructed	pursuant to the stated water well		
contractor's license and was complete	I certify that this record is true to			
the best of my knowledge and belief.	This water well rec	ord was completed on		
under the business name of		,		
Kansas Water Well Contractor's Lice	nse No	_ under the authority of the designated		
person as defined in K.A.R. 28-30-2(j) and signed and c	ertified by the electronic signature of the		
designated person at its submittal:				
Send one copy to WATER WELL OWNER	and retain one for you	r records. Fee of \$5.00 for each constructed well.		
KANSAS DEPAR	TMENT OF HEALTH	AND ENVIRONMENT		

Bureau of Water, Geology Section, 1000 SW Jackson St., Suite 420, Topeka KS 66612-1367 (785) 296-3565 | K.S.A. 82a-1212 | v2022c

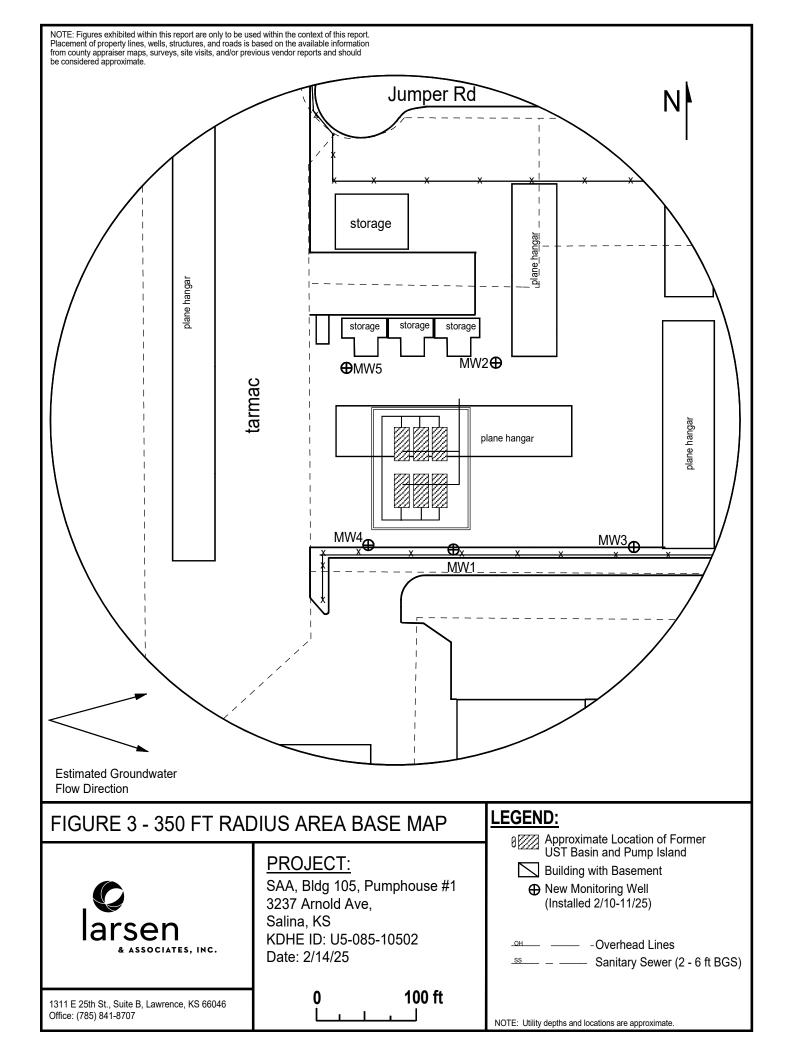

DENNIS L HANDKE 1820 NW 59th Terrace TOPEKA, KANSAS 66618 785-286-4047 Home

March 20, 2025

Jess Chapman Larsen & Associates 1311 E. 25th Street, Suite B Lawrence, Kansas, 66046

RE: Monitor Well Elevation Survey 3237 Arnold Ave., Salina, Kansas

Proj. 25-00F SAA, Bldg 105, Pumphouse #1 U5-085-10502

Bench Mark: Chisled X on NW top bolt of fire hydrant 77 feet Southwest of MW#4.

Elev: 1	265.58	North 4102	2.76	West 2882	.26	(from SE Cor. Sec. 3-15-3W
MW-1	rim	1262.45	North	4155.73	SE1/4,SE1/4,N	E1/4,NW1/4
	top pipe	1262.23	West	2748.08	Lat= 38.78045	Long = 97.64117
MW-2	rim	1262.13	North	4315.25	NE1/4,SE1/4,N	E1/4,NW1/4
	top pipe	1261.75	West	2690.76	Lat= 38.78089	Long = 97.64097
MW-3	rim	1262.45	North	4141.59	SW1/4,SW1/4,I	NW1/4,NE1/4
	top pipe	1262.15	West	2549.74	Lat=38.78044	Long = 97.64047
MW-4	rim	1262.93	North	4156.70	SE1/4,SE1/4,SF	E1/4,NW1/4
	top pipe	1262.61	West	2 8 27.24	Lat= 38.78045	Long = 97.64145
MW-5	rim	1261.69	North	4322.44	NE1/4,SE1/4,N	E1/4,NW1/4
	top pipe	1261.35	West	2854.05	Lat= 38.78091	Long = 97.64154

Lat & Long derived from Saline SW 7.5' quad map. WGS 84.

Elevation established from NGS PACS SLN B . NAVD 88.

If you have any, guestions, please feel free to call me. Thank you for the opportunity to be

ofservice tover AND SUK