
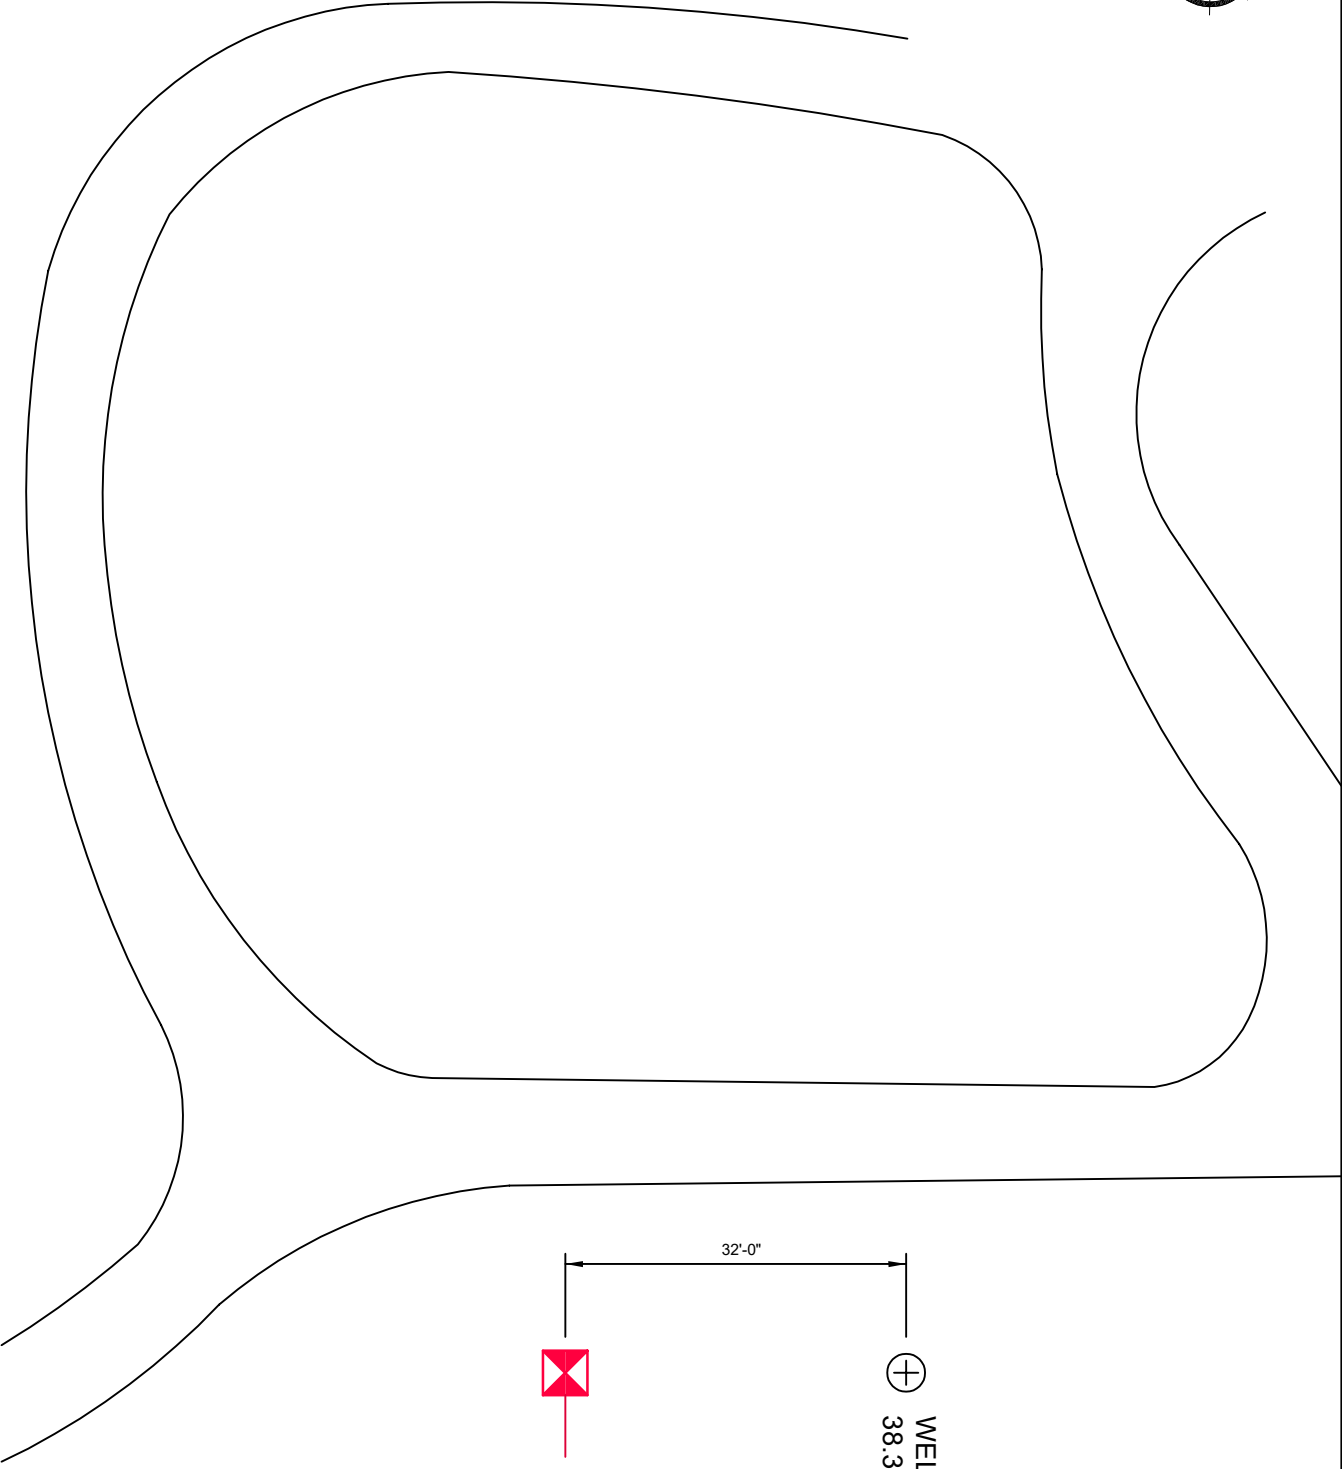


Form	ACO1 - Well Completion
Operator	ONEOK NGL Pipeline, LLC
Well Name	CT-2 REPLACEMENT RUMLER 1
Doc ID	1862279

Casing

Purpose Of String	Size Hole Drilled	Size Casing Set	Weight	Setting Depth	Type Of Cement	Number of Sacks Used	Type and Percent Additives
Surface	16	10.75	8	60	Portland	40	

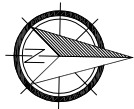

⊕ WELL GPS
38.37159, -97.80113

⊗ RECTIFIER GPS
38.37169, -97.80112

PROJECT LOCATION PLAN

1

A INSERT

ONEOK

SAFETY ALERT: THIS DOCUMENT DOES NOT REFLECT ACTUAL SITE OR SUBSURFACE CONDITIONS AND SHALL NOT BE RELIED UPON FOR THE LOCATION OF ANY UTILITIES, CURRENTS, HAZARDS OR OTHER CONDITIONS WHERE THE WORK IS TO BE PERFORMED, UNDERGROUND STRUCTURES AND UTILITIES MAY BE PRESENT WHICH ARE NOT DOCUMENTED OR LOCATED. THIS DOCUMENT IS FURTHER SUBJECT TO ALL SAFETY NOTES SET FORTH HEREIN.

NOTICE: THIS DOCUMENT IS PRELIMINARY. PREPARED FOR A LIMITED PURPOSE IN RELANCE UPON INFORMATION PROVIDED BY OTHERS, AND INTENDED FOR SPECIFIC APPLICATION UNDER CERTAIN CONDITIONS. THIS DOCUMENT, AND ANY DESIGNS OR DETAILS, ARE THE PROPERTY OF INFRAPRO SERVICES AND SHALL NOT BE COPIED, REPRODUCED, TRANSMITTED, MODIFIED, RELIED UPON OR USED FOR ANY PURPOSE WITHOUT THE PRIOR EXPRESS WRITTEN PERMISSION OF INFRAPRO. INFRAPRO DOES NOT WARRANT THE ACCURACY OF INFORMATION DEPICTED AND ASSUMES NO LIABILITY FOR ANY UNAUTHORIZED COPY, REPRODUCTION, TRANSMITTAL, MODIFICATION, RELANCE OR USE HEREOF. ANY USE REQUIRES AN INDEPENDENT DETERMINATION BY A QUALIFIED DESIGN PROFESSIONAL OF THE ACCURACY AND SUITABILITY OF ANY DATA, DESIGN, DETAIL, OR INFORMATION TO THE APPLICATION AND CONDITIONS. FAILURE TO COMPLY MAY RESULT IN PROPERTY DAMAGE OR PERSONAL INJURY FOR WHICH INFRAPRO SHALL HAVE NO LIABILITY. ELECTRONIC TRANSMISSION MAY RESULT IN ERRORS FOR WHICH INFRAPRO ASSUMES NO LIABILITY.

0	9.19.2025	AS-BUILT
REV.	DATE	REVISION DESCRIPTION

CLIENT	TITLE	DRAFT DATE (YYYY.MM.DD)	DRAWN BY	C.BROWN
ONEOK	CATHODIC PROTECTION SYSTEM DEEP ANODE GROUNDBED INSTALLATION CT-2 REPLACEMENT RUMLER MCPHERSON, KANSAS	DESIGNED BY E.MANZO	CHECKED BY P.KING	
		APPROVED BY P.KING	CLIENT DRAWING NO.	24185-66
		PROJECT NO. 24185-66	SCALE NTS	REV. 24185-66
		DRAWING NO. 24185-66	SHEET NO. 1 OF 1	0



JOB NO: 24185
 CUSTOMER: ONEOK
 CUSTOMER REP: John Cooper/Frank Caudillo
 GPS COORD: 38.37159 -97.80113
 ADDRESS: CT-2 Replacement Rumler
 FOREMAN: Charlie Shaw
 DRILLER: Ernesto Manzo
 ELEVATION:

DATE: 8.27.2025
 DIA. HOLE: 10"
 DEPTH: 300'
 COKE TYPE: SC-3
 # OF COKE: 150 Bags
 # OF BENTONITE: 93 Bags
 COLUMN LENGTH: 180'
 INACTIVE LENGTH: 120'
 PRE/POST COKE:

CASING: SCH-40
 DIAMETER: 10" SDR21
 CASING DEPTH: 60'
 # OF ANODES: 15
 ANODE TYPE: Cast Iron
 ANODE LEAD: #8 AWG/HALAR
 CALIBRATION METER MODEL:
 CALIBRATION METER DATE:

RECTIFIER MFG:
 MODEL:
 SERIAL #:
 V-DC:
 A-DC:
 PRIM-V:
 PHASE:
 COMMISSIONING VOLTS:
 COMMISSIONING AMPS:

DEPTH FT.	DRILLER'S LOG	ANODE NO.	ELECTRIC LOG				DEPTH FT.	DRILLER'S LOG	ANODE NO.	ELECTRIC LOG			
			VOLTS	AMPS	RESIS.	REMARKS				VOLTS	AMPS	RESIS.	REMARKS
0	Brown Clay						250	Red Bed		10.6			
5		CASING & CENTRALIZER					255		A-5				
10							260			9.7			
15							265		A-4				
20	Red Clay						270			10.9			
25							275		A-3				
30		CASING & CENTRALIZER					280			11.2			
35							285		A-2				
40	Red Clay						290			11.6			
45	Red Bed						295		A-1	11.6			
50							300	Red Bed					
55		CASING & CENTRALIZER					305						
60		CASING					310						
65							315						
70				3.5			320						
75							325						
80	Red Bed			3.2			330						
85							335						
90				2.9			340						
95							345						
100				3.1			350						
105							355						
110				3.6			360						
115	Red Bed						365						
120				4.0			370						
125							375						
130				4.3			380						
135							385						
140				5.0			390						
145							395						
150				4.4			400						
155		A15					405						
160				4.5			410						
165	Red Bed	A-14					415						
170				7.0			420						
175		A-13					425						
180				7.3			430						
185		A-12					435						
190	Red Bed			6.7			440						
195		A-11					445						
200				5.3			450						
205		A-10					455						
210	Red Bed			5.9			460						
215		A-9					465						
220				4.5			470						
225		A-8					475						
230				6.9			480						
235		A-7					485						
240				9.5			490						
245	Red Bed	A-6					495						

B & B LUMBER

Wichita
522-1822

Newton
283-0700

B & B Lumber
1601 W 1st St.
Newton KS 67114
(316) - 283-0700

8/25/2025 2:33 PM

BRCH:2000

CASHIER: 2500

*** INVOICE ***
2508-604822

ACCT # : CASH
JOB # : 0
NAME : CASH SALES

PC1 CEMENT- PORTLAND CEMENT TYPE

1 94# 35/plt

80 EA @ 22.24 EA 1,779.20

QP CEMENT MIX- PALLETS

2 EA @ 25.00 EA 50.00

SUBTOTAL 1,829.20

SALES TAX HAYCO 8.50% 155.48

TOTAL 1,984.68

AMT PAID 1,984.68

CHANGE DUE 0.00

Thank you for your business!

PAYMENT METHOD[S]:

SALE-Visa 1984.68

ACCT:###6580 APPROVED:054096

AL: VISA CREDIT

Entry Mode: CHIP

AID: A00000000031010