## **WATER WELL RECORD** (WWC-5)


From \_\_\_\_\_ ft. to \_\_\_\_\_ ft.

<b>WATER WELL REC</b>	ORD (W	WC-5)				KOLAR D	OOC ID		WELL ID_				
OCATION OF WATER WEL	L					Original Reco	rd Cor	rection	Chang	je in We	ll Use		
Latitude	Longitude			Section	Township	Range	E W	Fraction	1/4	1/4	1/4		
Datum	Elevation			County				·					
VATER WELL OWNER			WELL	WATER US	E		NEAREST S	OURCE OF F	OTENTIAL (	ONTAMIN	NATIO		
Name							Source:						
Business			COMP	LETION			Distance		Directio	ın			
			Denth	of comple	ted well:	ft.	from well:		_ from we	ell:			
Address			-	-	water encountered:		Source description	n:					
			-	-	(2) ft.;								
Well location					(4) dry well					n .			
			-		in well:		from well:		Direction from we	ell:			
at owner's address			m		ow land surface		Source description	n:					
ONSTRUCTION  Borehole interval:	Borehole dia	meter·	m	•	ove land surface			ential sourc 100 feet.	e of contam	ination			
fromto ft.					Estimated yield:gpm				PERMIT & ID NUMBERS (AS REQUIRED)				
fromto ft.					gpm ft. after	h	DWR Apr	dication No	:				
			water		nt. after pumping		1		 Code:				
Casing height above land su		in.	Pumr		Yes No	gpiii	I						
If casing height is less th has a variance been appropriate the control of the co		. No	- ump	instanca.	103 100		I		orm Comple		No		
*variance not required for	Water well disinfected? Yes No				County Permit: Yes No Permit ID:								
or environmental reme	Date disinfected (mm/dd/yy):				Lease Name & Well #:								
Casing type:			Aquif	er, if knowr	· ·		I		# of dewate				
Blank casing interval:		ft.											
Blank casing diameter:				LOGIC LOG		NTERVALE							
Casing joints:			FROI	м то	LITHOLOGY II	NIERVALS							
Wall thickness or gauge													
Blank casing interval:													
Blank casing diameter:													
Casing joints:													
· —	s/ft.												
Wall thickness or gauge													
		_											
Grout material													
Grout interval													
Grout meterial			COMM	IENTS									
Grout material:													
Screen / perforation material													
Screen / perforation opening			CONTI	RACTOR'S	OR LANDOWNERS	CERTIFICATION							
Screen / perforation intervals					was constructed			urcuant to	the stated v	vater well	1		
Fromft. to							•						
Slot size unit					ense and was com	_		-					
From ft. to				-	knowledge and be			_					
Slot size unit					ness name of								
Gravel pack intervals:			Kans	as Water V	Well Contractor's	License No	ur	nder the aut	thority of th	ne designa	ated		
Gravel pack not used:	Gravel size	in	perso	n as defin	ed in K.A.R. 28-3	0-2(j) and signe	d and certifi	ed by the e	lectronic si	gnature o	of the		
From ft. to		111	desig	nated pers	son at its submitta	al:							
Gravel pack not used:		.	Send o	ne copy to V	WATER WELL OW	VER and retain one	e for vour reco	ords. Fee of \$	5.00 for each	constructe	ed wel		

KANSAS DEPARTMENT OF HEALTH AND ENVIRONMENT

Bureau of Water, Geology Section, 1000 SW Jackson St., Suite 420, Topeka KS 66612-1367

(785) 296-3565 | K.S.A. 82a-1212 | v2022c

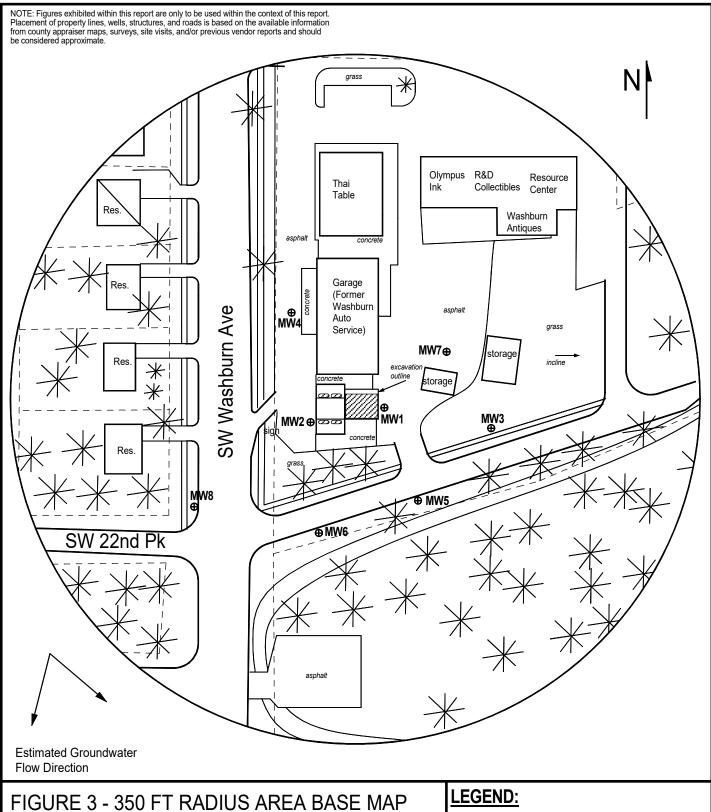



1311 E 25th St., Suite B, Lawrence, KS 66046 Office: (785) 841-8707

## PROJECT:

Washburn Auto Service 2236 SW Washburn Topeka, KS KDHE ID: U4-089-15524 Date: 8/12/25

0 100 ft

- Approximate Location of Former UST Basin and Pump Island
  - Building with Basement

    New Monitoring Well

    (Installed 6/30-7/1/25
  - X Proposed Soil Boring

○H -Overhead Lines

ss \_\_\_ \_ \_ Sanitary Sewer (2 - 6 ft BGS)

NOTE: Utility depths and locations are approximate.

## **DENNIS L HANDKE**

## 1820 NW 59th Terrace TOPEKA, KANSAS 66618 785-286-4047 Home

Jess Chapman Larsen & Associates 1311 E. 25<sup>th</sup> Street, Suite B Lawrence, Kansas 66046 July 19, 2025

RE: Monitor Well Elevation Survey 2236 SW Washburn Ave., Topeka, Kansas Proj. 25-00DD Washburn Auto Service KDHE ID U4-089-15524

Bench Mark: Chisled Sq. on NW corner of concrete slab on the South edge of parking lot South of the punp islands.

Elev: 908.	84 Noi	rth 4557.22	Wes	st 2505.28	(from SE Cor. Sec. 12-12-15E)
MW-1	rim	909.05	North	4600.32	NW1/4,SW1/4,NW1/4,NE1/4
	top pipe	908.74	West	2458.43	Lat = 39.02773 Long = 95.69635
MW-2	rim	909.26	North	4582.37	NW1/4,SW1/4,NW1/4,NE1/4
	top pipe	908.98	West	2525.80	Lat = 39.02768 Long = 95.69659
MW-3	rim	905.85	North	4563.57	NW1/4,SW1/4,NW1/4,NE1/4
	top pipe	905.35	West	2370.83	Lat = 39.02763 Long = 95.69604
MW-4	rim	910.64	North	4694.38	SW1/4,NW1/4,NW1/4,NE1/4
	top pipe	910.28	West	2551.45	Lat = 39.02799 Long = 95.69668
MW-5	rim	905.71	North	4499.29	NW1/4,SW1/4,NW1/4,NE1/4
	top pipe	905.46	West	2432.71	Lat = 39.02746 Long = 95.69626
MW-6	rim	906.21	North	4477.95	NW1/4,SW1/4,NW1/4,NE1/4
	top pipe	905.86	West	2508.95	Lat = 39.02740 Long = 95.69652
MW-7	rim	909.03	North	4644.81	NW1/4,SW1/4,NW1/4,NE1/4
	top pipe	908.79	West	2400.60	Lat = 39.02786 Long = 95.69615
MW-8	rim	906.96	North	4406.39	NE1/4,SE1/4,NE1/4,NW1/4
	top pipe	906.64	West	2645.62	Lat = 39.02747 Long = 95.69702

Elevation derived from City of Topeka Bench Mark #20.1 NAVD 88

Lat & Long derived from Topeka 7.5 Quad Map WGS84

If you have trans, guestions, please feel free to call me. Thank you for the opportunity to be

Donnik L Handke Ring

LS-786

TANSAS

ORIGINAL

TANSAS

TANS