

WATER WELL RECORD (WWC-5)

KOLAR DOC ID _____ WELL ID _____

Original Record Correction Change in Well Use

LOCATION OF WATER WELL

Latitude		Longitude		Section		Township		Range		E W	Fraction	¼	¼	¼
Datum		Elevation		County										

WATER WELL OWNER

Name	
Business	
Address	
Well location at owner's address	

WELL WATER USE

--

COMPLETION

Depth of completed well: _____ ft.
Depth(s) groundwater encountered:
(1) _____ ft.; (2) _____ ft.;
(3) _____ ft.; (4) dry well
Static water level in well: _____ ft.
measured below land surface
on (mm/dd/yy): _____
measured above land surface
on (mm/dd/yy): _____
Estimated yield: _____ gpm
Water level was: _____ ft. after _____ hours
pumping _____ gpm
Pump installed? Yes No
Water well disinfected? Yes No
Date disinfected (mm/dd/yy): _____
Aquifer, if known:

NEAREST SOURCE OF POTENTIAL CONTAMINATION

Source: _____
Distance from well: _____ Direction from well: _____
Source description: _____
Source: _____
Distance from well: _____ Direction from well: _____
Source description: _____
No potential source of contamination within 100 feet.

CONSTRUCTION

Borehole interval:	Borehole diameter:
from _____ to _____ ft.	_____ in.
from _____ to _____ ft.	_____ in.
Casing height above land surface: _____ in.	
If casing height is less than 12 in. has a variance been approved?*	Yes No
*variance not required for monitoring or environmental remediation wells	
Casing type: _____	
Blank casing interval: _____ ft. to _____ ft.	
Blank casing diameter: _____ in.	
Casing joints: _____	
Weight: _____ lbs/ft.	
Wall thickness or gauge no.: _____	
Blank casing interval: _____ ft. to _____ ft.	
Blank casing diameter: _____ in.	
Casing joints: _____	
Weight: _____ lbs/ft.	
Wall thickness or gauge no.: _____	
Grout interval: _____ ft. to _____ ft.	
Grout material: _____	
Grout interval: _____ ft. to _____ ft.	
Grout material: _____	
Screen / perforation material: _____	
Screen / perforation openings: _____	
Screen / perforation intervals:	
From _____ ft. to _____ ft.	
Slot size _____ unit _____	
From _____ ft. to _____ ft.	
Slot size _____ unit _____	
Gravel pack intervals:	
Gravel pack not used: Gravel size _____ in	
From _____ ft. to _____ ft.	
Gravel pack not used: Gravel size _____ in	
From _____ ft. to _____ ft.	

PERMIT & ID NUMBERS (AS REQUIRED)

DWR Application No.: _____
KDHE / EPA Project Code: _____
Site Name: _____
KDHE UIC Class V Form Completed: Yes No
County Permit: Yes No Permit ID: _____
Lease Name & Well #: _____
of boreholes: _____ # of dewatering wells: _____

LITHOLOGIC LOG

FROM	TO	LITHOLOGY INTERVALS

COMMENTS

--

CONTRACTOR'S OR LANDOWNERS CERTIFICATION

This water well was constructed reconstructed pursuant to the stated water well contractor's license and was completed on _____. I certify that this record is true to the best of my knowledge and belief. This water well record was completed on _____ under the business name of _____, Kansas Water Well Contractor's License No. _____ under the authority of the designated person as defined in K.A.R. 28-30-2(j) and signed and certified by the electronic signature of the designated person at its submittal: _____.

Send one copy to WATER WELL OWNER and retain one for your records. Fee of \$5.00 for each constructed well.

DENNIS L HANDKE

1820 NW 59th Terrace
TOPEKA, KANSAS 66618
785-286-4047 Home

Jess Chapman
Larsen & Associates
1311 E. 25th Street, Suite B
Lawrence, Kansas, 66046

July 3, 2025

RE: Monitor Well Elevation Survey
7155 SE Hwy 66, Riverton, Kansas

Proj. 25-00W
Van's Garage & Service Station
U3-011-15266

Bench Mark: Square cut on North center of concrete light base on East side of entrance to property.
Elev: 834.87 North 78 West 4519 (from SE Cor. Sec. 17-34-25E)

MW-9	rim	833.89	North 211	SW1/4,SE1/4,SW1/4,SW1/4
	top pipe	833.62	West 4364	Lat = 37.07542 Long = 94.70122
MW-10	rim	829.12	South 105	NW1/4,NE1/4,NW1/4,NW1/4 (Sec. 20-34-25E)
	top pipe	828.77	West 4414	Lat = 37.07455 Long = 94.70140
MW-11	rim	829.80	South 103	NW1/4,NE1/4,NW1/4,NW1/4 (Sec. 20-34-25E)
	top pipe	829.57	West 4513	Lat = 37.07456 Long = 94.70174
MW-12	rim	831.13	South 100	NW1/4,NE1/4,NW1/4,NW1/4 (Sec. 20-34-25E)
	top pipe	830.77	West 4615	Lat = 37.07457 Long = 94.70209


Lat & Long derived from Baxter Springs 7.5'Quad Map NAD 29

Elevation derived from existing project. NAVD 1988.

If you have any questions, please feel free to call me. Thank you for the opportunity to be of service to you.

Dennis L. Handke, R.S.

LS-786

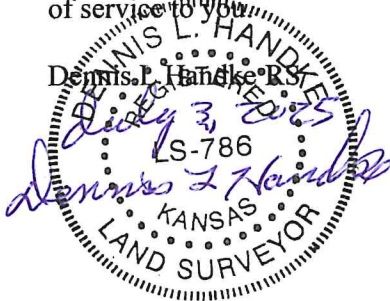

NOTE: Figures exhibited within this report are only to be used within the context of this report. Placement of property lines, wells, structures, and roads is based on the available information from county appraiser maps, surveys, site visits, and/or previous vendor reports and should be considered approximate.

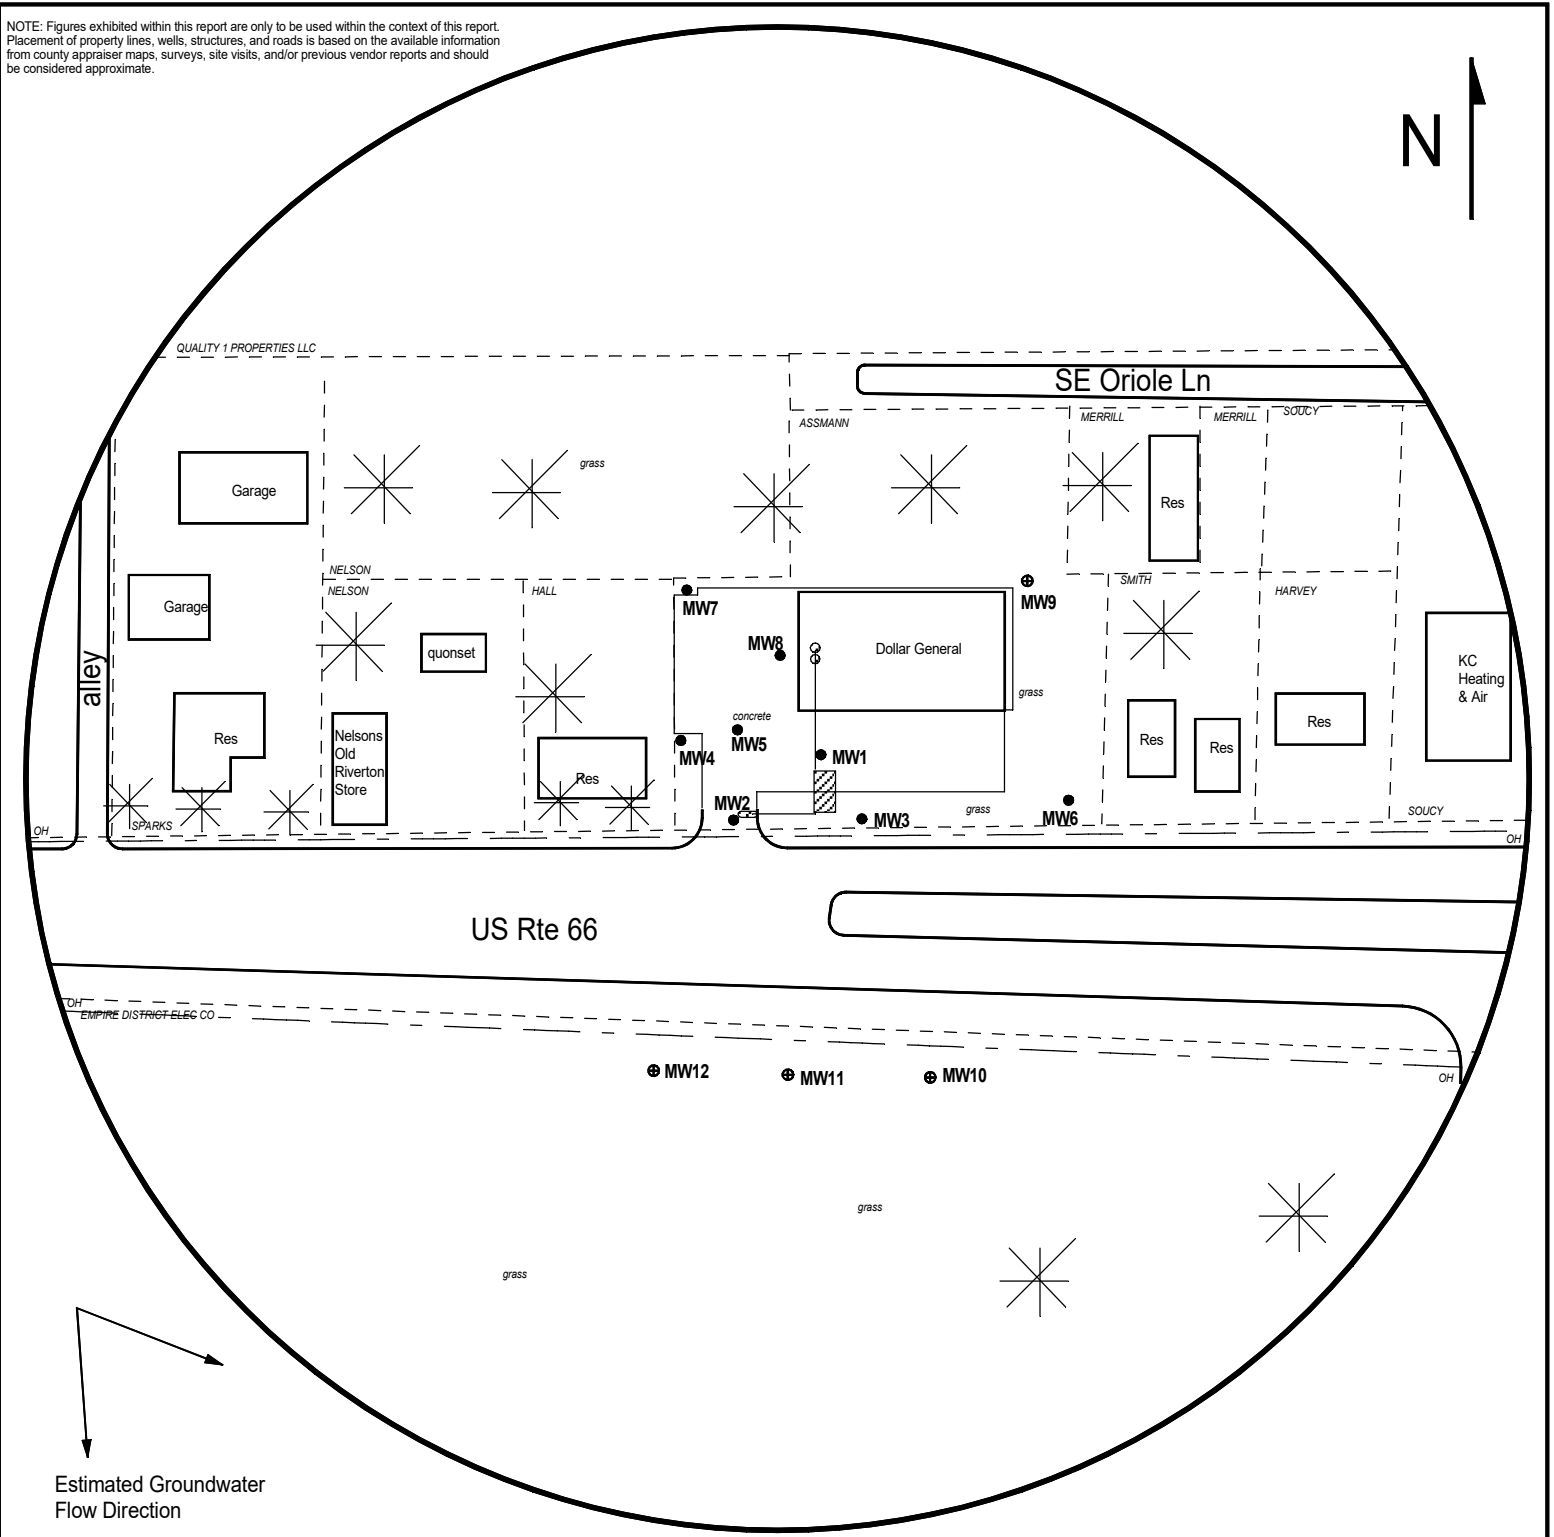


FIGURE 2 - 500 FT RADIUS AREA BASE MAP



PROJECT:

Van's Garage & Service Station
7155 SE Hwy 66
Riverton, KS
KDHE ID: U3-011-15266
Date: 3/17/25

1311 E 25th St., Suite B, Lawrence, KS 66046
Office: (785) 841-8707

0 100 feet

LEGEND:

- Approximate Location of Former UST Basin and Pump Island
- Building with Basement
- Existing Monitoring Well
- Proposed Monitoring Well
- Proposed Soil Boring
- Tree/Bush

OH ——— Overhead Lines (25-40 ft high)
SS ——— Sanitary Sewer (2 - 6 ft BGS)

NOTE: Utility depths, heights and locations are approximate.