Gravel pack not used: Gravel size in

From ft. to ft.

WATER WELL RECORD (WWC-5) **KOLAR DOCID** WELL ID **Original Record** Correction Change in Well Use LOCATION OF WATER WELL E W Fraction $\frac{1}{4}$ Latitude Longitude Section Township Range Datum Elevation County WATER WELL OWNER **WELL WATER USE NEAREST SOURCE OF POTENTIAL CONTAMINATION** Source: Name Direction Distance Business COMPLETION from well: from well: Depth of completed well: ft. Source Address description: Depth(s) groundwater encountered: ft.; (2) Source: Well location dry well Distance Direction from well: from well: Static water level in well: ft. at owner's Source address measured below land surface description: on (mm/dd/yy): No potential source of contamination CONSTRUCTION measured above land surface within 100 feet. on (mm/dd/yy): Borehole interval: Borehole diameter: PERMIT & ID NUMBERS (AS REQUIRED) to from in. gpm Estimated yield: DWR Application No.:_ ft. from to in. Water level was: _ ft. after hours KDHE / EPA Project Code: pumping _ gpm Casing height above land surface: in. Site Name: Pump installed? No If casing height is less than 12 in. has a variance been approved?* KDHE UIC Class V Form Completed: Yes No Yes No Water well disinfected? Yes No *variance not required for monitoring County Permit: Yes No Permit ID: or environmental remediation wells Date disinfected (mm/dd/yy): Lease Name & Well #: Casing type: # of boreholes: ____ # of dewatering wells: _ Aquifer, if known: Blank casing interval: ft. to Blank casing diameter: in. LITHOLOGIC LOG Casing joints:_ FROM LITHOLOGY INTERVALS __lbs/ft. Weight: Wall thickness or gauge no.: ___ Blank casing interval: ft. to Blank casing diameter: in. Casing joints: Weight: lbs/ft. Wall thickness or gauge no.: ft. to Grout interval: Grout material: ft. to ft. Grout interval: COMMENTS Grout material: Screen / perforation material: Screen / perforation openings: CONTRACTOR'S OR LANDOWNERS CERTIFICATION Screen / perforation intervals: This water well was constructed reconstructed pursuant to the stated water well ft. to ft. contractor's license and was completed on ____ _. I certify that this record is true to Slot size ____ unit __ the best of my knowledge and belief. This water well record was completed on From ft. to ft. under the business name of _ Slot size unit Kansas Water Well Contractor's License No. under the authority of the designated Gravel pack intervals: person as defined in K.A.R. 28-30-2(j) and signed and certified by the electronic signature of the Gravel pack not used: Gravel size _____in designated person at its submittal: From ft. to ft.

Send one copy to WATER WELL OWNER and retain one for your records. Fee of \$5.00 for each constructed well.

KANSAS DEPARTMENT OF HEALTH AND ENVIRONMENT

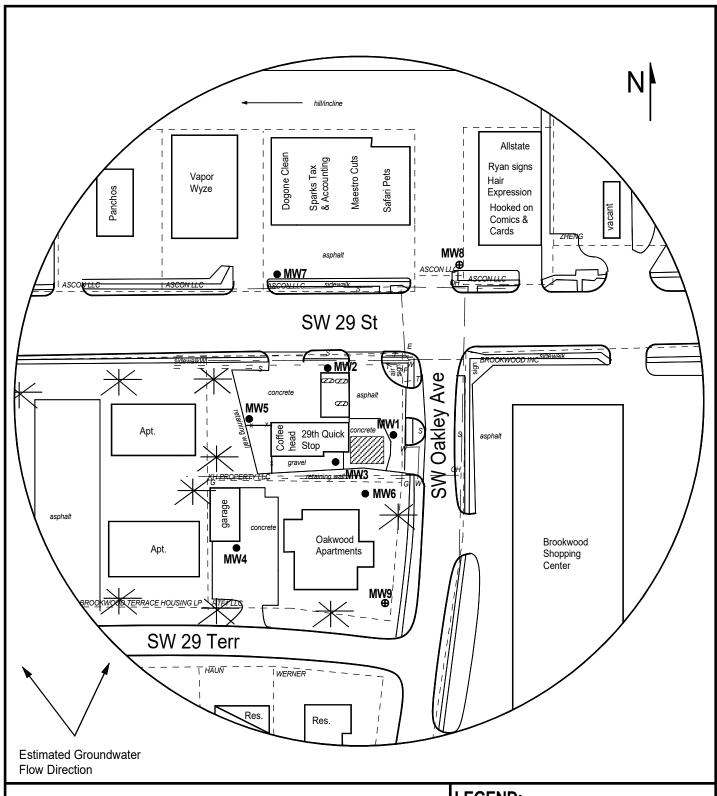


FIGURE 3 - 350 FT RADIUS AREA BASE MAP



1311 E 25th St., Suite B, Lawrence, KS 66046 Office: (785) 841-8707

PROJECT:

29th Quick Stop 3101 SW 29th St, Topeka, KS KDHE ID: U4-089-15627 Date: 8/14/25

0 100 ft

LEGEND:

Approximate Location of Active UST Basin and Pump Island

- Building with Basement
 - Existing Monitoring Well
 - → New Monitoring Well (Installed 8/14/25)

X Proposed Soil Boring

OH - Overhead Lines

ss ___ _ Sanitary Sewer (2 - 6 ft BGS)

NOTE: Utility depths and locations are approximate.

DENNIS L HANDKE

1820 NW 59th Terrace TOPEKA, KANSAS 66618 785-286-4047 Home

Jess Chapman Larsen & Associates 1311 E. 25th Street, Suite B Lawrence, Kansas 66046 August 23, 2025

RE: Monitor Well Elevation Survey 3101 SW 29th St., Topeka, Kansas

Proj. 25-00JJ 29TH Quick Stop KDHE ID U4-089-15627

Bench Mark: Chisled X on top NW bolt of old concrete sign base near the NE Corner of property. Elev: 905.04 North 5205.00 West 2813.37 (from SE Cor. Sec. 5-10-19E)

MW-8	rim top pipe	901.55 901.20		SE1/4,SE1/4,SE1/4,SW1/4 (Sec.32-9-19E) Lat = 39.01514 Long = 95.71604
MW-9	rim top pipe	911.77 911.43	4974.95 2818.73	NE1/4,NE1/4,NE1/4,NW1/4 Lat = 39.01425 Long = 95.71625

Elevation derived from existing project. NAVD 88

Lat & Long derived from Topeka 7.5 Quad Map WGS84

If you have any questions, please feel free to call me. Thank you for the opportunity to be of service to white ".....

SE Handke RUS

ALIAND SURVEY