

County: Sedgwick Fraction: SE NE SE Sec. 9 T 27 S R 2 E

CORRECTION(S) TO WATER WELL COMPLETION RECORD (WWC-5) - to rectify lacking or incorrect information

Owner: Beech Aircraft

SAL-5

If corrected, location was listed as:

Location changed to:

Section-Township-Range: 21-27-2E

9-27-2E

Fraction (1/4 1/4 1/4): NE NE SE

SE NE SE

Other changes: Initial statements: 1000' S of 21st St, Greenwich
50' W

Changed to: well is 3600' S of 21st St, Greenwich
and 50' W

Comments: _____

Verification method: Geologist on site, Core taken for this
well with location description

Initials: QLS Date: 5/14/2019

Submitted by: Kansas Geological Survey, Data Resources Library, 1930 Constant Avenue, Lawrence, KS 66047-3724
 Kansas Dept. of Health & Environment, Bureau of Water, 1000 SW Jackson, Suite 420, Topeka, KS 66612-1367

1 LOCATION OF WATER WELL: Fraction NE 1/4 NE 1/4 SE 1/4 Section Number 21 Township Number T 27 S Range Number R 2 EW
 County: Sedgwick
 Distance and direction from nearest town or city street address of well if located within city?

50' W and 1000' S at 21st & Greenwich, in Wichita SAL-5

2 WATER WELL OWNER: Beech Aircraft Company Board of Agriculture, Division of Water Resources
 RR#, St. Address, Box #: 9709 E. Central
 City, State, ZIP Code: Wichita, KS 67202 Application Number:

3 LOCATE WELL'S LOCATION WITH AN "X" IN SECTION BOX: 4 DEPTH OF COMPLETED WELL: 101 ft. ELEVATION: GS. 1368.71

N

NW	NE
SW	SE

S

Depth(s) Groundwater Encountered 1 ft. 2. ft. 3. ft.

WELL'S STATIC WATER LEVEL 91 ft. below land surface measured on mo/day/yr

Pump test data: Well water was ft. after hours pumping gpm

Est. Yield gpm: Well water was ft. after hours pumping gpm

Bore Hole Diameter in. to ft., and in. to ft.

WELL WATER TO BE USED AS:

5 Public water supply	8 Air conditioning	11 Injection well
1 Domestic	3 Feedlot	6 Oil field water supply
2 Irrigation	4 Industrial	7 Lawn and garden only
		<input checked="" type="checkbox"/> 10 Monitoring well

Was a chemical/bacteriological sample submitted to Department? Yes No ; If yes, mo/day/yr sample was submitted

Water Well Disinfected? Yes No

5 TYPE OF BLANK CASING USED:

1 Steel	3 RMP (SR)	5 Wrought iron	8 Concrete tile	CASING JOINTS: Glued Clamped
<input checked="" type="checkbox"/> PVC	4 ABS	6 Asbestos-Cement	9 Other (specify below)	Welded
		7 Fiberglass		Threaded <input checked="" type="checkbox"/>

Blank casing diameter 2 in. to ft., Dia in. to ft., Dia in. to ft.

Casing height above land surface N/A in., weight lbs./ft. Wall thickness or gauge No. Sch 40

TYPE OF SCREEN OR PERFORATION MATERIAL:

1 Steel	3 Stainless steel	5 Fiberglass	8 RMP (SR)	10 Asbestos-cement
2 Brass	4 Galvanized steel	6 Concrete tile	9 ABS	11 Other (specify)
				12 None used (open hole)

SCREEN OR PERFORATION OPENINGS ARE:

1 Continuous slot	<input checked="" type="checkbox"/> Mill slot	5 Gauzed wrapped	8 Saw cut	11 None (open hole)
2 Louvered shutter	4 Key punched	6 Wire wrapped	9 Drilled holes	
		7 Torch cut	10 Other (specify)	

SCREEN-PERFORATED INTERVALS: From 101' ft. to 91' ft., From ft. to ft.

GRAVEL PACK INTERVALS: From 101' ft. to 89' ft., From ft. to ft.

6 GROUT MATERIAL: 1 Neat cement 2 Cement grout Bentonite 4 Other

Grout Intervals: From 89' ft. to 0 ft., From ft. to ft.

What is the nearest source of possible contamination:

1 Septic tank	4 Lateral lines	7 Pit privy	10 Livestock pens	14 Abandoned water well
2 Sewer lines	5 Cess pool	8 Sewage lagoon	11 Fuel storage	15 Oil well/Gas well
3 Watertight sewer lines	6 Seepage pit	9 Feedyard	12 Fertilizer storage	<input checked="" type="checkbox"/> Other (specify below)
			13 Insecticide storage	<u>Salvage Materials</u>


Direction from well? W How many feet? ~500'

FROM	TO	LITHOLOGIC LOG	FROM	TO	PLUGGING INTERVALS
0	23'	Silty Clay			
23'	101'	Silty Shale and Gypsum Wellington Formation			

7 CONTRACTOR'S OR LANDOWNER'S CERTIFICATION: This water well was constructed, (2) reconstructed, or (3) plugged under my jurisdiction and was completed on (mo/day/year) . . . March 23, 1994 and this record is true to the best of my knowledge and belief. Kansas Water Well Contractor's License No. . . . 517 This Water Well Record was completed on (mo/day/yr) 4/15/94 under the business name of Groundwater Technology, Inc. by (signature) Albert Stout

OFFICE USE ONLY
T
R
EW
SEC.
1/4
1/4
1/4

00034

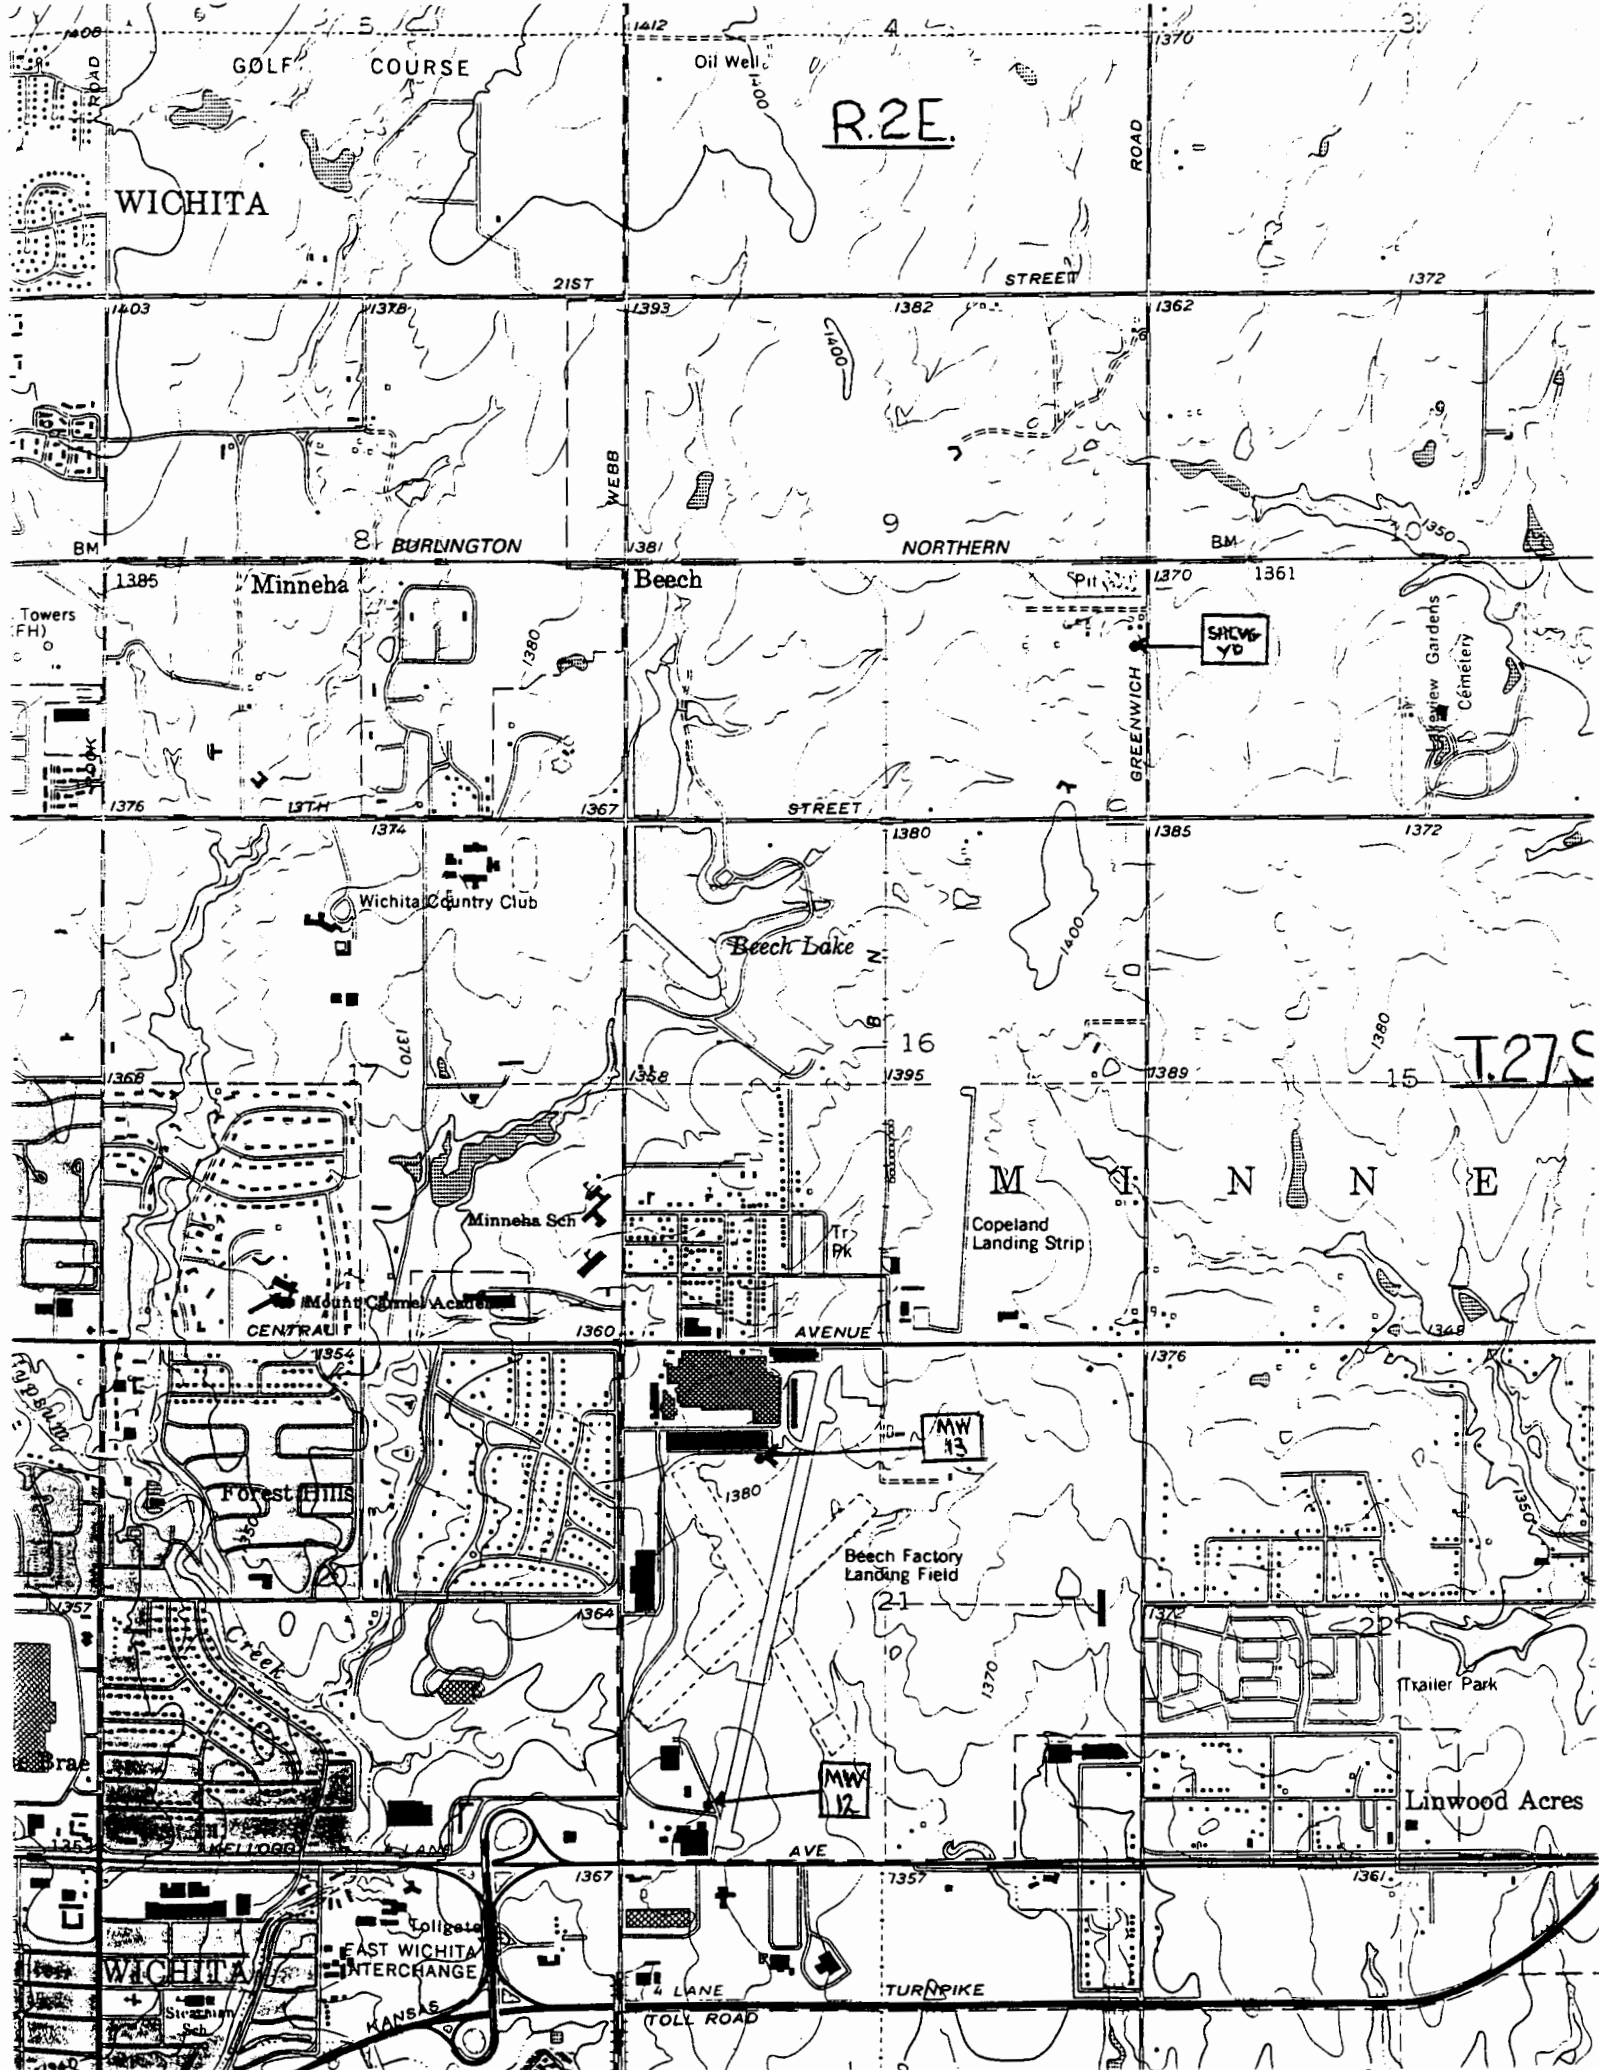

R.2E.

WICHITA

GOLF COURSE

Oil Well

21ST

STREET

1372

BURLINGTON

NORTHERN

Minneha

Beech

SHCV6
YD

Wichita Gardens
Cemetery

Wichita Country Club

Beech Lake

T.27S

Minneha Sch

Mount Carmel Academy

Copeland
Landing Strip

Forest Hills

Beech Factory
Landing Field

Trailer Park

Linwood Acres

EAST WICHITA
INTERCHANGE

4 LANE

TURNPIKE

WICHITA

KANSAS

TOLL ROAD