


Graham

KANSAS

SECTION 2 TOWNSHIP 10S RANGE 22W

WELL NO. #2 Callison

COMPANY K & E Drlg.

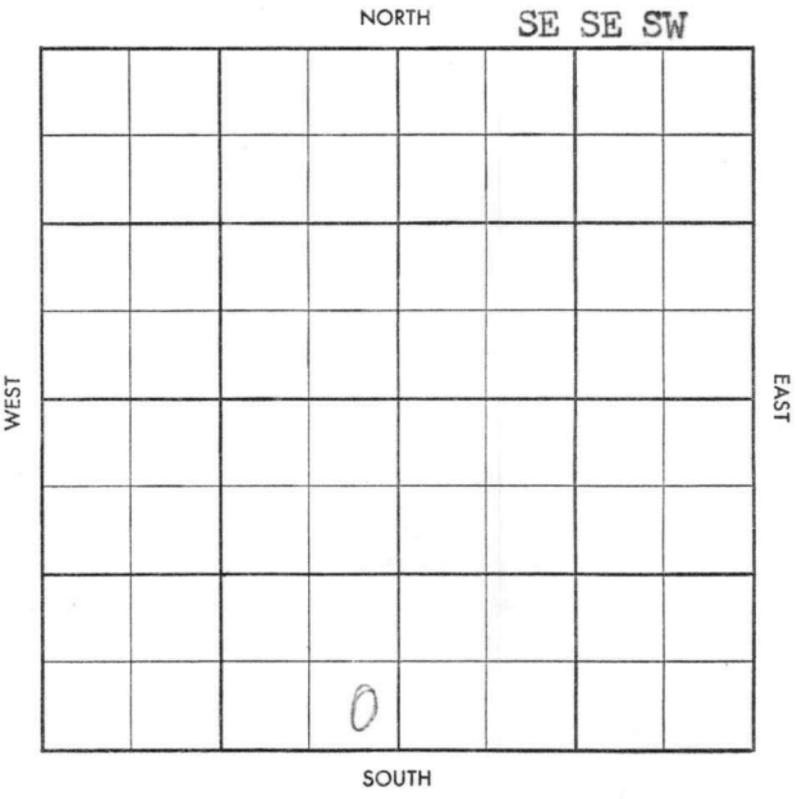

18

WILDCAT

~~Red Line~~

S-513-B

County Graham Elev. 2331DF
 Sec. 2 Twp. 10 Rge. 22W
 Company K & E Drlg.
 Farm Name Callison No. 2

TOPS	DEPTH	LOG	DATUM
Anh.	1815		
Tp.			
H.	3547		
Tr.	3568		
Dg.			
B.L.			
L.	3583		
K.C.			
B.K.C.			
Ce.			
C.			
M.			
M.			
K.			
Mz.			
Mq.			
V.			
S.			
S.			
A.			
R.			
Pf.			
G.			
T.D.			

Loc. in Sec. X
SE SE SW

Geol. _____
 Contr. _____
 Co. Tools #2

Pool _____
Wildcat

FIRST REPORT

JAN 22 '58

6

Date Comm. 1/16/58
8" @ 237 w/150, tops. Drlg. 3624.

Co.

Lse.

No.

Sec.

T.

R.

Redline

County Graham Elev. 2331DF 233+AA
 Sec. 2 Twp. 10 Rge. 22W
 Company K & E Drlg.
 Farm Name Callison No. 2

TOPS	DEPTH	LOG	DATUM	Loc. in Sec.
Anh.	1815			SE SE SW
Tp.				
H.	3547			
Tr.	3568			
Dg.				
B.L.				
L.	3583			
K.C.				Geol.
B.K.C.				Contr.
Ce.				Co. Tools #2
C.				Pool <u>Brassfield</u>
M.				<u>Wildcat</u> ^{50' Disc}
M.				
K.				
Mz.				
Mq.				
V.				
S.				
S.				
A.				COMPLETE
R.				
Pf.				FEB 26 '58
G.				
T.D.	3850			

Date Comm. 1/16/58
 8" @ 237 w/150, tops. Drlg. 3624. JAN 20 '58
 DST 3754-79 60" 190' gip 20'
 OCM 40' HOCM 30' V HOCM
 + tr Proc oil BHP 1060/20"
 4" 3849/100 MICT FEB 5 '58 CO
 20/ 3764-69 510goph NW
 net 3) rec'd & over 4 1/2 BOPH
 NW 4 hrs T&R FEB 12 '58 pop wop
 FEB 19 '58 FEB 26 '58 Phy P 9130 pd NW
 39" Lsg 3764-69