For KCC Use:

Effective Date:

District #

SGA? Yes No

Kansas Corporation Commission Oil & Gas Conservation Division

NOTICE OF INTENT TO DRILL

Must be approved by KCC five (5) days prior to commencing well

Form C-1
December 2002
Form must be Typed
Form must be Signed
All blanks must be Filled

Expected Spud Date October 22, 2007	
month day year	Spot East Sec. 16 Twp. 14 S. R. 29 V West
34015	1320 feet from V N / S Line of Section
OPERATOR: License# 34015 V Name: Zenith Petroleum Corporation	2631 feet from E / V W Line of Section
Address: 5766 S. Ivy Street,	Is SECTION RegularIrregular?
City/State/Zip: Greenwood Village, CO 80111	(Note: Locate well on the Section Plat on reverse side)
Contact Person: Jack Johnston	County: Gove
Phone: Office (303) 779-1900 Cell: (303) 601-1001	Lease Name: Coberly Partnership Well #: 16-2
	Field Name: Coberly West Field
CONTRACTOR: License# 33575	Is this a Prorated / Spaced Field? Yes ✓ No
Name: WW Drilling	Target Formation(s): Mississippian
Well Drilled For: Well Class: Type Equipment:	Nearest Lease or unit boundary:
✓ Mud Hotary	Ground Surface Elevation: 2670.4 feet MSL
Gas Storage Pool Ext. Air Rotary	Water well within one-quarter mile:
OWWO Disposal Wildcat Cable	Public water supply well within one mile:
Seismic: # of Holes Other	Depth to bottom of fresh water:
Other	Depth to bottom of usable water: 1100'
	Surface Pipe by Alternate: 1 2 2 2 200'
If OWWO: old well information as follows:	Length of Surface Pipe Planned to be set: 200'— Length of Conductor Pipe required: None
Operator:	Projected Total Depth: 4500'
Well Name:	Formation at Total Depth: Mississippian Miss
Original Completion Date:Original Total Depth:	Water Source for Drilling Operations:
Directional, Deviated or Horizontal wellbore?	Well ✓ Farm Pond Other
If Yes, true vertical depth:	DWR Permit #:
Bottom Hole Location: Vertical	(Note: Apply for Permit with DWR)
KCC DKT #:	Will Cores be taken?
	If Yes, proposed zone: KANSAS CORPORATION COMMISSIO
AFF	DAVIT
	00= 0 0 00=
The undersigned hereby affirms that the drilling, completion and eventual pl	00= 0 0 00=
The undersigned hereby affirms that the drilling, completion and eventual plat is agreed that the following minimum requirements will be met:	ugging of this well will comply with K.S.A. 55 et. seq. OCT 0 9 2007 CONSERVATION DIVISION
The undersigned hereby affirms that the drilling, completion and eventual pl	ugging of this well will comply with K.S.A. 55 et. seq. OCT 0 9 2007 CONSERVATION DIVISION WICHITA RS
The undersigned hereby affirms that the drilling, completion and eventual plant is agreed that the following minimum requirements will be met: 1. Notify the appropriate district office <i>prior</i> to spudding of well; 2. A copy of the approved notice of intent to drill <i>shall be</i> posted on each 3. The minimum amount of surface pipe as specified below <i>shall be set</i>	ugging of this well will comply with K.S.A. 55 et. seq. OCT 0 9 2007 CONSERVATION DIVISION WICHITA, KS It by circulating cement to the top; in all cases surface pipe shall be set
The undersigned hereby affirms that the drilling, completion and eventual plant is agreed that the following minimum requirements will be met: 1. Notify the appropriate district office <i>prior</i> to spudding of well; 2. A copy of the approved notice of intent to drill <i>shall be</i> posted on each 3. The minimum amount of surface pipe as specified below <i>shall be se</i> through all unconsolidated materials plus a minimum of 20 feet into the	CONSERVATION DIVISION WICHITA, KS It by circulating cement to the top; in all cases surface pipe shall be set ne underlying formation.
The undersigned hereby affirms that the drilling, completion and eventual plant is agreed that the following minimum requirements will be met: 1. Notify the appropriate district office <i>prior</i> to spudding of well; 2. A copy of the approved notice of intent to drill <i>shall be</i> posted on each and the drill shall be posted on each through all unconsolidated materials plus a minimum of 20 feet into the drill the well is dry hole, an agreement between the operator and the drilling that the drilli	conservation division with drilling rig; the drilling rig; the underlying formation. istrict office on plug length and placement is necessary prior to plugging;
The undersigned hereby affirms that the drilling, completion and eventual plit is agreed that the following minimum requirements will be met: 1. Notify the appropriate district office <i>prior</i> to spudding of well; 2. A copy of the approved notice of intent to drill <i>shall be</i> posted on each and the composition of the provided below <i>shall be set</i> through all unconsolidated materials plus a minimum of 20 feet into the composition of the compositi	CONSERVATION DIVISION WICHITA, KS with by circulating cement to the top; in all cases surface pipe shall be set ne underlying formation. istrict office on plug length and placement is necessary prior to plugging; ged or production casing is cemented in; ed from below any usable water to surface within 120 days of spud date.
The undersigned hereby affirms that the drilling, completion and eventual plit is agreed that the following minimum requirements will be met: 1. Notify the appropriate district office <i>prior</i> to spudding of well; 2. A copy of the approved notice of intent to drill <i>shall be</i> posted on each and the approved and the set of through all unconsolidated materials plus a minimum of 20 feet into the set of the well is dry hole, an agreement between the operator and the defence of the appropriate district office will be notified before well is either plug for an ALTERNATE II COMPLETION, production pipe shall be cement or pursuant to Appendix "B" - Eastern Kansas surface casing order	CONSERVATION DIVISION WICHITA, KS the underlying formation. is th
The undersigned hereby affirms that the drilling, completion and eventual plit is agreed that the following minimum requirements will be met: 1. Notify the appropriate district office <i>prior</i> to spudding of well; 2. A copy of the approved notice of intent to drill <i>shall be</i> posted on each and the minimum amount of surface pipe as specified below <i>shall be set</i> through all unconsolidated materials plus a minimum of 20 feet into the set of the well is dry hole, an agreement between the operator and the decrease. 5. The appropriate district office will be notified before well is either pluging the set of the	CONSERVATION DIVISION WICHITA, KS with by circulating cement to the top; in all cases surface pipe shall be set the underlying formation. istrict office on plug length and placement is necessary prior to plugging; ged or production casing is cemented in; ed from below any usable water to surface within 120 days of spud date. #133,891-C, which applies to the KCC District 3 area, alternate II cementing the plugged. In all cases, NOTIFY district office prior to any cementing.
The undersigned hereby affirms that the drilling, completion and eventual plit is agreed that the following minimum requirements will be met: 1. Notify the appropriate district office <i>prior</i> to spudding of well; 2. A copy of the approved notice of intent to drill <i>shall be</i> posted on each and the approved and the set of through all unconsolidated materials plus a minimum of 20 feet into the set of the well is dry hole, an agreement between the operator and the defence of the appropriate district office will be notified before well is either plug for an ALTERNATE II COMPLETION, production pipe shall be cement or pursuant to Appendix "B" - Eastern Kansas surface casing order	CONSERVATION DIVISION WICHITA, KS with by circulating cement to the top; in all cases surface pipe shall be set the underlying formation. istrict office on plug length and placement is necessary prior to plugging; ged or production casing is cemented in; ed from below any usable water to surface within 120 days of spud date. #133,891-C, which applies to the KCC District 3 area, alternate II cementing the plugged. In all cases, NOTIFY district office prior to any cementing.
The undersigned hereby affirms that the drilling, completion and eventual plit is agreed that the following minimum requirements will be met: 1. Notify the appropriate district office <i>prior</i> to spudding of well; 2. A copy of the approved notice of intent to drill <i>shall be</i> posted on each and the drill shall be posted on each and the drill shall be posted on each and the drill shall unconsolidated materials plus a minimum of 20 feet into the state of the well is dry hole, an agreement between the operator and the drill shall be defined before well is either plug that the statements will be notified before well is either plug that the Appendix "B" - Eastern Kansas surface casing order must be completed within 30 days of the spud date or the well shall the hereby certify that the statements made herein are true and to the best of the spud date.	CONSERVATION DIVISION WICHITA, KS with by circulating cement to the top; in all cases surface pipe shall be set the underlying formation. istrict office on plug length and placement is necessary prior to plugging; ged or production casing is cemented in; ed from below any usable water to surface within 120 days of spud date. #133,891-C, which applies to the KCC District 3 area, alternate II cementing the plugged. In all cases, NOTIFY district office prior to any cementing.
The undersigned hereby affirms that the drilling, completion and eventual plit is agreed that the following minimum requirements will be met: 1. Notify the appropriate district office <i>prior</i> to spudding of well; 2. A copy of the approved notice of intent to drill <i>shall be</i> posted on each and the minimum amount of surface pipe as specified below <i>shall be set</i> through all unconsolidated materials plus a minimum of 20 feet into the set of the well is dry hole, an agreement between the operator and the decrease. 5. The appropriate district office will be notified before well is either pluging the set of the	CONSERVATION DIVISION WICHITA, KS the underlying formation. is the underlying cement to the top; in all cases surface pipe shall be set the underlying formation. istrict office on plug length and placement is necessary prior to plugging; ged or production casing is cemented in; ed from below any usable water to surface within 120 days of spud date. #133,891-C, which applies to the KCC District 3 area, alternate II cementing the plugged. In all cases, NOTIFY district office prior to any cementing. Emy knowledge and belief.
The undersigned hereby affirms that the drilling, completion and eventual plant is agreed that the following minimum requirements will be met: 1. Notify the appropriate district office <i>prior</i> to spudding of well; 2. A copy of the approved notice of intent to drill <i>shall be</i> posted on each and the second of the approved notice of intent to drill <i>shall be</i> posted on each and the second of	CONSERVATION DIVISION WICHITA, KS the by circulating cement to the top; in all cases surface pipe shall be set the underlying formation. istrict office on plug length and placement is necessary prior to plugging; ged or production casing is cemented in; ed from below any usable water to surface within 120 days of spud date. #133,891-C, which applies to the KCC District 3 area, alternate II cementing the plugged. In all cases, NOTIFY district office prior to any cementing. Title: Remember to:
The undersigned hereby affirms that the drilling, completion and eventual plants agreed that the following minimum requirements will be met: 1. Notify the appropriate district office <i>prior</i> to spudding of well; 2. A copy of the approved notice of intent to drill <i>shall be</i> posted on each and the drill shall be posted on each and the drill shall be set through all unconsolidated materials plus a minimum of 20 feet into the drill shall be drilled to the drilled the dri	CONSERVATION DIVISION WICHITA, KS the diffusion of the underlying formation. Strict office on plug length and placement is necessary prior to plugging; ged or production casing is cemented in; ged from below any usable water to surface within 120 days of spud date. #133,891-C, which applies to the KCC District 3 area, alternate II cementing the plugged. In all cases, NOTIFY district office prior to any cementing. Emy knowledge and belief. Title: Remember to: File Drill Pit Application (form CDP-1) with Intent to Drill;
The undersigned hereby affirms that the drilling, completion and eventual plants agreed that the following minimum requirements will be met: 1. Notify the appropriate district office <i>prior</i> to spudding of well; 2. A copy of the approved notice of intent to drill <i>shall be</i> posted on each and the drill shall be posted on each and the drill shall be seen through all unconsolidated materials plus a minimum of 20 feet into the drill shall shall be seen through all unconsolidated materials plus a minimum of 20 feet into the drill shall shall be seen through all unconsolidated materials plus a minimum of 20 feet into the drill shall shall be seen through all unconsolidated materials plus a minimum of 20 feet into the drill shall be seen through all unconsolidated materials plus a minimum of 20 feet into the drill shall be seen through all the well is drill be seen through all the well is either plug 6. If an ALTERNATE II COMPLETION, production pipe shall be cement or pursuant to Appendix "B" - Eastern Kansas surface casing order must be completed within 30 days of the spud date or the well shall be completed within 30 days of the spud date or the well shall be completed. I hereby certify that the statements made herein are true and to the best of the drill shall be completed. Signature of Operator or Agent: Signature of Operator or Agent:	CONSERVATION DIVISION WICHITA, KS the by circulating cement to the top; in all cases surface pipe shall be set the underlying formation. istrict office on plug length and placement is necessary prior to plugging; ged or production casing is cemented in; ed from below any usable water to surface within 120 days of spud date. #133,891-C, which applies to the KCC District 3 area, alternate II cementing the plugged. In all cases, NOTIFY district office prior to any cementing. Title: Remember to:
The undersigned hereby affirms that the drilling, completion and eventual plants agreed that the following minimum requirements will be met: 1. Notify the appropriate district office <i>prior</i> to spudding of well; 2. A copy of the approved notice of intent to drill <i>shall be</i> posted on each and the drill shall be posted on each and the drill shall be posted on each and the drill shall be seen through all unconsolidated materials plus a minimum of 20 feet into the drill shall be seen through all unconsolidated materials plus a minimum of 20 feet into the drill shall be seen through all unconsolidated materials plus a minimum of 20 feet into the drill shall be drill shall be completed in the drill shall be completed within 30 days of the spud date or the well shall be completed within 30 days of the spud date or the well shall be certify that the statements made herein are true and to the best of the drill shall be consolidated. Signature of Operator or Agent: For KCC Use ONLY API # 15 - OU3 - ZIUST - UCUST - CONDUCTOR Signature of Operator or Agent:	CONSERVATION DIVISION WICHITA, KS the diffusion of the underlying cement to the top; in all cases surface pipe shall be set the underlying formation. istrict office on plug length and placement is necessary prior to plugging; ged or production casing is cemented in; ed from below any usable water to surface within 120 days of spud date. #133,891-C, which applies to the KCC District 3 area, alternate II cementing the plugged. In all cases, NOTIFY district office prior to any cementing. Emy knowledge and belief. Title: Remember to: File Drill Pit Application (form CDP-1) with Intent to Drill; File Completion Form ACO-1 within 120 days of spud date;
The undersigned hereby affirms that the drilling, completion and eventual plants agreed that the following minimum requirements will be met: 1. Notify the appropriate district office <i>prior</i> to spudding of well; 2. A copy of the approved notice of intent to drill <i>shall be</i> posted on each and the drill shall be posted on each and the drill shall be posted on each and the drill shall be set through all unconsolidated materials plus a minimum of 20 feet into the drill shall be set into the drill shall be set into the drill shall be drill shall be set into the drill shall be drill shall be drill shall be drill shall be completed within 30 days of the spud date or the well shall be completed within 30 days of the spud date or the well shall be drill be drill be drill shall be drill shall be drill shall be drill shall be completed within 30 days of the spud date or the well shall be drill be drill shall be dril	CONSERVATION DIVISION WICHITA, KS th drilling rig; th by circulating cement to the top; in all cases surface pipe shall be set the underlying formation. istrict office on plug length and placement is necessary prior to plugging; ged or production casing is cemented in; ed from below any usable water to surface within 120 days of spud date. #133,891-C, which applies to the KCC District 3 area, alternate II cementing the plugged. In all cases, NOTIFY district office prior to any cementing. Emy knowledge and belief. Title: File Drill Pit Application (form CDP-1) with Intent to Drill; File Completion Form ACO-1 within 120 days of spud date; File acreage attribution plat according to field proration orders; Notify appropriate district office 48 hours prior to workover or re-entry; Submit plugging report (CP-4) after plugging is completed;
The undersigned hereby affirms that the drilling, completion and eventual plit is agreed that the following minimum requirements will be met: 1. Notify the appropriate district office <i>prior</i> to spudding of well; 2. A copy of the approved notice of intent to drill <i>shall be</i> posted on each and the second and the state of intent to drill <i>shall be</i> posted on each and the second	CONSERVATION DIVISION WICHITA, KS th drilling rig; th by circulating cement to the top; in all cases surface pipe shall be set the underlying formation. istrict office on plug length and placement is necessary prior to plugging; ged or production casing is cemented in; ed from below any usable water to surface within 120 days of spud date. #133,891-C, which applies to the KCC District 3 area, alternate II cementing to plugged. In all cases, NOTIFY district office prior to any cementing. Title: Remember to: File Drill Pit Application (form CDP-1) with Intent to Drill; File Completion Form ACO-1 within 120 days of spud date; File acreage attribution plat according to field proration orders; Notify appropriate district office 48 hours prior to workover or re-entry; Submit plugging report (CP-4) after plugging is completed; Obtain written approval before disposing or injecting salt water.
The undersigned hereby affirms that the drilling, completion and eventual plants agreed that the following minimum requirements will be met: 1. Notify the appropriate district office <i>prior</i> to spudding of well; 2. A copy of the approved notice of intent to drill <i>shall be</i> posted on each and the drill shall be posted on each and the drill shall be posted on each and the drill shall be set through all unconsolidated materials plus a minimum of 20 feet into the drill shall be set into the drill shall be set into the drill shall be drill shall be set into the drill shall be drill shall be drill shall be drill shall be completed within 30 days of the spud date or the well shall be completed within 30 days of the spud date or the well shall be drill be drill be drill shall be drill shall be drill shall be drill shall be completed within 30 days of the spud date or the well shall be drill be drill shall be dril	CONSERVATION DIVISION WICHITA, KS th drilling rig; th by circulating cement to the top; in all cases surface pipe shall be set the underlying formation. istrict office on plug length and placement is necessary prior to plugging; ged or production casing is cemented in; ed from below any usable water to surface within 120 days of spud date. #133,891-C, which applies to the KCC District 3 area, alternate II cementing the plugged. In all cases, NOTIFY district office prior to any cementing. Title: Remember to: File Drill Pit Application (form CDP-1) with Intent to Drill; File Completion Form ACO-1 within 120 days of spud date; File acreage attribution plat according to field proration orders; Notify appropriate district office 48 hours prior to workover or re-entry; Submit plugging report (CP-4) after plugging is completed; Obtain written approval before disposing or injecting salt water. If this permit has expired (See: authorized expiration date) please
The undersigned hereby affirms that the drilling, completion and eventual plant is agreed that the following minimum requirements will be met: 1. Notify the appropriate district office <i>prior</i> to spudding of well; 2. A copy of the approved notice of intent to drill <i>shall be</i> posted on each and the minimum amount of surface pipe as specified below <i>shall be set</i> through all unconsolidated materials plus a minimum of 20 feet into the set through all unconsolidated materials plus a minimum of 20 feet into the set of the well is dry hole, an agreement between the operator and the description of the specified before well is either plug to the specified before well is either p	CONSERVATION DIVISION WICHITA, KS the drilling rig; the underlying formation. Strict office on plug length and placement is necessary prior to plugging; ged or production casing is cemented in; ged from below any usable water to surface within 120 days of spud date. #133,891-C, which applies to the KCC District 3 area, alternate II cementing to plugged. In all cases, NOTIFY district office prior to any cementing. Title: **Title:** **File Drill Pit Application (form CDP-1) with Intent to Drill; **File acreage attribution plat according to field proration orders; **Notify appropriate district office 48 hours prior to workover or re-entry; **Submit plugging report (CP-4) after plugging is completed; **Obtain written approval before disposing or injecting salt water. **If this permit has expired (See: authorized expiration date) please check the box below and return to the address below.
The undersigned hereby affirms that the drilling, completion and eventual plant is agreed that the following minimum requirements will be met: 1. Notify the appropriate district office <i>prior</i> to spudding of well; 2. A copy of the approved notice of intent to drill <i>shall be</i> posted on each and the minimum amount of surface pipe as specified below <i>shall be set</i> through all unconsolidated materials plus a minimum of 20 feet into the set through all unconsolidated materials plus a minimum of 20 feet into the set of the well is dry hole, an agreement between the operator and the complete is either plug of the surface pipe shall be cement or pursuant to Appendix "B" - Eastern Kansas surface casing order must be completed within 30 days of the spud date or the well shall in hereby certify that the statements made herein are true and to the best of the statements of the operator or Agent: For KCC Use ONLY	CONSERVATION DIVISION WICHITA, KS the drilling rig; the underlying formation. Sisterict office on plug length and placement is necessary prior to plugging; ged or production casing is cemented in; ged from below any usable water to surface within 120 days of spud date. #133,891-C, which applies to the KCC District 3 area, alternate II cementing to plugged. In all cases, NOTIFY district office prior to any cementing. Title: File Drill Pit Application (form CDP-1) with Intent to Drill; File Completion Form ACO-1 within 120 days of spud date; File acreage attribution plat according to field proration orders; Notify appropriate district office 48 hours prior to workover or re-entry; Submit plugging report (CP-4) after plugging is completed; Obtain written approval before disposing or injecting salt water. If this permit has expired (See: authorized expiration date) please check the box below and return to the address below. Well Not Drilled - Permit Expired
The undersigned hereby affirms that the drilling, completion and eventual plant is agreed that the following minimum requirements will be met: 1. Notify the appropriate district office <i>prior</i> to spudding of well; 2. A copy of the approved notice of intent to drill <i>shall be</i> posted on each and the minimum amount of surface pipe as specified below <i>shall be set</i> through all unconsolidated materials plus a minimum of 20 feet into the set through all unconsolidated materials plus a minimum of 20 feet into the set of the well is dry hole, an agreement between the operator and the description of the set of the specified before well is either plug to the supportant to the specified before well is either plug to the support of the specified before well is either plug to the support of the specified before well is either plug to the specified before well is either plug to the support of the specified before well is either plug to the specified before well is either plug to the support of the specified before well is either plug to the specified before well is either p	CONSERVATION DIVISION WICHITA, KS the drilling rig; the underlying formation. Strict office on plug length and placement is necessary prior to plugging; ged or production casing is cemented in; ged from below any usable water to surface within 120 days of spud date. #133,891-C, which applies to the KCC District 3 area, alternate II cementing to plugged. In all cases, NOTIFY district office prior to any cementing. Title: **Title:** **File Drill Pit Application (form CDP-1) with Intent to Drill; **File acreage attribution plat according to field proration orders; **Notify appropriate district office 48 hours prior to workover or re-entry; **Submit plugging report (CP-4) after plugging is completed; **Obtain written approval before disposing or injecting salt water. **If this permit has expired (See: authorized expiration date) please check the box below and return to the address below.

IN ALL CASES PLOT THE INTENDED WELL ON THE PLAT BELOW

Plat of acreage attributable to a well in a prorated or spaced field


If the intended well is in a prorated or spaced field, please fully complete this side of the form. If the intended well is in a prorated or spaced field complete the plat below showing that the well will be properly located in relationship to other wells producing from the common source of supply. Please show all the wells and within 1 mile of the boundaries of the proposed acreage attribution unit for gas wells and within 1/2 mile of the boundaries of the proposed acreage attribution unit for oil wells.

API No. 15 - 063 - 21487 -0000	Location of Well: County: Gove
Operator: Zenith Petroleum Corporation	1320 feet from N / S Line of Section
Lease: Coberly Partnership	2631 feet from E / 🗸 W Line of Section
Well Number: 16-2 Field: Coberly West Field	Sec. 16 Twp. 14 S. R. 29 East ✓ West
Number of Acres attributable to well:	ls Section: ✓ Regular or Irregular
QTR / QTR / QTR of acreage:CN/2	If Section is irregular, locate well from nearest corner boundary. Section corner used: NE NW SE SW

PLAT

(Show location of the well and shade attributable acreage for prorated or spaced wells.) (Show footage to the nearest lease or unit boundary line.)

,						
			,			
				_		
		•				
	•	•		•	•	•
	• •					
	•	•	•		•	-
• • •	• •			' ' '		
		•			•	
	•		•	•	•	•
					•	
	•		•		•	
	•	•	•	•		
	•	•		•	•	•
			•	•	•	
			•	•	•	
			•	•	•	
			•	•	•	
	· ·	· ·		•	· · · · · · ·	
		: : 	· · ·	•	· · · · · · · · · · · · · · · · · · ·	:
				•	· · · · · · ·	:
	:			•	· · · · · · · · · · · · · · · · · · ·	:
		: : 		•	· · · · · · · · · · · · · · · · · · ·	:
			· · · · · · · · · · · · · · · · · · ·		:	· · · · · · · · · · · · · · · · · · ·
			· · · · · · · · · · · · · · · · · · ·		:	: : : :
					:	: : : :
					:	: : : :
					:	: : : :
					:	: : : :
					:	

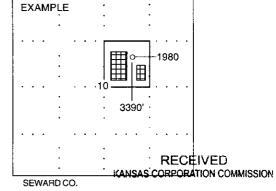

NOTE: In all cases locate the spot of the proposed drilling locaton.

OCT 0 9 2007

In plotting the proposed location of the well, you must show:

- 1. The manner in which you are using the depicted plat by identifying section lines, i.e. 1 section, 1 section with 8 surrounding sections, 4 sections, etc.
- 2. The distance of the proposed drilling location from the section's south / north and east / west.
- 3. The distance to the nearest lease or unit boundary line.
- 4. If proposed location is located within a prorated or spaced field a certificate of acreage attribution plat must be attached: (C0-7 for oil wells; CG-8 for gas wells).

CONSERVATION DIVISION WICHITA, KS



ROBINSON SERVICES

Oil Field & Construction Staking

P.O. Box 2324

Garden City, Kansas 67846 Office/Fax: (620) 276-6159

Cell: (620) 272-1499

7088 INVOICE NO.

3100307-c PLAT NO.

M. Coberly et al #16-2

LEASE NAME

Gove County, KS

16 14s 29v

1320' FNL & 2631' FWL

LOCATION SPOT

SCALE: 1" =1000'

DATE: Oct. 3rd, 2007

MEASURED BY: Kent C.

Zenith Petroleum Corporation

OPERATOR

DRAWN BY: Gabe Q.

AUTHORIZED BY: Jim B. & Jack I.

This drawing does not constitute a monumented survey or a land survey plat


This drawing is for construction purposes only

Directions: From the center of Gove, Ks at the intersection of Hwy 23 & CR 451 - Now go 7.2 miles South on Hwy 23 - Now go 3 miles West - Now go 1 mile South (approx. 90' East of the NW corner of section 16-14s-29w) - Now go 2631' East through dry land wheat stubble to ingress South into - Now go 1320' South

through dry land wheat stubble into staked location.

GR. ELEVATION: <u>2670.4</u>

Final ingress must be verified with land owner or Zenith Petroleum Corporation

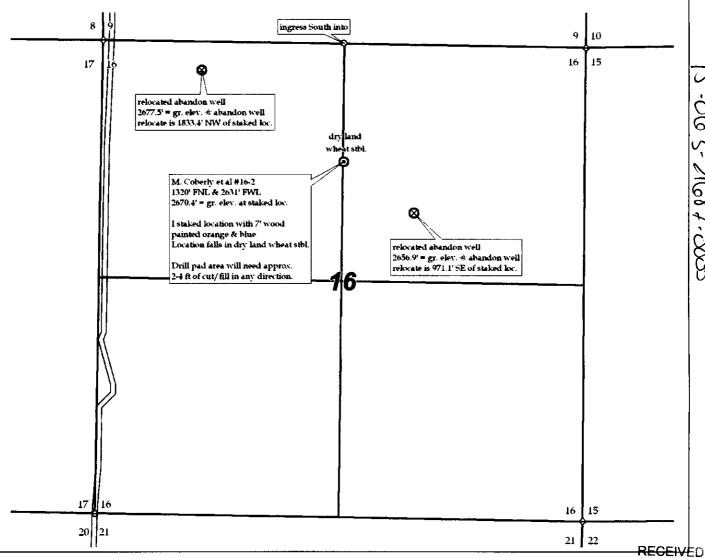

KANSAS CORPORATION COMMISSION

KANSAS CORPORATION COMMISSION OIL & GAS CONSERVATION DIVISION

Form CDP-1 April 2004 Form must be Typed

APPLICATION FOR SURFACE PIT

Submit in Duplicate

Operator Name: Zenith Petroleum (Corporation	License Number: 34015		
Operator Address: 5766 S. Ivy Stre	et Greenwoo	od Village,	CO 80111	
Contact Person: Jack Johnston		Phone Number: (303)779-1900 -		
Lease Name & Well No.: Coberly Par	tnership 16-2	Pit Location (QQQQ):		
Type of Pit:	Pit is:		CN2 E2 E2 NW	
Emergency Pit Burn Pit	Proposed Existing		Sec. 16 Twp. 14 R. 29 East West	
Settling Pit	If Existing, date constructed:		1320 Feet from 🗸 North / South Line of Section	
Workover Pit Haul-Off Pit (If WP Supply API No. or Year Drilled)	Pit capacity:		2631 Feet from East / West Line of Section	
	1200	(bbls)	Gove County	
Is the pit located in a Sensitive Ground Water	Area? ☐ Yes ✓]No	Chloride concentration: mg/l (For Emergency Pits and Settling Pits only)	
Is the bottom below ground level? Yes No	Artificial Liner?	No	How is the pit lined if a plastic liner is not used?	
Depth fi If the pit is lined give a brief description of the material, thickness and installation procedure		Describe proce	edures for periodic maintenance and determining including any special monitoring.	
Distance to nearest water well within one-mil N/A feet Depth of water well	·	Source of infor	17	
		Drilling, Workover and Haul-Off Pits ONLY:		
1		Type of materia	kover and Haul-Off Pits ONLY: rial utilized in drilling/workover: Drilling Mud - Chemical	
		rking pits to be utilized: 3		
Barrels of fluid produced daily: Aba		Abandonment	procedure: Air Dry - Back Fill	
Does the slope from the tank battery allow all spilled fluids to flow into the pit? Yes No Dril			pe closed within 365 days of spud date.	
I hereby certify that the above state	ements are true and c	correct to the bes	t of my knowledge and belief. KANSAS CORPORATION COMM	
10/8/07	(-		OCT 0 9 2007	
Date			ignature of Applicant or Agent CONSERVATION DIVISION WICHITA, KS	
	ксс	OFFICE USE O	,,,=	
Date Received: 16/4/67 Permit Num	ber:	Perm	it Date: 10/9/07 Lease Inspection: Yes 🛪 No	